

BRIDGE 6

MM 0.054 HYDE PARK


LENGTH OF ASPHALTIC PLUG JOINTS:

JOINT #1 - 38' (MM 0.045)

JOINT #2 - 38' (MM 0.063)

TOTAL = 76'

LEGEND

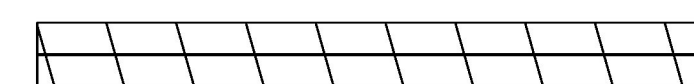

EXISTING BRIDGE JOINTS SHALL BE
REPAIRED WITH ASPHALTIC PLUG JOINT

NOT TO SCALE

PROJECT NAME:	JOHNSON - HYDE PARK
PROJECT NUMBER:	STP SURF(52)
FILE NAME: I4v204\pi4v204.dgn\pi4v204_19.f	PLOT DATE: 04-NOV-2015
PROJECT LEADER: M. FOWLER	DRAWN BY: K. LOCKE
DESIGNED BY: K. LOCKE	CHECKED BY: M. FOWLER
BRIDGE DETAIL SHEET 2	SHEET 19 OF 45