



TOWN/STATE HIGHWAY INVENTORY FOR PAVING & MARKING

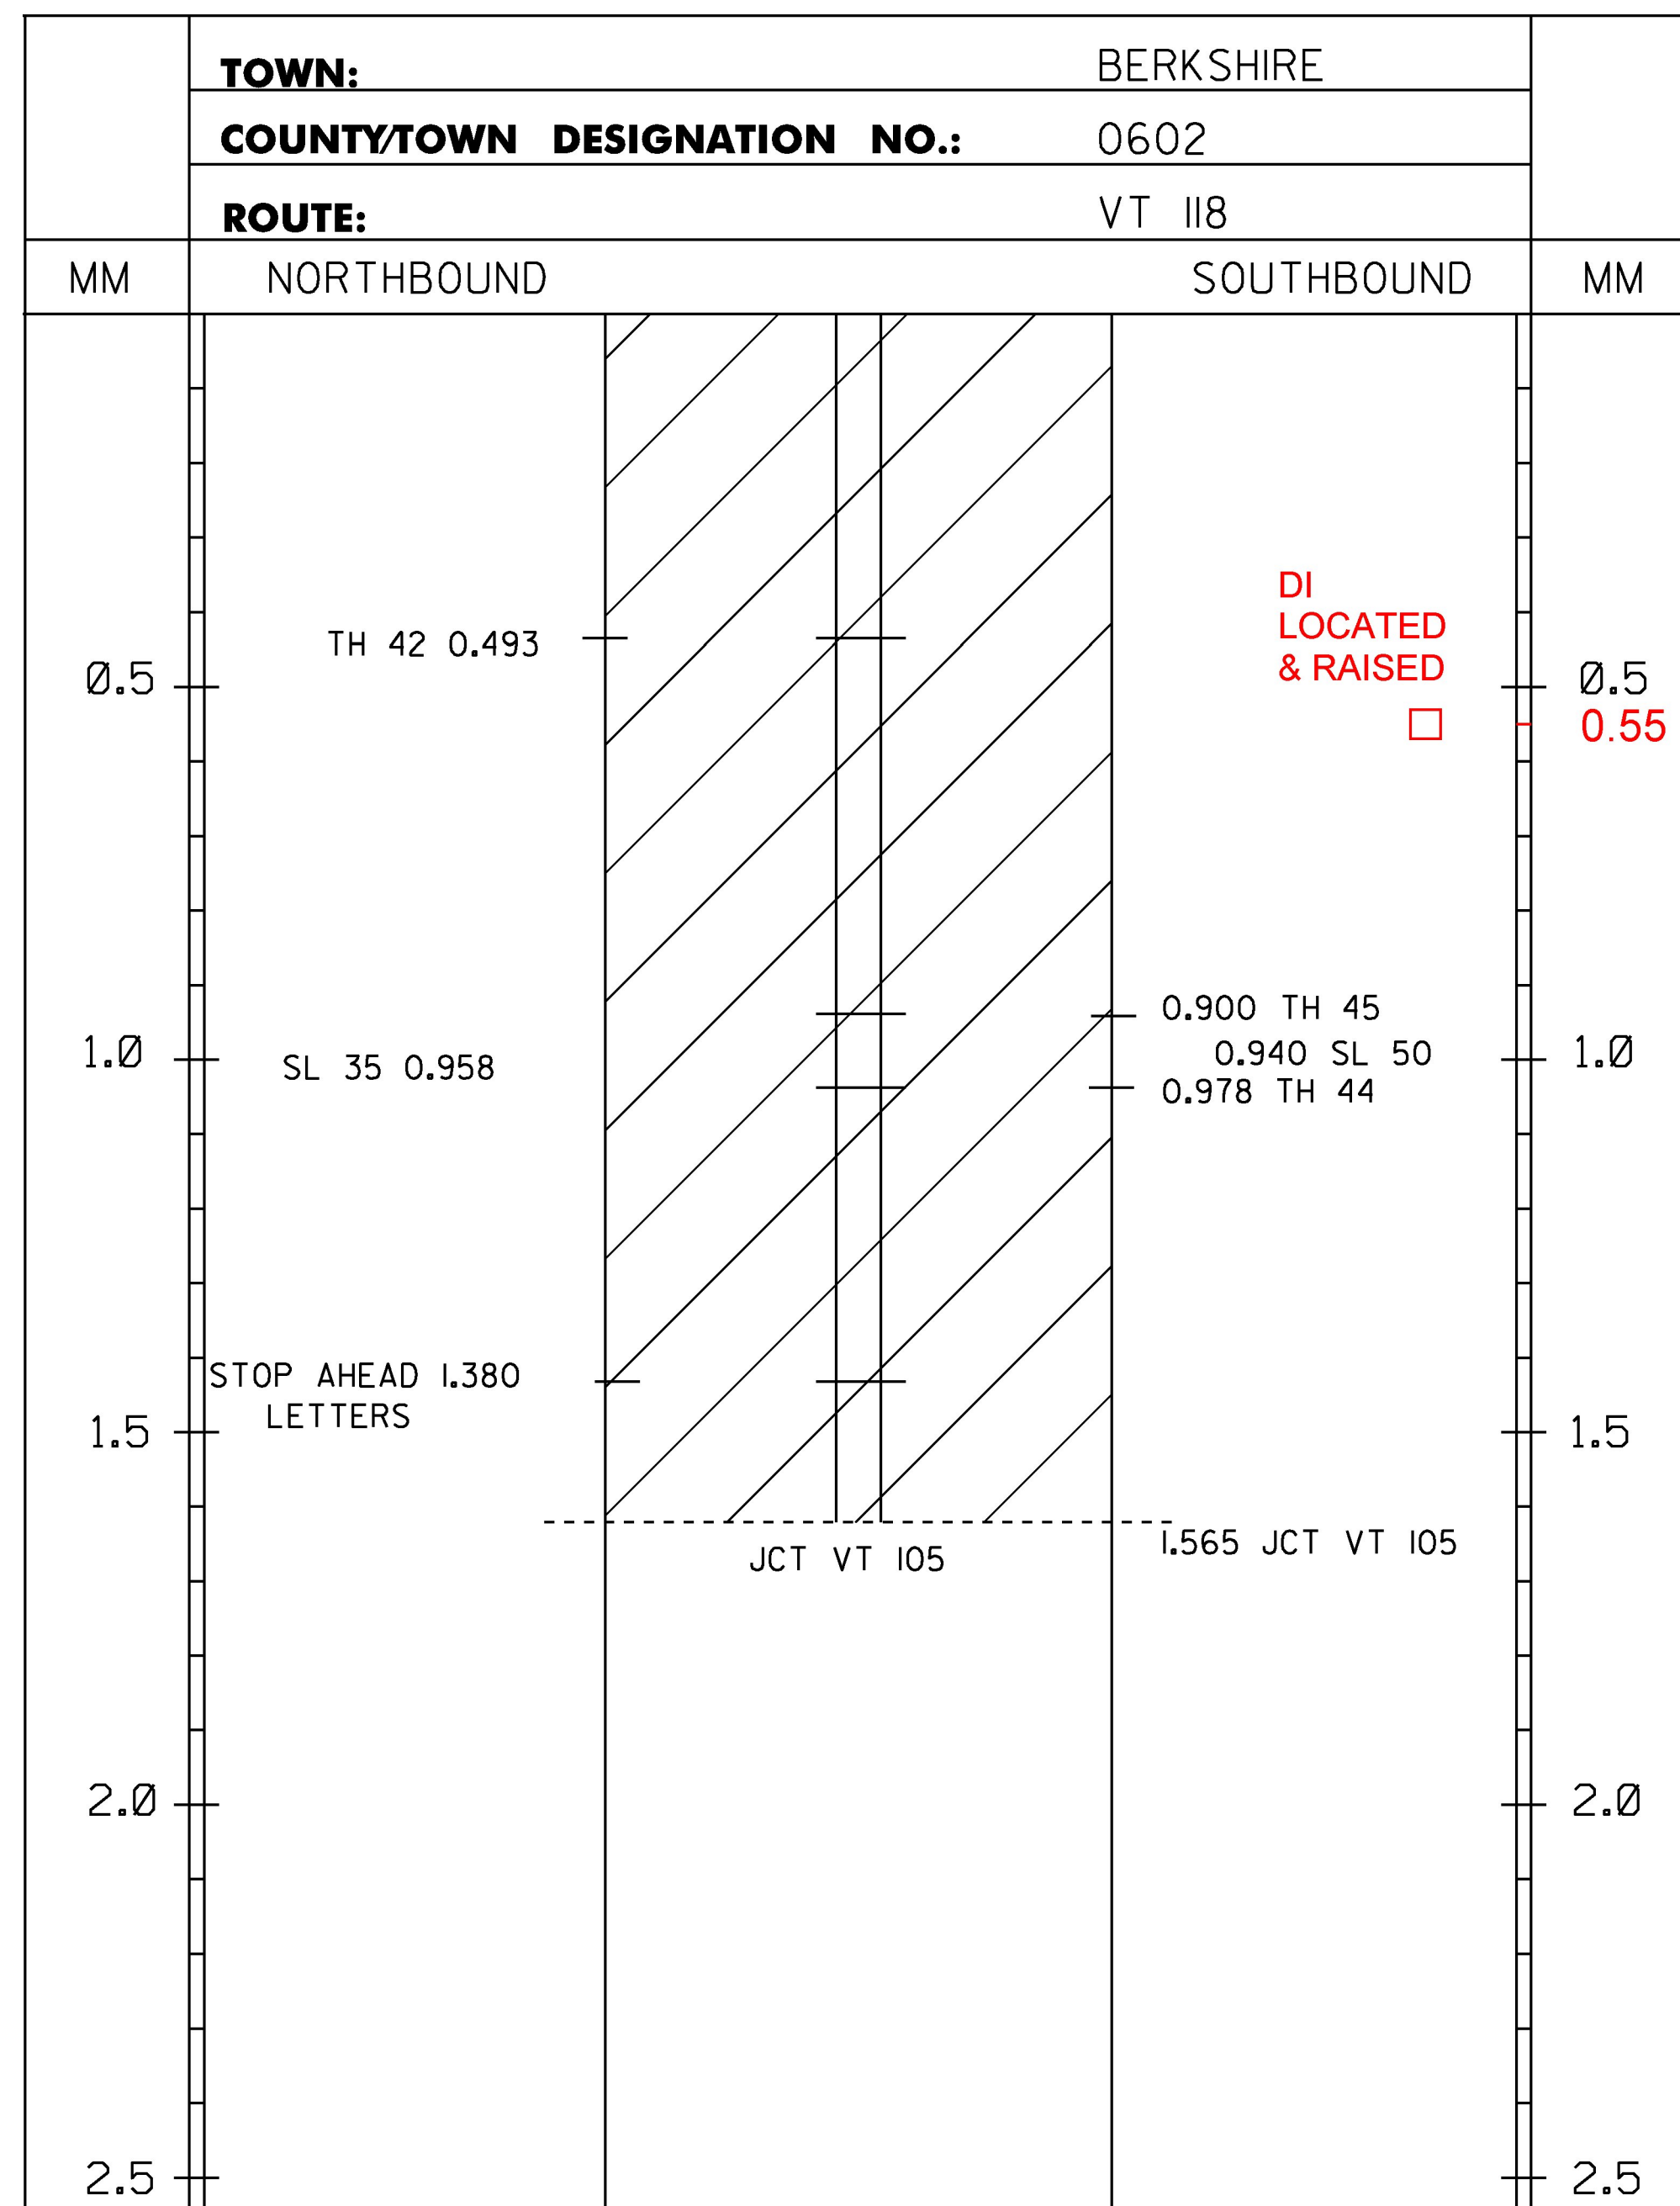

TOWN/STATE HIGHWAY NAME	LOCATION MM	MAINLINE CENTERLINE BREAK	MAINLINE EDGE LINE BREAK	TH CENTERLINE	TH EDGE LINE	TH STOP BAR	TH STOP LETTERS
MONTGOMERY							
TH 35 NUTTING RD	2.361 RT	YES	YES	YES	YES	YES	YES
TH 8 SOUTH BRANCH RD	2.810 LT	YES	YES	NO	NO	NO	NO
TH 28 REAGAN RD	2.863 RT	YES	YES	YES	YES	YES	YES
TH 34 SUNDELL RD	2.935 LT	NO	NO	NO	NO	NO	NO
TH 33 GIBOU RD	3.974 LT	YES	YES	YES	YES	YES	YES
TH 43 SOUTH BROOK RD	4.043 LT	YES	YES	NO	NO	NO	NO
TH 43 SOUTH BROOK RD	4.350 LT	YES	YES	NO	NO	NO	NO
TH 2 NOTCH RD (VT 58)	5.585 RT	YES	YES	YES	YES	YES	YES
TH 26 GRANNY GRUNTS RD	5.585 LT	YES	YES	NO	NO	NO	NO
VT 242	5.623 RT	YES	YES	-	-	-	-
TH 5 TROUT RIVER RD	5.713 LT	YES	YES	NO	NO	NO	NO
TH 5 RIVER STREET	5.882 LT	YES	YES	NO	NO	NO	NO
TH 6 SCHOOL DRIVE	6.491 RT	YES	YES	YES	YES	YES	YES
TH 13 DREAMER'S RD	5.231 RT	YES	YES	NO	YES	YES	YES
TH 41 VINCENTS BRIDGE RD	6.173 RT	NO	NO	NO	NO	NO	NO
TH 1 FULLER BRIDGE RD	8.008 RT	YES	YES	YES	YES	YES	YES
TH 39	8.065 RT	YES	YES	YES	YES	YES	YES
TH 49 DEUSO RD	8.050 RT	NO	NO	NO	NO	NO	NO
TH 42 COMSTOCK BR RD	8.104 LT	YES	YES	YES	YES	YES	YES
TH 47 BANK RD	8.249 LT	YES	YES	NO	NO	NO	NO
TH 42 COMSTOCK BR RD	8.369 LT	YES	YES	YES	YES	YES	YES
TH 12 HILL WEST RD	8.476 LT	YES	YES	YES	YES	YES	YES
TH 11 WEST HILL RD	8.528 LT	YES	YES	YES	YES	YES	YES
TH 4 LONGLEY BRIDGE RD	9.090 LT	YES	YES	YES	NO	YES	YES
ENOSBURG							
TH 17 HOPKINS BRIDGE RD	0.007 RT	YES	YES	YES	YES	YES	YES
TH 6 PRIVE HILL RD	0.482 LT	YES	YES	YES	YES	YES	YES
BERKSHIRE							
TH 42 DEMARIS RD	0.493 RT	YES	YES	YES	YES	YES	YES
TH 45 WOODARD NEIGHB	0.900 LT	YES	YES	YES	NO	YES	YES
TH 44 PERLEY RD	0.978 LT	YES	YES	YES	YES	YES	YES

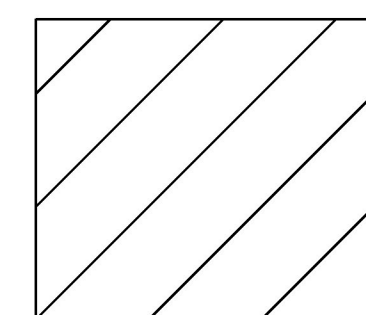

PROJECT AREA

TEMPORARY 4 INCH WHITE LINE, PAINT
SPECIAL PROVISION (DURABLE 4 INCH WHITE LINE, POLYUREA)(28 MIL)
MM 0.000 - MM 1.565 LT & RT (EDGE LINES)
(WITH BREAKS OR RADIAT TOWN HIGHWAYS)

TEMPORARY 4 INCH YELLOW LINE, PAINT
SPECIAL PROVISION (DURABLE 4 INCH YELLOW LINE, POLYUREA)(28 MIL)

MM 0.000 - MM 1.565 SOLID LT & RT
(WITH CL BREAKS AT TOWN HIGHWAYS)

TEMPORARY LETTER OR SYMBOL, PAINT
DURABLE LETTER OR SYMBOL, OPTION ITEM

MM 1.380 RT - "STOP AHEAD" (9 EACH)
MM 1.556 RT - "STOP" (4 EACH)

TEMPORARY 24 INCH STOP BAR, PAINT
DURABLE 24 INCH STOP BAR, OPTION ITEM

MM 1.556 RT

CHANGING ELEVATION OF DI, CB OR MH
MM 0.010 LT (DI)

LEGEND

- TWBH-THROUGHWAY BEGINS HERE
- TWEH-THROUGHWAY ENDS HERE
- SHB-STATE HIGHWAY BEGINS
- SHE-STATE HIGHWAY ENDS
- SL-SPEED LIMIT
- SA - STATE AID TOWN HIGHWAY
- T/L-TOWN LINE
- C/3 - CLASS 3 TOWN HIGHWAY
- C/4 - CLASS 4 TOWN HIGHWAY

NOTES:

1. THIS SHEET TO BE USED FOR THE LAYOUT OF ALL CENTERLINE PAVEMENT MARKINGS. THE ENGINEER MAY CONTACT KEITH SWEET, PAVEMENT MARKING SUPERVISOR AT (802) 828-5573 FOR ASSISTANCE LAYING OUT THE CENTERLINE DURING CONSTRUCTION.

NOT TO SCALE

PROJECT NAME: BELVIDERE - BERKSHIRE
PROJECT NUMBER: STP SURF(53)

FILE NAME: I4v204\p14v204.dgn\p14v204_31.l PLOT DATE: 04-NOV-2015
PROJECT LEADER: M. FOWLER DRAWN BY: K. LOCKE
DESIGNED BY: K. LOCKE CHECKED BY: M. FOWLER
CENTERLINE MARKING LAYOUT SHEET 5 SHEET 31 OF 45