


BRIDGE MICRO-MILL DETAIL
BRIDGE II M.M. 2.260 MONTGOMERY

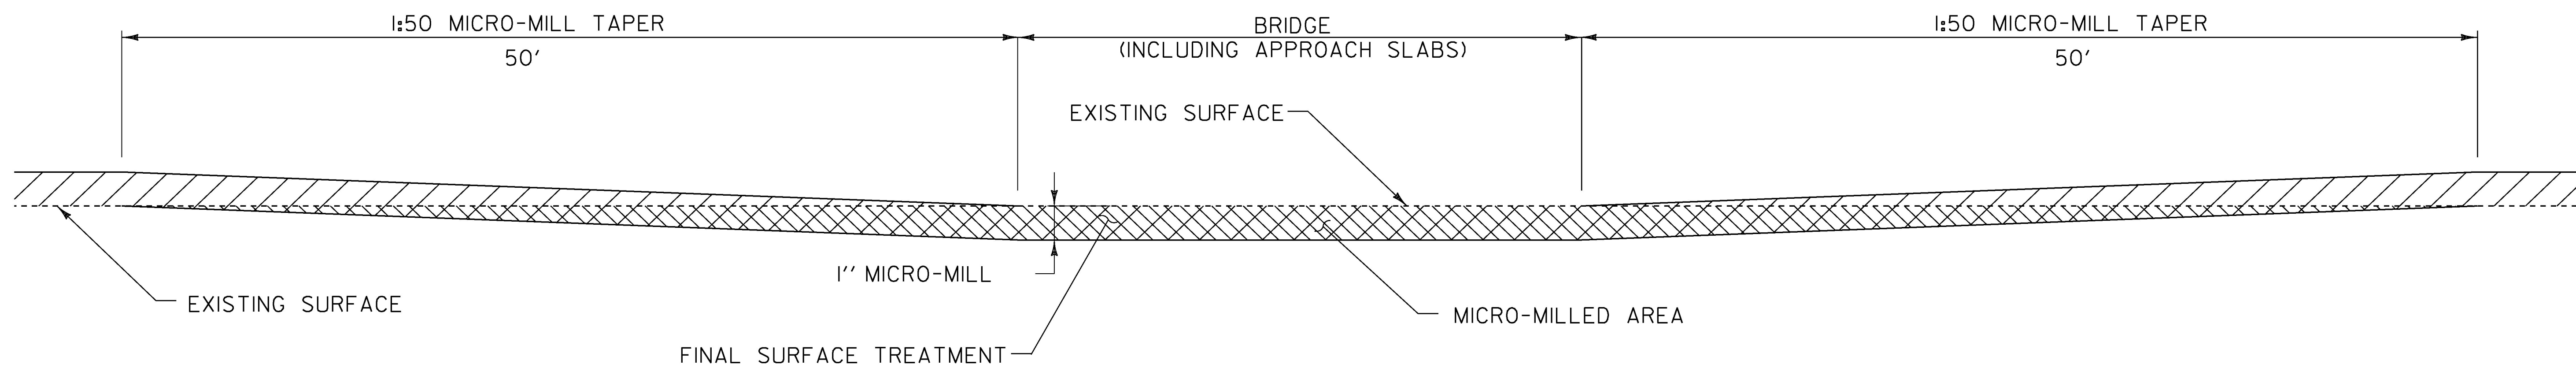

BRIDGE MICRO-MILL DETAIL
BRIDGE 12 M.M. 2.974 MONTGOMERY

NOTES:

1. REFER TO ASPHALTIC PLUG JOINT DETAIL SHEET, SD-516.10. ALL NEW JOINTS WILL BE PAID FOR UNDER ITEM 516.10, "BRIDGE EXPANSION JOINT, ASPHALTIC PLUG."
2. THE CONTRACTOR SHALL TAKE PRECAUTIONS TO AVOID DAMAGING DRAINAGE STRUCTURES AND EXPANSION JOINTS. ANY DAMAGE CAUSED BY THE CONTRACTOR SHALL BE REPAIRED BY THE CONTRACTOR AT THE SOLE EXPENSE OF THE CONTRACTOR.
3. THE CONTRACTOR SHALL TAKE PRECAUTIONS TO AVOID THE ACCUMULATION OF DEBRIS IN THE DRAINAGE STRUCTURES LOCATED AT CURB LINE AND IN THE EXPANSION JOINTS. THE CONTRACTOR SHALL EXAMINE THESE BRIDGE FEATURES ON A DAILY BASIS TO ENSURE THAT DEBRIS HAS NOT ACCUMULATED. ANY DEBRIS WHICH IS PRESENT SHALL BE REMOVED BY THE CONTRACTOR AT NO COST TO THE STATE.
4. THE CONTRACTOR SHALL USE CAUTION WHEN MICRO-MILLING AND PAVING OPERATIONS OCCUR ON BRIDGE DECKS. SHOULD ANY DAMAGE OCCUR TO THE DECK OR MEMBRANE AS A RESULT OF THESE OPERATIONS THE ENGINEER SHALL CONTACT THE VTRANS CONSTRUCTION STRUCTURES ENGINEER TO PROVIDE AN ASSESSMENT OF THE DAMAGE AND RECOMMEND ANY NECESSARY REPAIRS. THE CONSTRUCTION STRUCTURES ENGINEER WILL ALSO DETERMINE IF THE DAMAGE WAS AVOIDABLE. IF THE CONTRACTOR IS DETERMINED BY THE CONSTRUCTION STRUCTURES ENGINEER TO BE AT FAULT FOR THE DAMAGE, THE RECOMMENDED REPAIRS SHALL BE COMPLETED BY THE CONTRACTOR AT NO COST TO THE STATE.

REVISION	DATE	DESCRIPTION	BY
△	01-27-16	CHANGED MICRO-MILL DEPTH TO 1" FROM 3/4". CHANGED MICRO-MILL TAPER LENGTHS.	KML

NOT TO SCALE

PROJECT NAME:	BELVIDERE - BERKSHIRE
PROJECT NUMBER:	STP SURF(53)
FILE NAME:	I4v204\pi4v204.dgn\pi4v204_36.1
PLOT DATE:	26-JAN-2016
PROJECT LEADER:	M. FOWLER
DRAWN BY:	K. LOCKE
DESIGNED BY:	K. LOCKE
CHECKED BY:	M. FOWLER
BRIDGE DETAIL SHEET 1	SHEET 36 OF 45