


↑
NORTHBOUND
DIRECTION OF TRAVEL

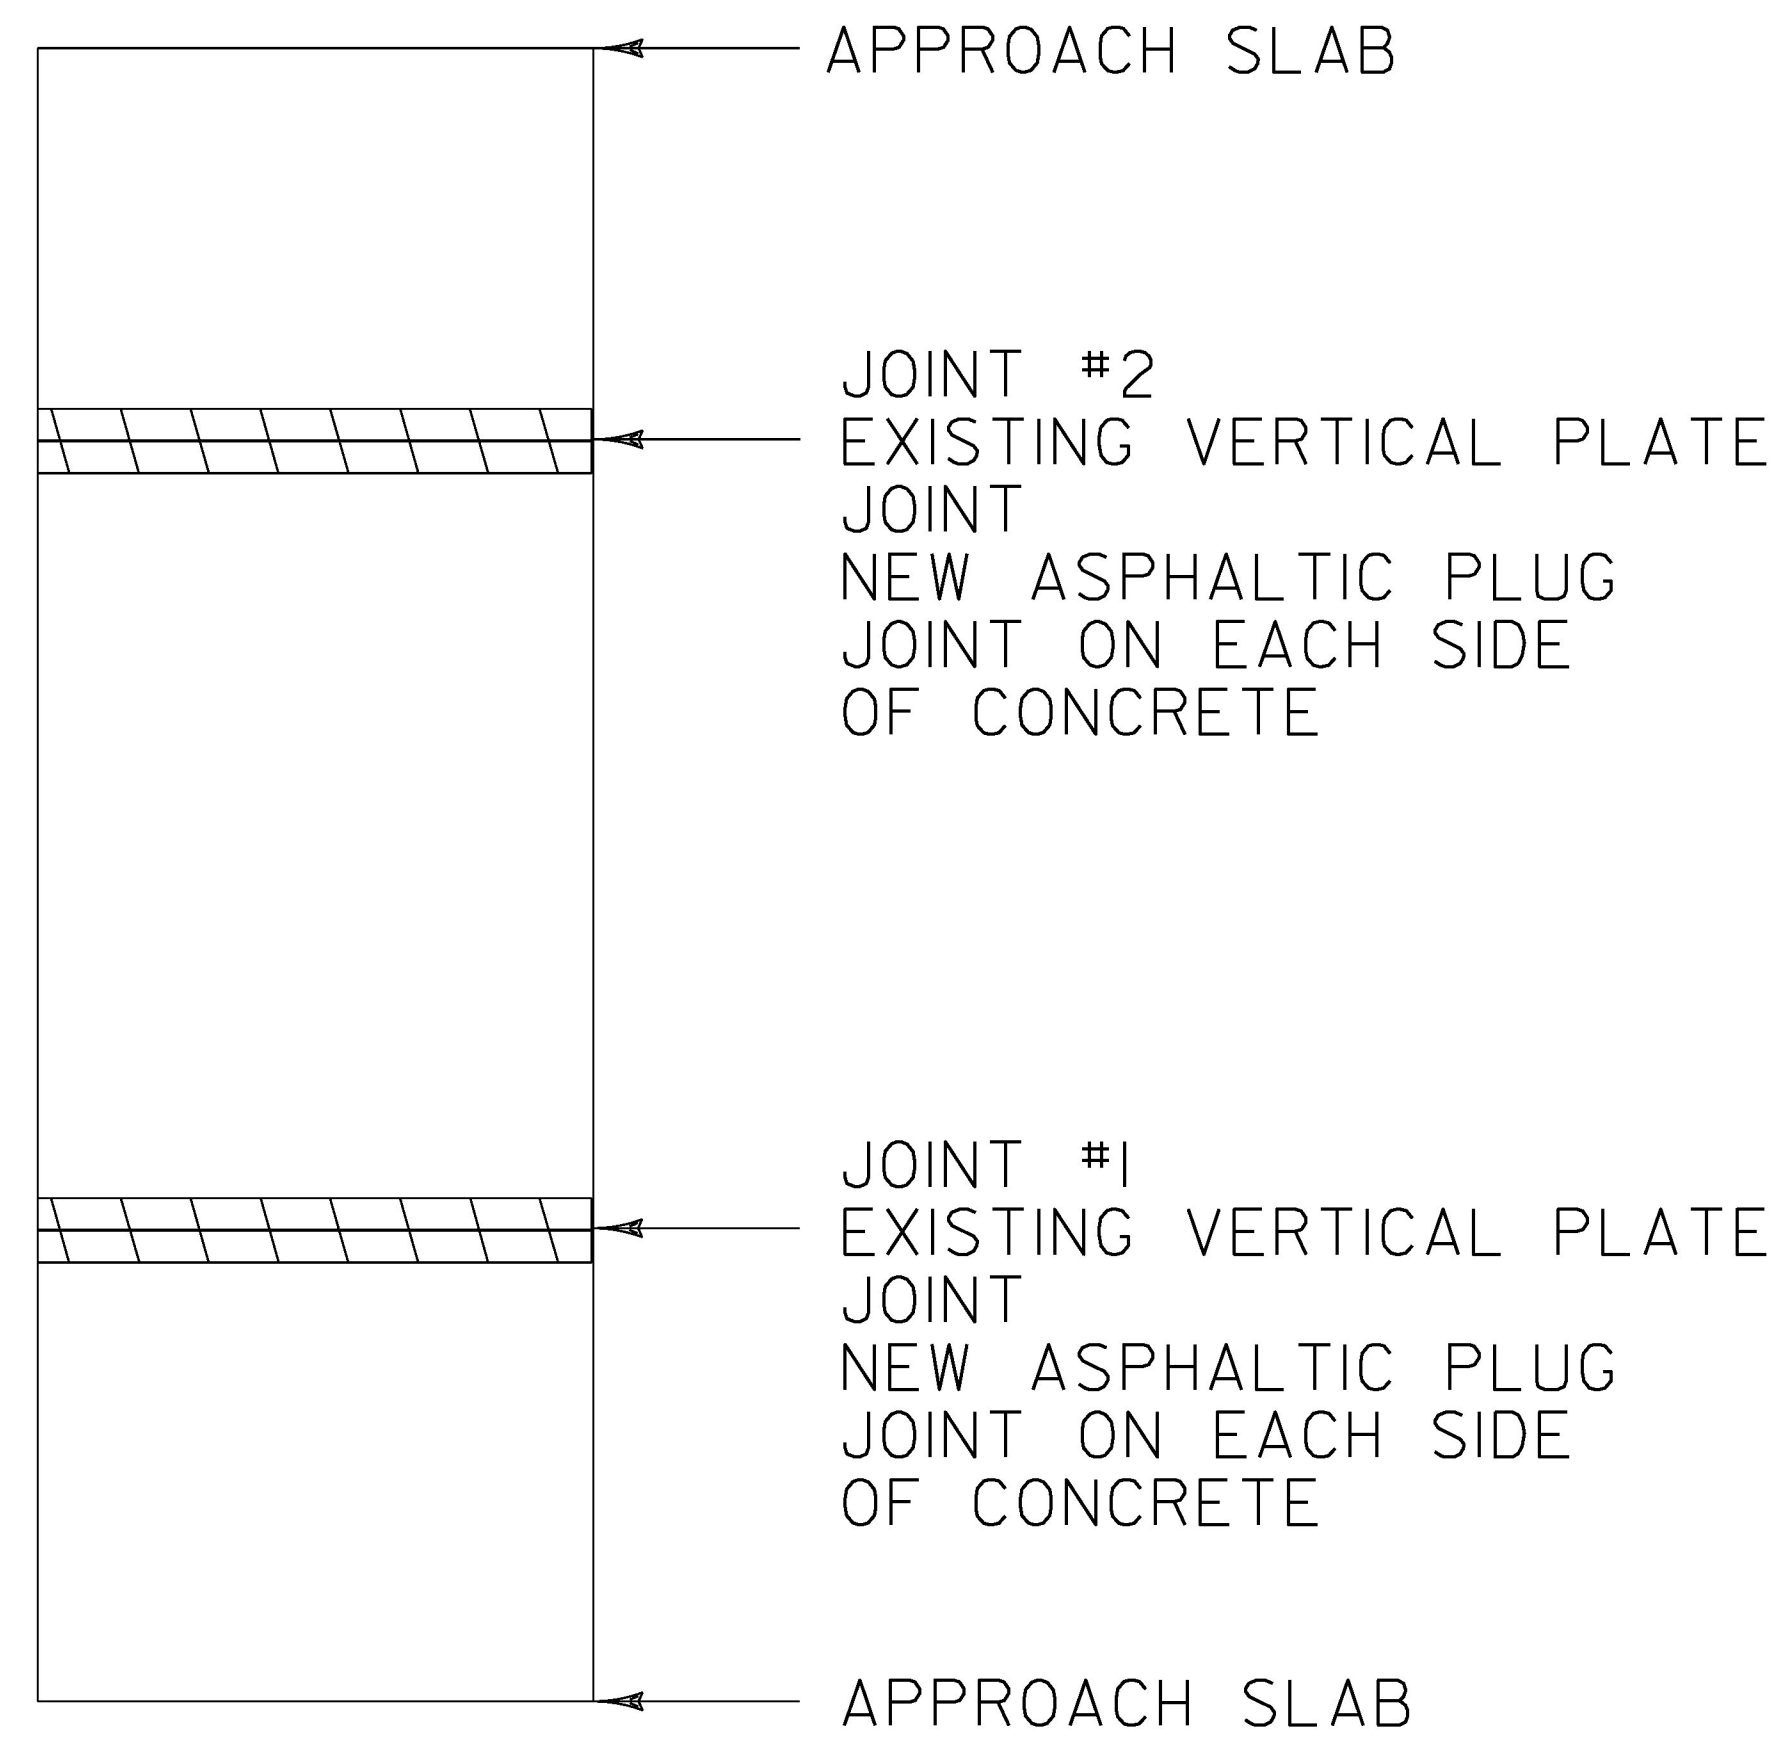


BRIDGE 30

MM 1.507 BERKSHIRE

LENGTH OF ASPHALTIC PLUG JOINTS:
 JOINT #1 - 30' X 2 = 60' (MM 1.481)
 JOINT #2 - 30' X 2 = 60' (MM 1.536)
 TOTAL = 120'

LEGEND

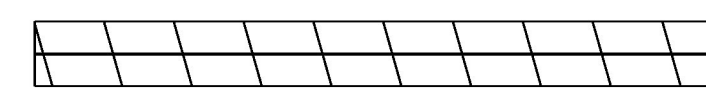

EXISTING BRIDGE JOINTS SHALL BE
 REPAIRED WITH ASPHALTIC PLUG JOINT

NOT TO SCALE

PROJECT NAME:	BELVIDERE - BERKSHIRE
PROJECT NUMBER:	STP SURF(53)
FILE NAME: I4v204\pi4v204.dgn\pi4v204_40.I	PLOT DATE: 04-NOV-2015
PROJECT LEADER: M. FOWLER	DRAWN BY: K. LOCKE
DESIGNED BY: K. LOCKE	CHECKED BY: M. FOWLER
BRIDGE DETAIL SHEET 5	SHEET 40 OF 45