


DURABLE 4 INCH WHITE LINE, (SEE OPTION ITEMS) &
 TEMPORARY 4 INCH WHITE LINE, PAINT
 (ALL LINES WILL INCLUDE EDGE LINE BREAKS AND
 RADII FOR SIDE ROADS)
 STA. 11+25 - STA. 16+75 (SOLID LT & RT)

DURABLE 4 INCH YELLOW LINE, (SEE OPTION ITEMS) &
 TEMPORARY 4 INCH YELLOW LINE, PAINT
 (ALL LINES WILL INCLUDE CENTERLINE BREAKS FOR SIDE ROADS)
 STA. 11+25 - STA. 16+75 (SOLID LT & RT)
 (WITH CENTERLINE BREAKS AT TH#85)

REMOVING SIGNS
 AS SHOWN - 2

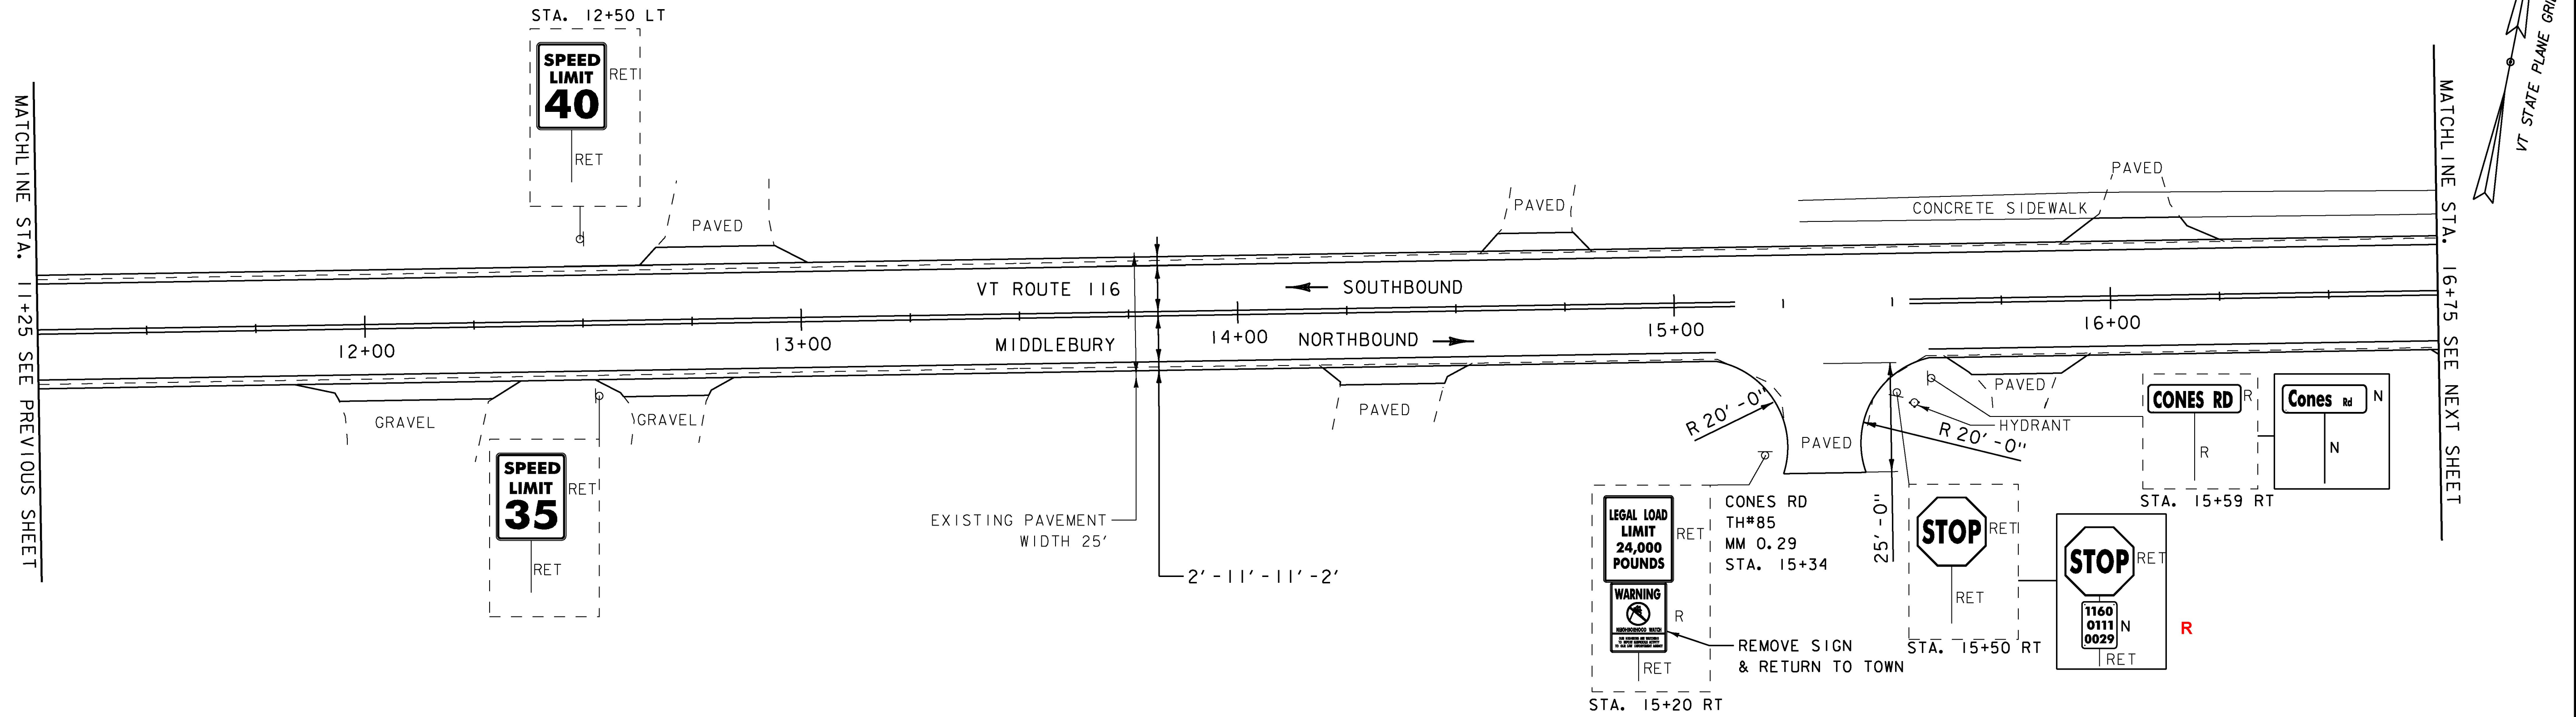

COMMON EXCAVATION
 STA. 21+15 - STA. 21+25 LT

DETECTABLE WARNING SURFACE
 STA. 21+21 (8 SF) (CAST IRON)

DURABLE 24 INCH STOP BAR, (SEE OPTION ITEMS) &
 TEMPORARY 24 INCH STOP BAR, PAINT
 STA. 21+28 - STA. 21+44 LT

DURABLE CROSSWALK MARKING (SEE OPTION ITEMS) &
 TEMPORARY CROSSWALK MARKING, PAINT
 STA. 21+24 - STA. 21+50 LT


SUBBASE OF CRUSHED GRAVEL, FINE GRADED
 STA. 21+15 - STA. 21+25 LT

DURABLE 4 INCH WHITE LINE, (SEE OPTION ITEMS) &
 TEMPORARY 4 INCH WHITE LINE, PAINT
 (ALL LINES WILL INCLUDE EDGE LINE BREAKS AND
 RADII FOR SIDE ROADS)
 STA. 16+75 - STA. 21+50 (SOLID LT & RT)


DURABLE LETTERS OR SYMBOLS, (SEE OPTION ITEMS) &
 TEMPORARY LETTERS OR SYMBOLS, PAINT
 STA. 21+38 LT (STOP)

PORTLAND CEMENT CONCRETE SIDEWALK, 5 INCH
 STA. 21+15 - STA. 21+25 LT


DURABLE 4 INCH YELLOW LINE, (SEE OPTION ITEMS) &
 TEMPORARY 4 INCH YELLOW LINE, PAINT
 (ALL LINES WILL INCLUDE CENTERLINE BREAKS FOR SIDE ROADS)
 STA. 16+75 - STA. 21+50 (SOLID LT & RT)

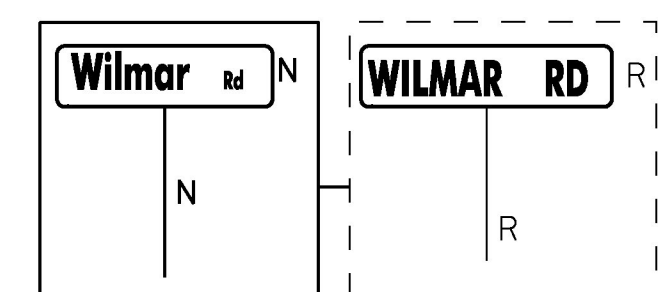


REMOVE AND RECONSTRUCT SIDEWALK RAMP
 TYPE I, EXAMPLE I. FROM STANDARD
 DRAWING C-3A

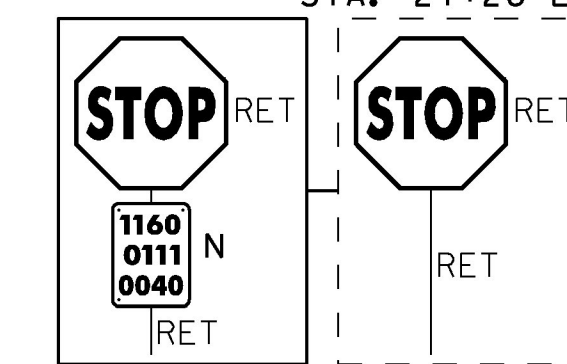

WILMAR RD
 TH#42
 MM 0.41
 STA. 21+89

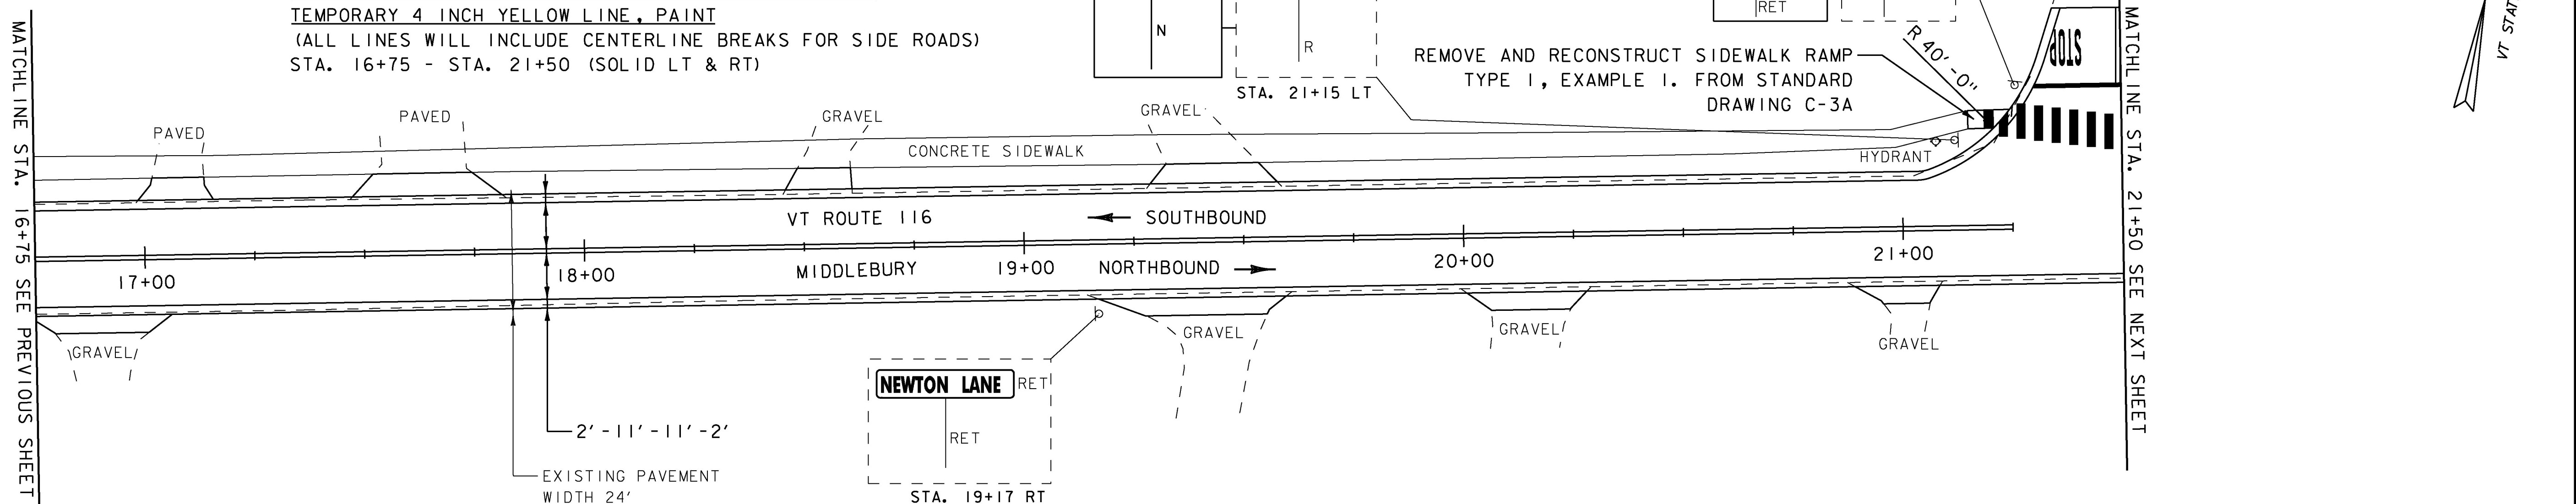

SIGN LEGEND
 R = REMOVE
 R&S = REMOVE AND SALVAGE
 RET = RETAIN
 S = SALVAGED
 N = NEW
 B-B = BACK TO BACK
 - - = EXISTING
 — = NEW

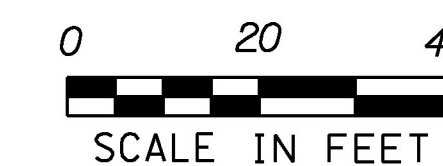

PROJECT NAME: MIDDLEBURY-STARKSBORO
 PROJECT NUMBER: STP 2953(I)

FILE NAME: z14V227bdr.dgn
 PROJECT LEADER: C.LATHROP
 DESIGNED BY: J. GOODALL
 PLAN SHEET 2

PLOT DATE: 5/4/2017
 DRAWN BY: J. GOODALL
 CHECKED BY: C.LATHROP
 SHEET 28 OF 186