

COMMON EXCAVATION
 STA. 21+68 - STA. 22+25 LT
 STA. 22+56 - STA. 22+69 LT

SUBBASE OF CRUSHED GRAVEL, FINE GRADED
 STA. 21+68 - STA. 22+25 LT
 STA. 22+56 - STA. 22+69 LT

VERTICAL GRANITE CURB
 STA. 21+68 - STA. 22+25 LT

PORTLAND CEMENT CONCRETE SIDEWALK, 5 INCH
 STA. 21+68 - STA. 22+25 LT
 STA. 22+56 - STA. 22+69 LT

DETECTABLE WARNING SURFACE
 STA. 21+76 (6 SF) (CAST IRON)




DURABLE 4 INCH WHITE LINE, (SEE OPTION ITEMS) & TEMPORARY 4 INCH WHITE LINE, PAINT
 (ALL LINES WILL INCLUDE EDGE LINE BREAKS AND RADII FOR SIDE ROADS)
 STA. 21+50 - STA. 27+25 (SOLID LT & RT)
 STA. 21+78 - STA. 21+98 LT (PERPENDICULAR PARKING LT)
 STA. 21+92 - STA. 22+41 LT (ANGLE PARKING LT)

DURABLE 4 INCH YELLOW LINE, (SEE OPTION ITEMS) & TEMPORARY 4 INCH YELLOW LINE, PAINT
 (ALL LINES WILL INCLUDE CENTERLINE BREAKS FOR SIDE ROADS)
 STA. 21+50 - STA. 26+84 (SOLID LT & RT)

DURABLE CROSSWALK MARKING (SEE OPTION ITEMS) & TEMPORARY CROSSWALK MARKING, PAINT
 STA. 21+50 - STA. 22+57 LT

REMOVING SIGNS
 AS SHOWN - 3

ERECTING SALVAGED SIGNS
 AS SHOWN - 2

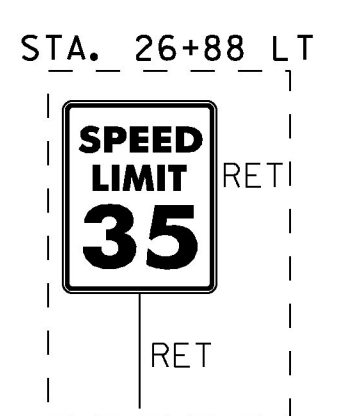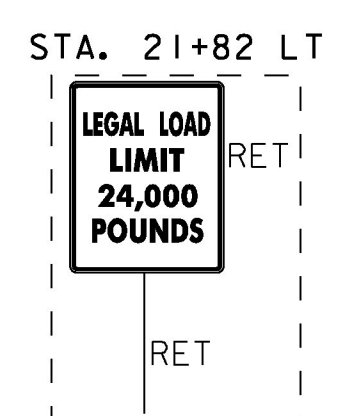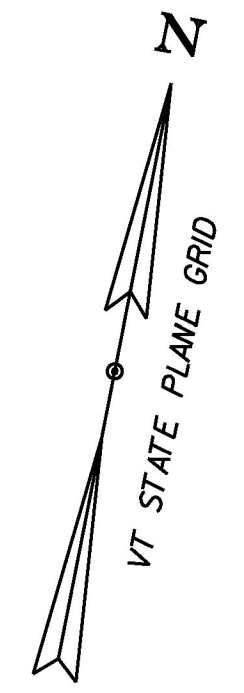

* PARKING LOT LINE STRIPING
 WORK TO BE DONE BY OTHERS



~~NEW SIDEWALK RAMP TYPE 1, EXAMPLE 1. FROM STANDARD DRAWING C-3A.~~

REMOVE AND RECONSTRUCT SIDEWALK RAMP TYPE 1, EXAMPLE 1. FROM STANDARD DRAWING C-3A. REALIGN SIDEWALK RAMP TO BE IN LINE WITH NEW SIDEWALK.

EXISTING PAVEMENT WIDTH 25'

MATCHLINE STA. 27+25 SEE NEXT SHEET


MATCHLINE STA. 21+50 SEE PREVIOUS SHEET

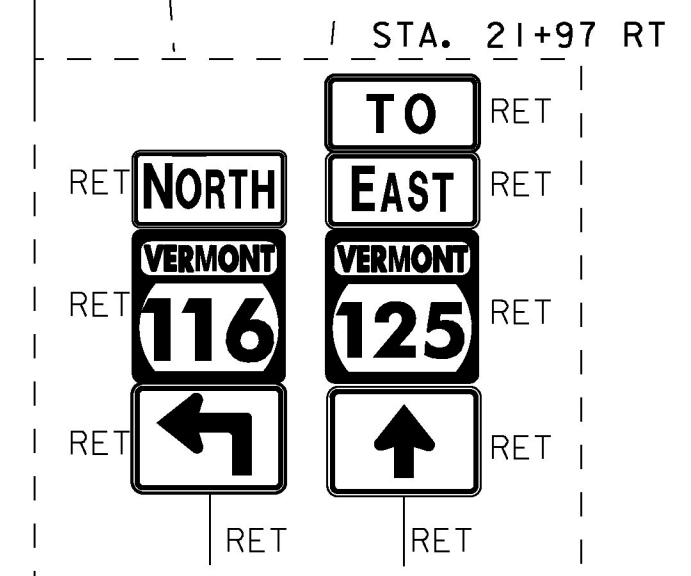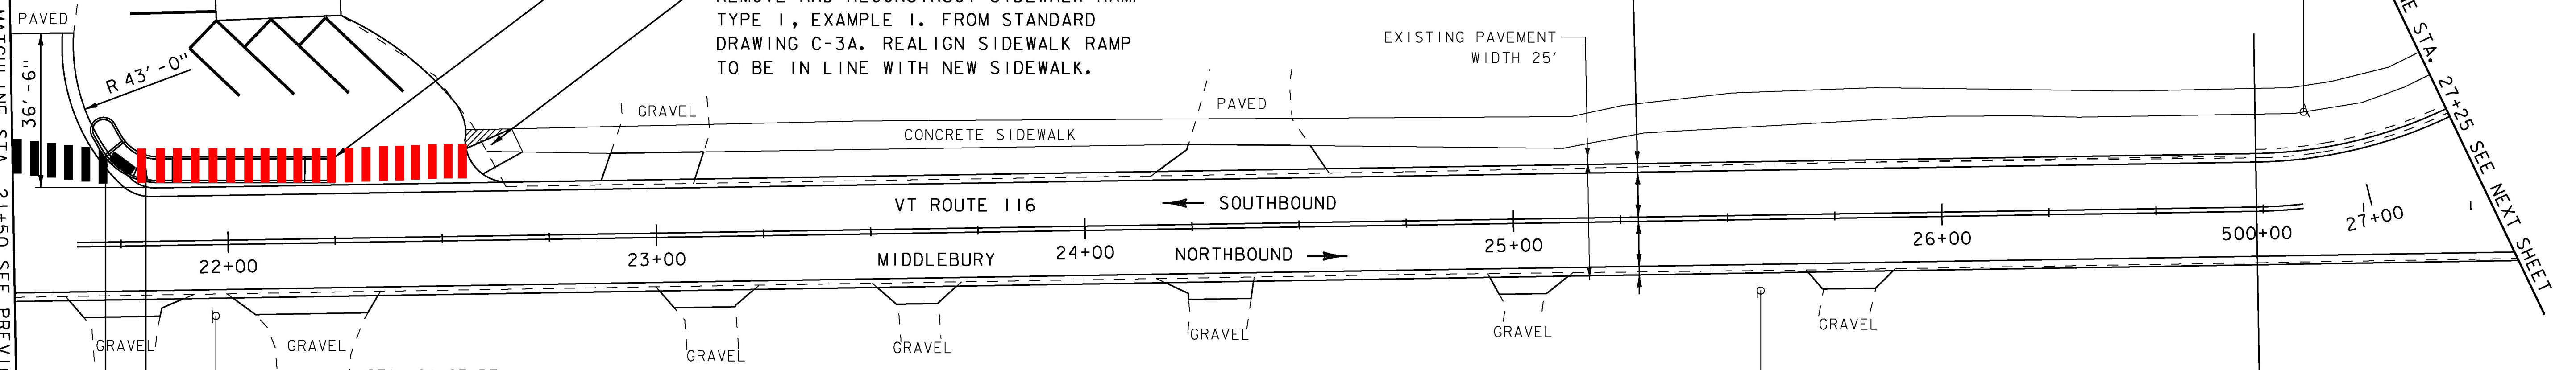


~~NEW SIDEWALK RAMP TYPE 6, EXAMPLE 2. FROM STANDARD DRAWING C-3B.~~

~~NEW MEDIUM ISLAND CUT THROUGH, FROM STANDARD DRAWING C-3B.~~

SIGN LEGEND
 R = REMOVE
 R&S = REMOVE AND SALVAGE
 RET = RETAIN
 S = SALVAGED
 N = NEW
 B-B = BACK TO BACK
 — = EXISTING
 — = NEW

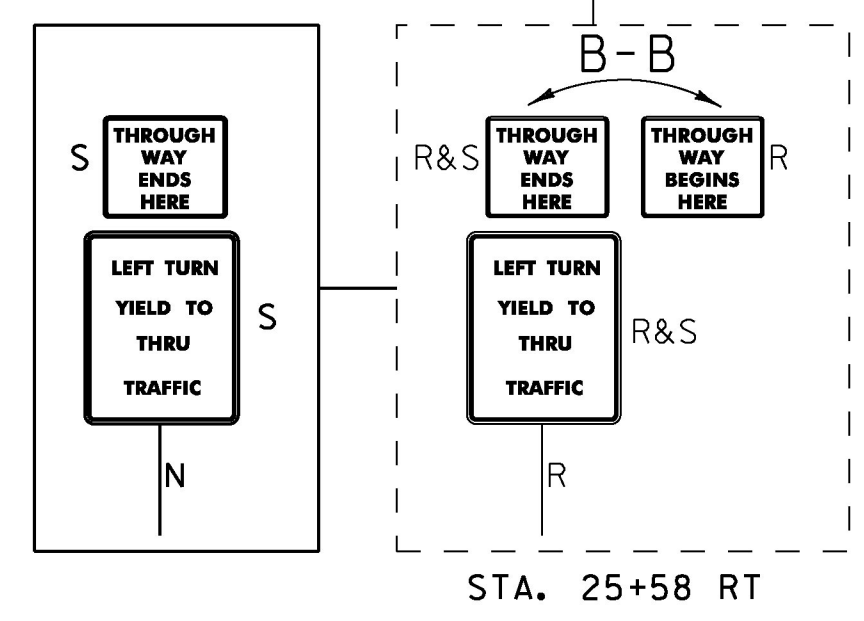

MIDDLEBURY STA. 27+43
 MIDDLEBURY STA. 500+00

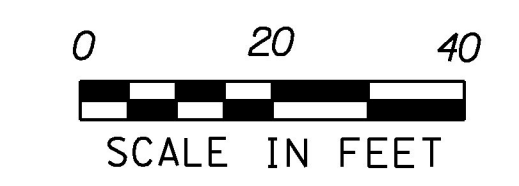

PROJECT NAME:	MIDDLEBURY-STARKSBORO
PROJECT NUMBER:	STP 2953(I)
FILE NAME:	z14V227bdr.dgn
PROJECT LEADER:	C.LATHROP
DESIGNED BY:	J. GOODALL
PLAN SHEET 3	
PLOT DATE:	5/4/2017
DRAWN BY:	J. GOODALL
CHECKED BY:	C.LATHROP
SHEET	29 OF 186