


DURABLE 4 INCH WHITE LINE, (SEE OPTION ITEMS) & TEMPORARY 4 INCH WHITE LINE, PAINT
 (ALL LINES WILL INCLUDE EDGE LINE BREAKS AND RADII FOR SIDE ROADS)
 STA. 32+25 - STA. 37+75 (SOLID LT & RT)



DURABLE 4 INCH YELLOW LINE, (SEE OPTION ITEMS) & TEMPORARY 4 INCH YELLOW LINE, PAINT
 (ALL LINES WILL INCLUDE CENTERLINE BREAKS FOR SIDE ROADS)
 STA. 32+25 - STA. 37+75 (SOLID LT & RT)

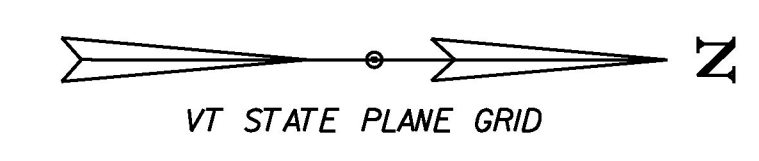

DURABLE 4 INCH WHITE LINE, (SEE OPTION ITEMS) & TEMPORARY 4 INCH WHITE LINE, PAINT
 (ALL LINES WILL INCLUDE EDGE LINE BREAKS AND RADII FOR SIDE ROADS)
 STA. 37+75 - STA. 42+75 (SOLID LT & RT)

DURABLE LETTERS OR SYMBOLS, (SEE OPTION ITEMS) & TEMPORARY LETTERS OR SYMBOLS, PAINT
 STA. 37+84 LT (AHEAD)
 STA. 38+16 LT (STOP)

DURABLE 4 INCH YELLOW LINE, (SEE OPTION ITEMS) & TEMPORARY 4 INCH YELLOW LINE, PAINT
 (ALL LINES WILL INCLUDE CENTERLINE BREAKS FOR SIDE ROADS)
 STA. 37+75 - STA. 42+75 (SOLID LT & RT)

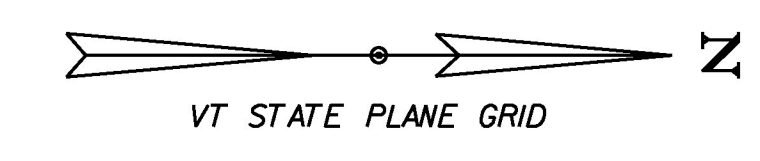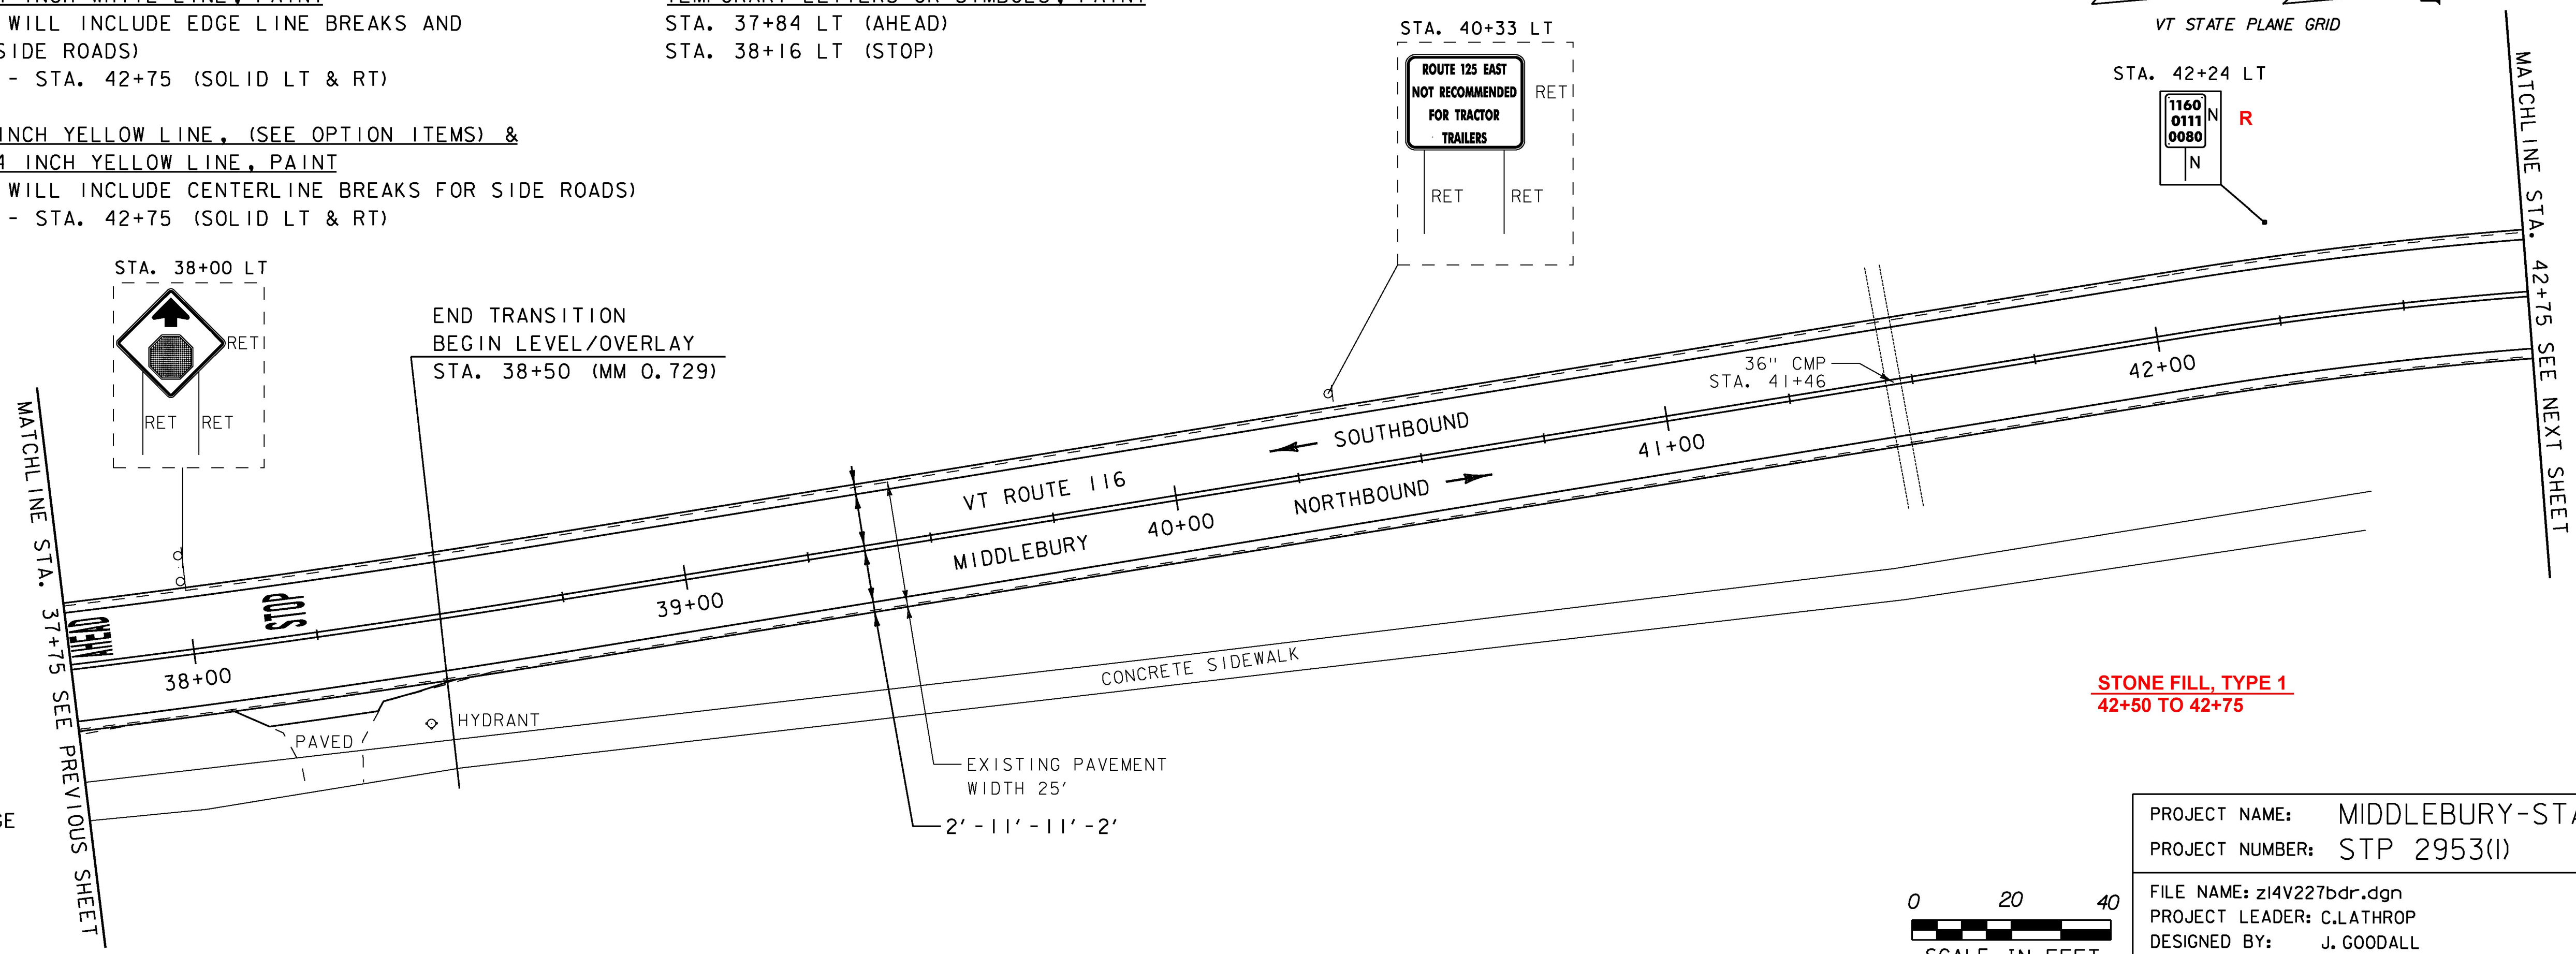

- SIGN LEGEND**
- R = REMOVE
 - R&S = REMOVE AND SALVAGE
 - RET = RETAIN
 - S = SALVAGED
 - N = NEW
 - B-B = BACK TO BACK
 - - = EXISTING
 - = NEW



PROJECT NAME:	MIDDLEBURY-STARKSBORO	PLOT DATE:	5/4/2017
PROJECT NUMBER:	STP 2953(I)	DRAWN BY:	J. GOODALL
FILE NAME:	z14V227bdr.dgn	CHECKED BY:	C.LATHROP
DESIGNED BY:	J. GOODALL	PLAN SHEET 6	SHEET 32 OF 186