

DURABLE 4 INCH WHITE LINE, (SEE OPTION ITEMS) &  
 TEMPORARY 4 INCH WHITE LINE, PAINT  
 (ALL LINES WILL INCLUDE EDGE LINE BREAKS AND  
 RADII FOR SIDE ROADS)  
 STA. 212+25 - STA. 217+25 (SOLID LT & RT)



DURABLE 4 INCH YELLOW LINE, (SEE OPTION ITEMS) &  
 TEMPORARY 4 INCH YELLOW LINE, PAINT  
 (ALL LINES WILL INCLUDE CENTERLINE BREAKS FOR SIDE ROADS)  
 STA. 212+25 - STA. 215+80 (DASHED LT, SOLID RT)  
 STA. 215+80 - STA. 217+25 (SOLID LT & RT)

DURABLE 24 INCH STOP BAR, (SEE OPTION ITEMS) &  
 TEMPORARY 24 INCH STOP BAR, PAINT  
 STA. 216+00 - STA. 216+45 LT

DURABLE LETTERS OR SYMBOLS, (SEE OPTION ITEMS) &  
 TEMPORARY LETTERS OR SYMBOLS, PAINT  
 STA. 216+29 LT (STOP)

REMOVING SIGNS  
 AS SHOWN - I



MATCHLINE STA. 212+25 SEE PREVIOUS SHEET

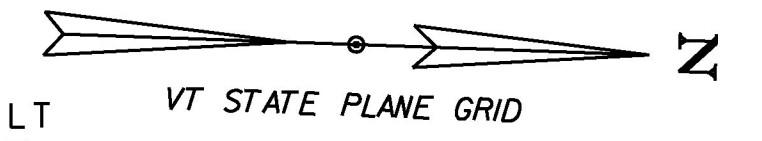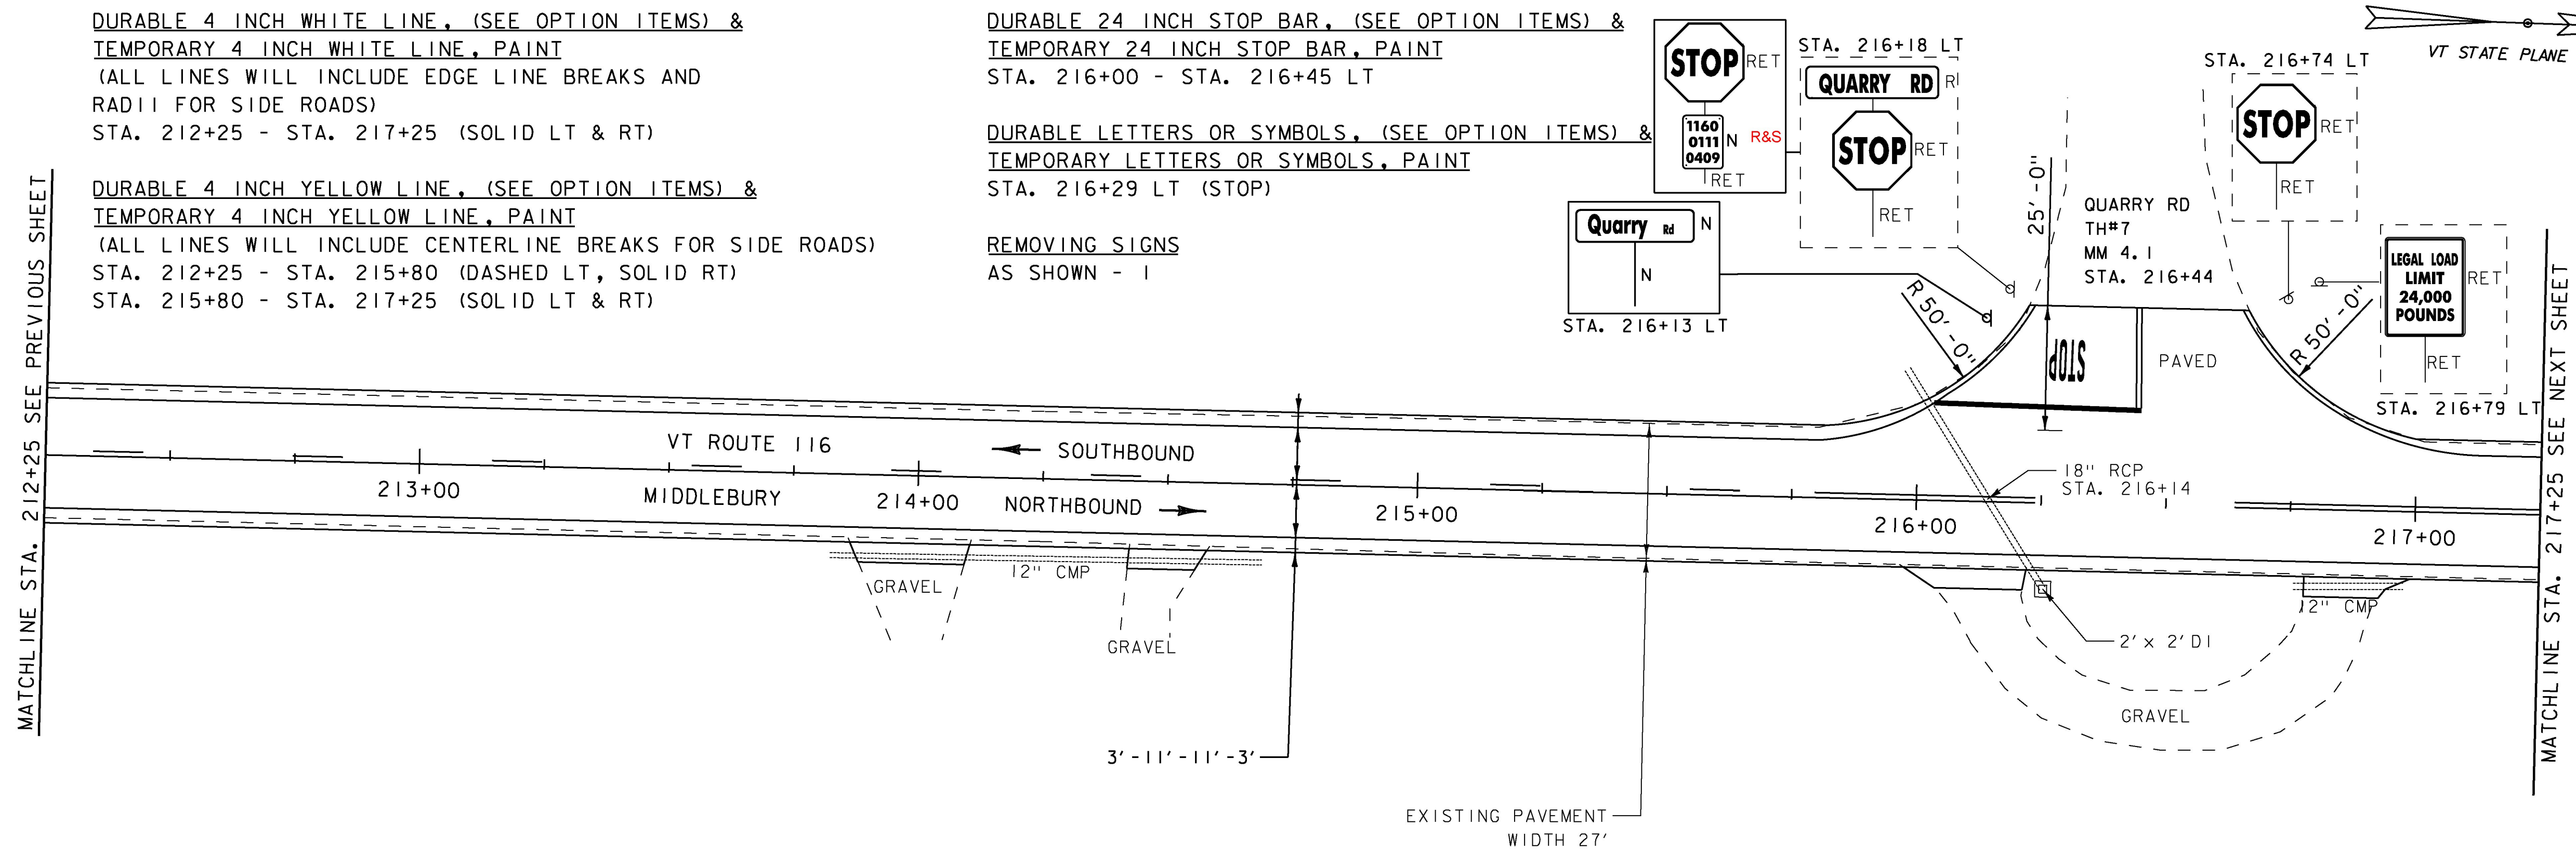

DURABLE 4 INCH WHITE LINE, (SEE OPTION ITEMS) &  
 TEMPORARY 4 INCH WHITE LINE, PAINT  
 (ALL LINES WILL INCLUDE EDGE LINE BREAKS AND  
 RADII FOR SIDE ROADS)  
 STA. 217+25 - STA. 222+25 (SOLID LT & RT)

DURABLE 4 INCH YELLOW LINE, (SEE OPTION ITEMS) &  
 TEMPORARY 4 INCH YELLOW LINE, PAINT  
 (ALL LINES WILL INCLUDE CENTERLINE BREAKS FOR SIDE ROADS)  
 STA. 217+25 - STA. 222+25 (SOLID LT & RT)

MATCHLINE STA. 217+25 SEE PREVIOUS SHEET

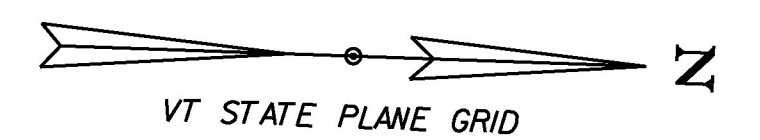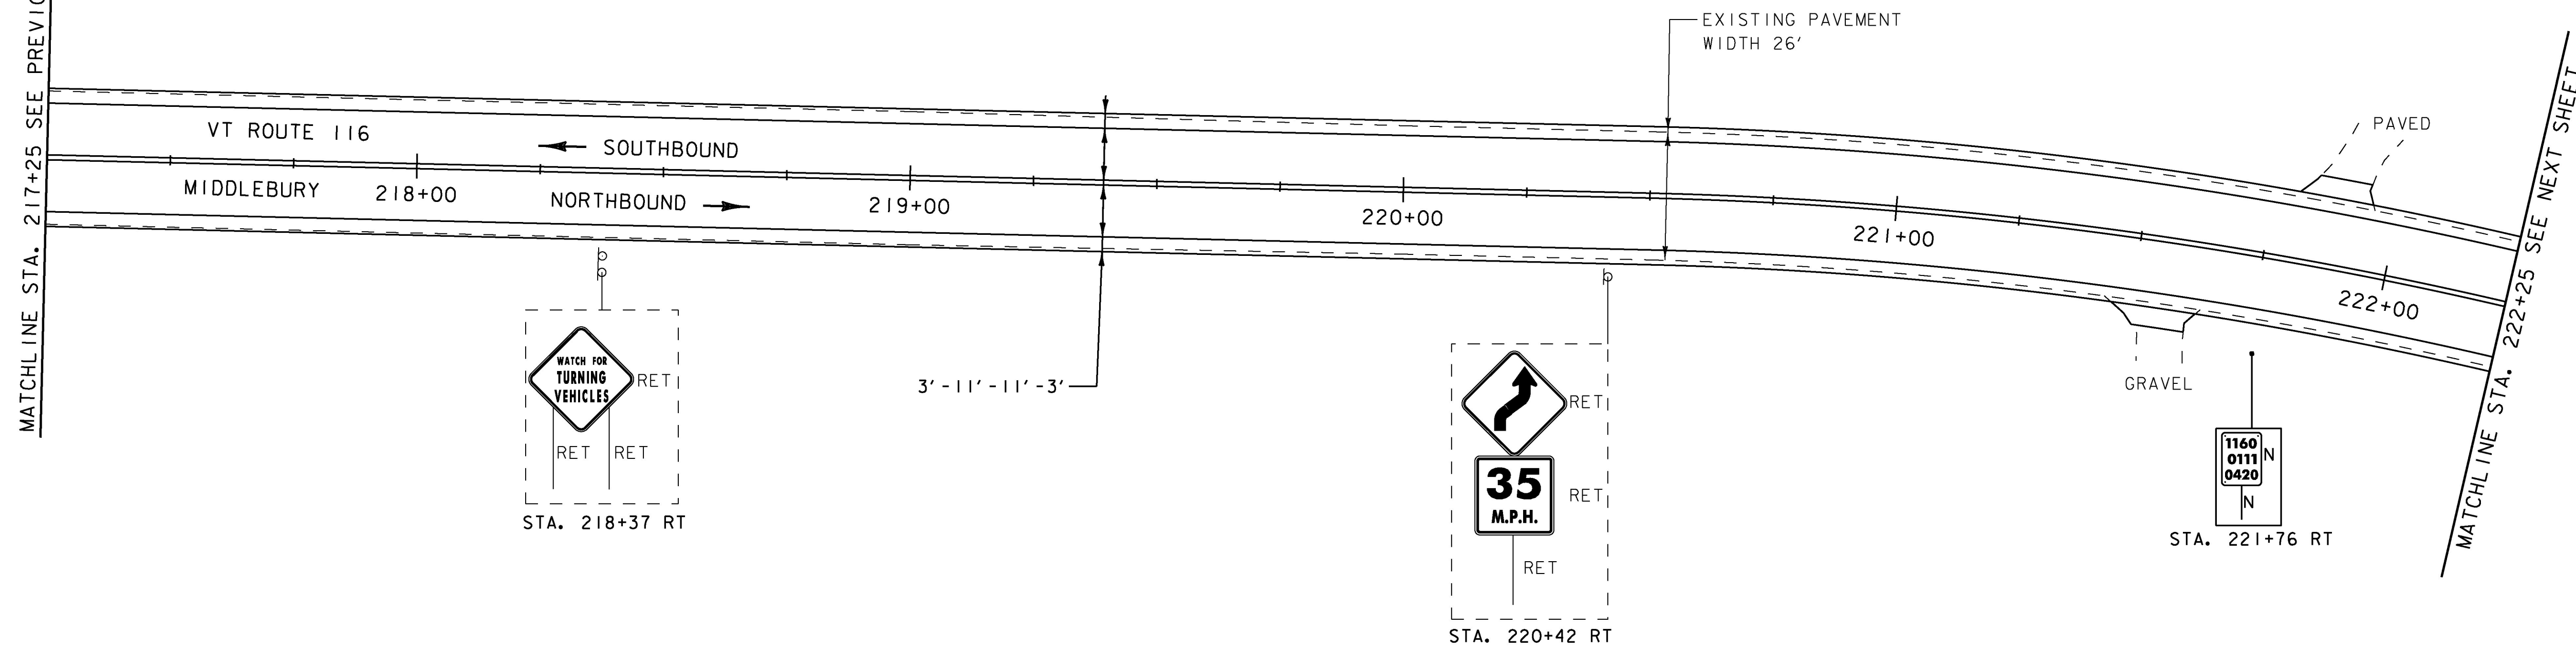

**SIGN LEGEND**  
 R = REMOVE  
 R&S = REMOVE AND SALVAGE  
 RET = RETAIN  
 S = SALVAGED  
 N = NEW  
 B-B = BACK TO BACK  
 - - = EXISTING  
 — = NEW



PROJECT NAME: MIDDLEBURY-STARKSBORO	PLOT DATE: 5/4/2017
PROJECT NUMBER: STP 2953(I)	DRAWN BY: J. GOODALL
FILE NAME: z14V227bdr.dgn	CHECKED BY: C.LATHROP
PROJECT LEADER: C.LATHROP	SHEET 49 OF 186
DESIGNED BY: J. GOODALL	
PLAN SHEET 23	