

MILLED RUMBLE STRIPS  
 STA. 275+25 - STA. 280+50 CTR

STEEL BEAM GUARDRAIL, GALVANIZED  
 STA. 278+16 - STA. 279+91 LT  
 STA. 278+74 - STA. 279+67 RT

ANCHOR FOR STEEL BEAM GUARDRAIL  
 AS SHOWN - 4  
 (SEE STD G1-D)



REMOVAL AND DISPOSAL OF GUARDRAIL  
 STA. 278+16 - STA. 279+91 LT  
 STA. 278+74 - STA. 279+67 RT

DURABLE 4 INCH WHITE LINE, (SEE OPTION ITEMS) &  
 TEMPORARY 4 INCH WHITE LINE, PAINT  
 (ALL LINES WILL INCLUDE EDGE LINE BREAKS AND  
 RADII FOR SIDE ROADS)

STA. 275+25 - STA. 280+50 (SOLID LT & RT)

DURABLE 4 INCH YELLOW LINE, (SEE OPTION ITEMS) &  
 TEMPORARY 4 INCH YELLOW LINE, PAINT  
 (ALL LINES WILL INCLUDE CENTERLINE BREAKS FOR SIDE ROADS)

STA. 275+25 - STA. 280+50 (SOLID LT & RT)

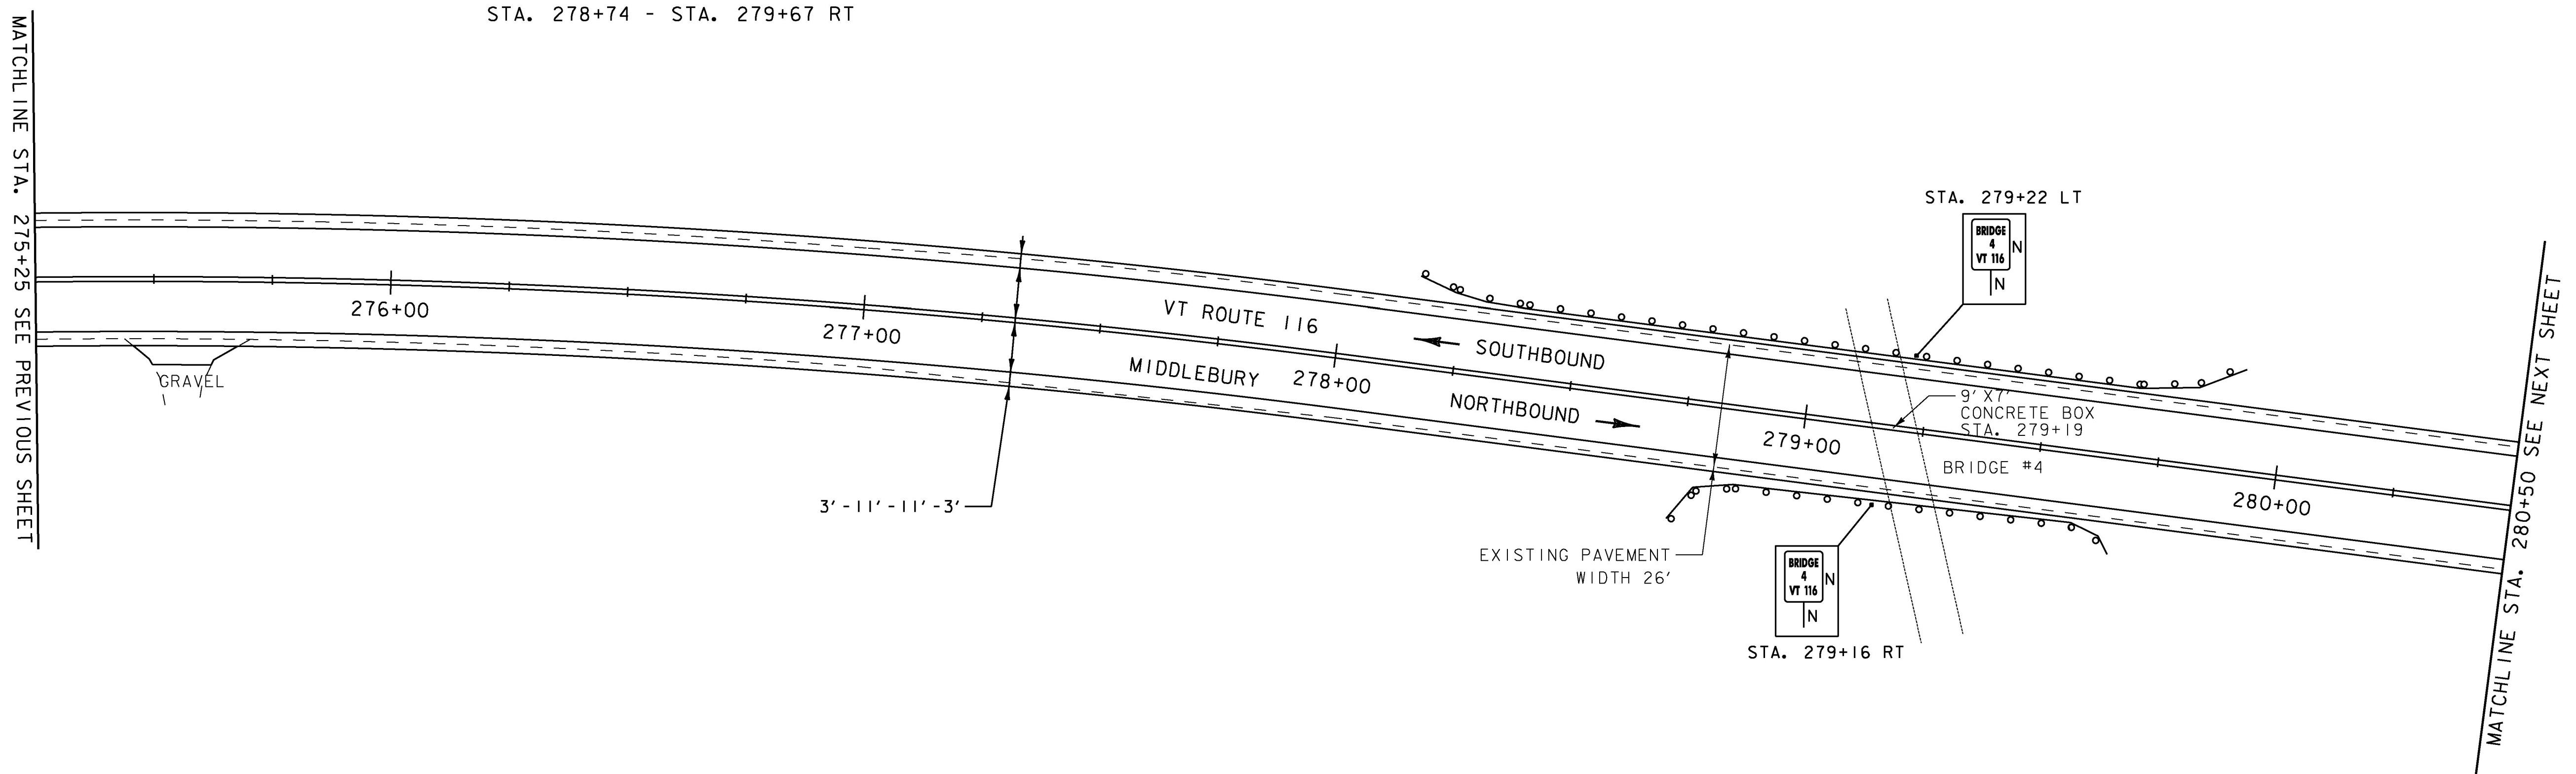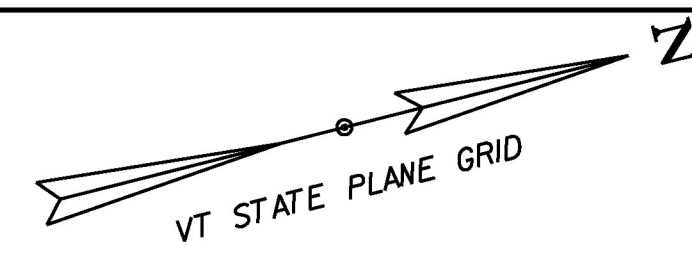

MILLED RUMBLE STRIPS  
 STA. 280+50 - STA. 285+75 CTR

STEEL BEAM GUARDRAIL, GALVANIZED  
 STA. 281+86 - STA. 282+23.5 LT  
 STA. 285+27.5 - STA. 285+65 LT

ANCHOR FOR STEEL BEAM GUARDRAIL  
 AS SHOWN - 2  
 (SEE STD G1-D)

REPLACE GUARDRAIL POST ASSEMBLY  
 SEE ITEM DETAIL SHEETS

REPLACE GUARDRAIL BEAM UNIT  
 SEE ITEM DETAIL SHEETS

ADJUST HEIGHT OF GUARDRAIL  
 SEE ITEM DETAIL SHEETS

REMOVAL AND DISPOSAL OF GUARDRAIL  
 STA. 281+86 - STA. 282+23.5 LT  
 STA. 285+27.5 - STA. 285+65 LT



DURABLE 4 INCH WHITE LINE, (SEE OPTION ITEMS) &  
 TEMPORARY 4 INCH WHITE LINE, PAINT  
 (ALL LINES WILL INCLUDE EDGE LINE BREAKS AND  
 RADII FOR SIDE ROADS)

STA. 280+50 - STA. 285+75 (SOLID LT & RT)

DURABLE 4 INCH YELLOW LINE, (SEE OPTION ITEMS) &  
 TEMPORARY 4 INCH YELLOW LINE, PAINT  
 (ALL LINES WILL INCLUDE CENTERLINE BREAKS FOR SIDE ROADS)

STA. 280+50 - STA. 285+75 (SOLID LT & RT)

REMOVING SIGNS  
 AS SHOWN - 1

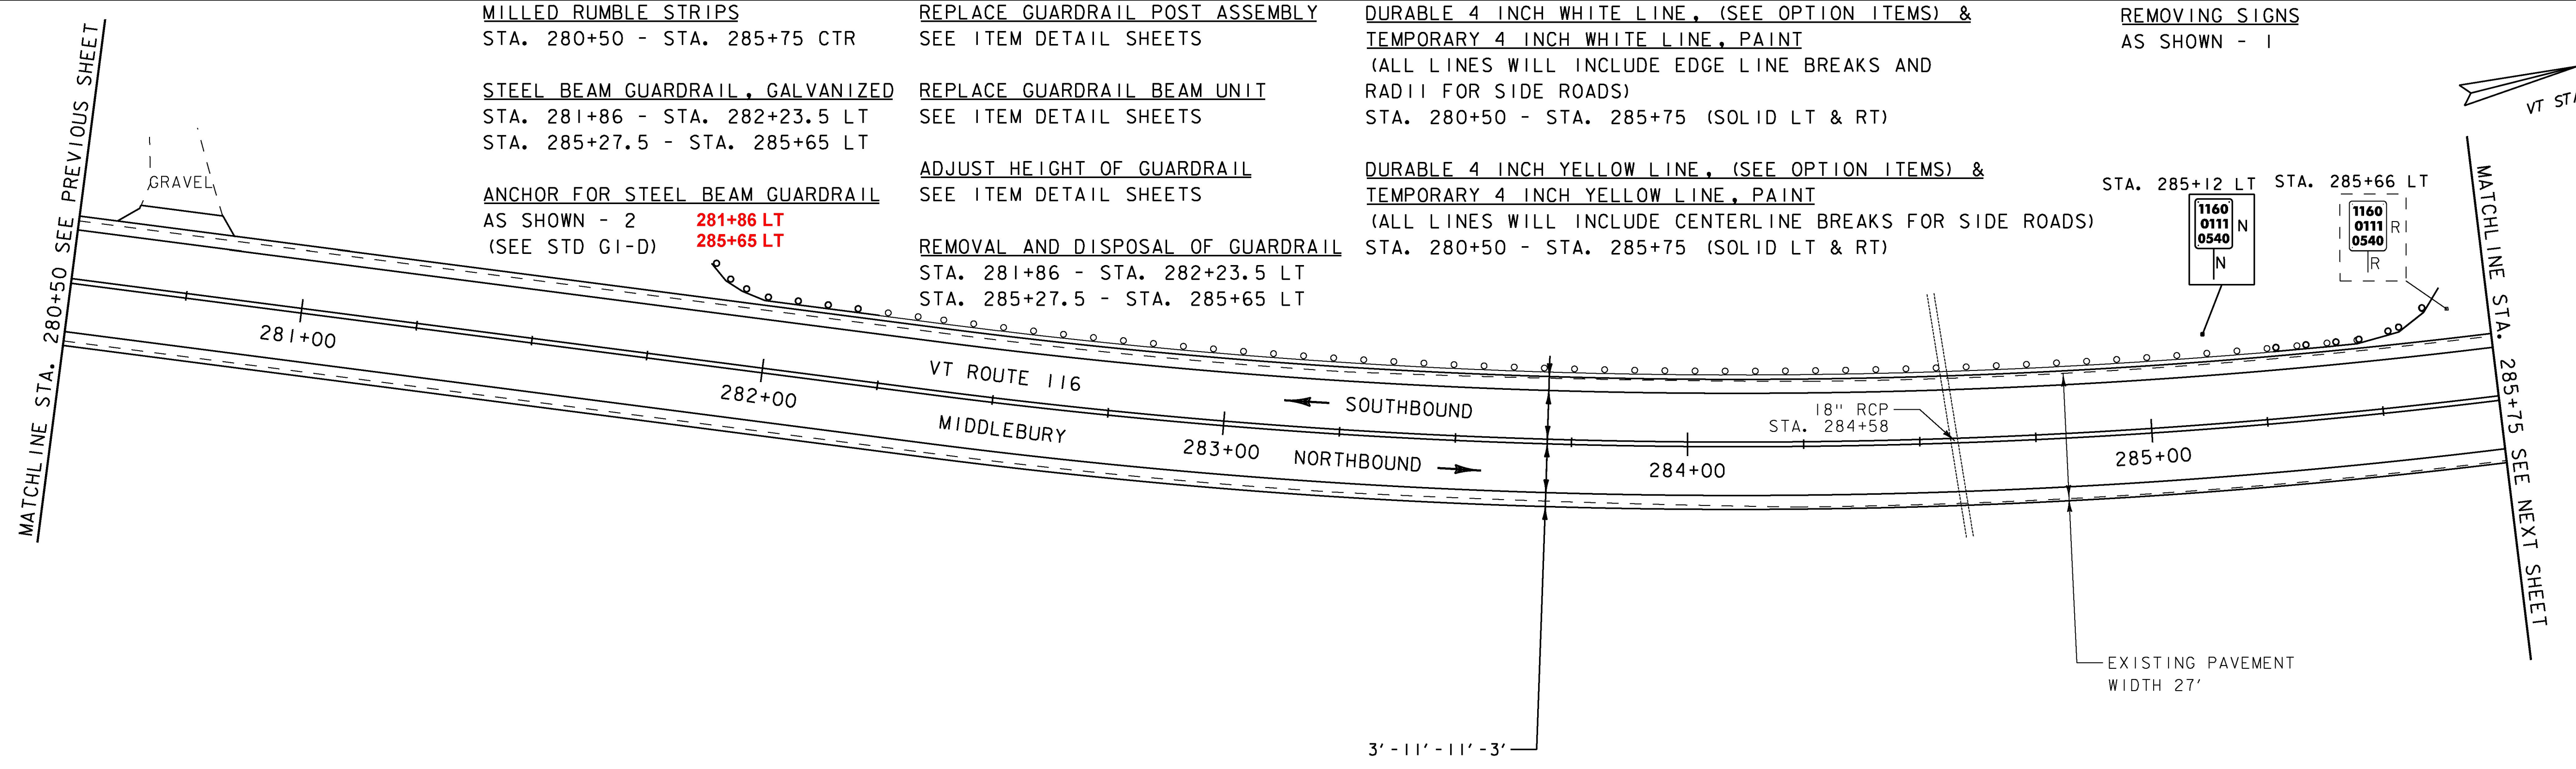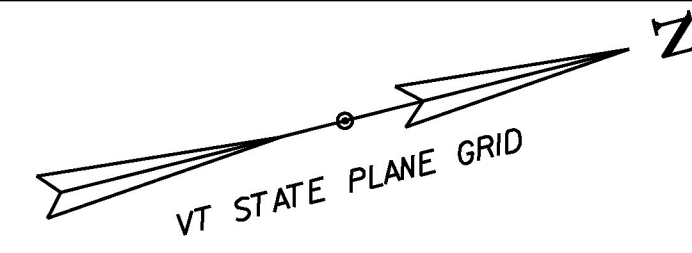

**SIGN LEGEND**

R = REMOVE  
 R&S = REMOVE AND SALVAGE  
 RET = RETAIN  
 S = SALVAGED  
 N = NEW  
 B-B = BACK TO BACK  
 - - = EXISTING  
 — = NEW



PROJECT NAME: MIDDLEBURY-STARKSBORO  
 PROJECT NUMBER: STP 2953(I)

FILE NAME: z14V227bdr.dgn  
 PROJECT LEADER: C.LATHROP  
 DESIGNED BY: J.GOODALL  
 PLAN SHEET 29

PLOT DATE: 5/4/2017  
 DRAWN BY: J.GOODALL  
 CHECKED BY: C.LATHROP  
 SHEET 55 OF 186