


MILLED RUMBLE STRIPS
STA. A 14+75 - STA. A 20+75 CTR

DURABLE 4 INCH WHITE LINE, (SEE OPTION ITEMS) &
TEMPORARY 4 INCH WHITE LINE, PAINT
(ALL LINES WILL INCLUDE EDGE LINE BREAKS AND
RADI FOR SIDE ROADS)
STA. A 14+75 - STA. A 20+75 (SOLID LT & RT)


DURABLE 4 INCH YELLOW LINE, (SEE OPTION ITEMS) &
TEMPORARY 4 INCH YELLOW LINE, PAINT
(ALL LINES WILL INCLUDE CENTERLINE BREAKS FOR SIDE ROADS)
STA. A 14+75 - STA. A 20+75 (SOLID LT & RT)

REMOVING SIGNS
AS SHOWN - 1

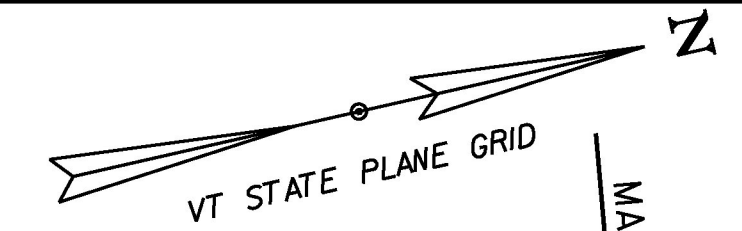

MATCHLINE STA. A 14+75 SEE PREVIOUS SHEET


MATCHLINE STA. A 20+75 SEE NEXT SHEET

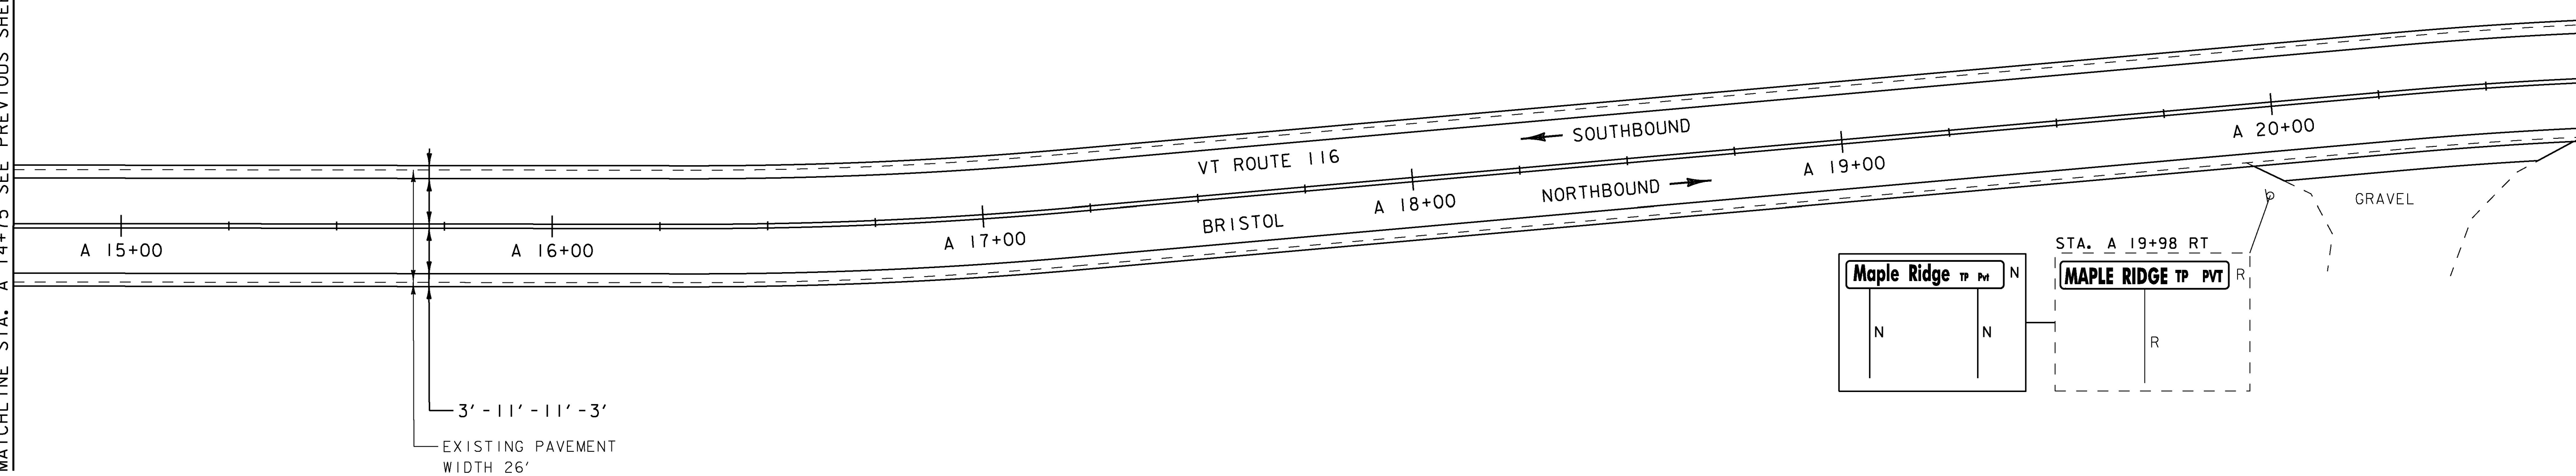

MILLED RUMBLE STRIPS
STA. A 20+75 - STA. A 25+75 CTR

STEEL BEAM GUARDRAIL, GALVANIZED
STA. A 21+01 - STA. A 21+38.5 RT
STA. A 23+15.5 - STA. A 23+53 RT

STA. A 21+12 LT

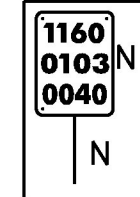

ANCHOR FOR STEEL BEAM GUARDRAIL
AS SHOWN - 2 A 21+01 RT
(SEE STD G1-D) A 23+53 RT

REPLACE GUARDRAIL POST ASSEMBLY
SEE ITEM DETAIL SHEETS


REPLACE GUARDRAIL BEAM UNIT
SEE ITEM DETAIL SHEETS

ADJUST HEIGHT OF GUARDRAIL
SEE ITEM DETAIL SHEETS

REMOVAL AND DISPOSAL OF GUARDRAIL
STA. A 21+01 - STA. A 21+38.5 RT
STA. A 23+15.5 - STA. A 23+53 RT


DURABLE 4 INCH WHITE LINE, (SEE OPTION ITEMS) &
TEMPORARY 4 INCH WHITE LINE, PAINT
(ALL LINES WILL INCLUDE EDGE LINE BREAKS AND
RADI FOR SIDE ROADS)
STA. A 20+75 - STA. A 25+75 (SOLID LT & RT)

DURABLE 4 INCH YELLOW LINE, (SEE OPTION ITEMS) &
TEMPORARY 4 INCH YELLOW LINE, PAINT
(ALL LINES WILL INCLUDE CENTERLINE BREAKS FOR SIDE ROADS)
STA. A 20+75 - STA. A 24+28 (SOLID LT & RT)
STA. A 24+28 - STA. A 25+75 (SOLID LT, DASHED RT)

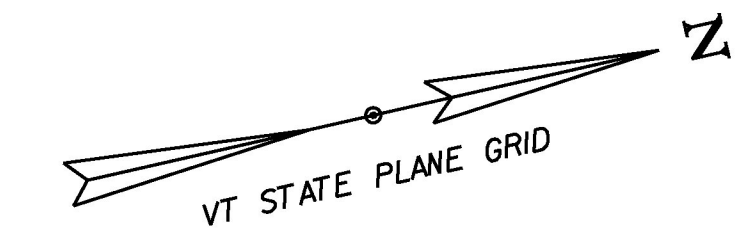


MATCHLINE STA. A 20+75 SEE PREVIOUS SHEET

MATCHLINE STA. A 25+75 SEE NEXT SHEET

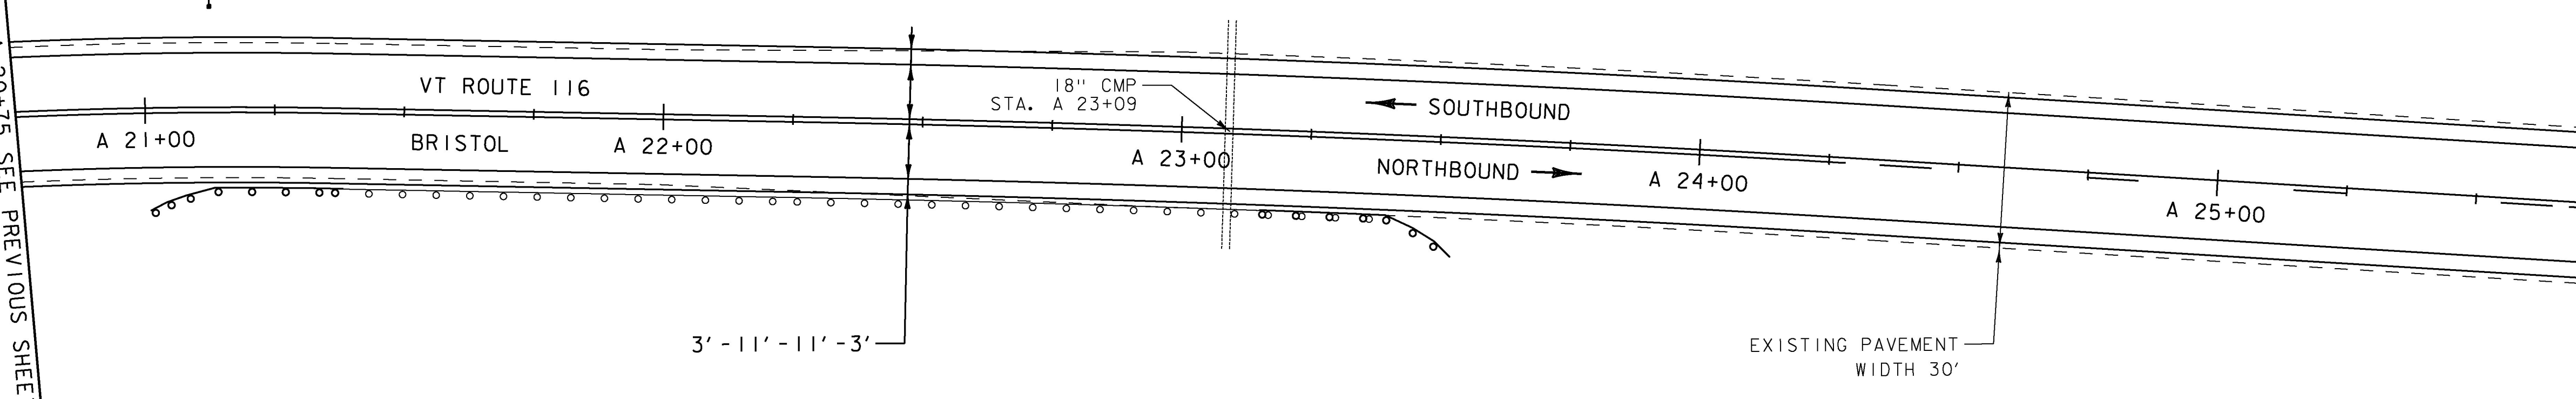

SIGN LEGEND

- R = REMOVE
- R&S = REMOVE AND SALVAGE
- RET = RETAIN
- S = SALVAGED
- N = NEW
- B-B = BACK TO BACK
- - = EXISTING
- = NEW

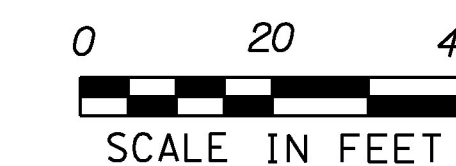

PROJECT NAME: MIDDLEBURY-STARKSBORO
PROJECT NUMBER: STP 2953(I)

FILE NAME: z14V227bdr.dgn
PROJECT LEADER: C.LATHROP
DESIGNED BY: J. GOODALL
PLAN SHEET 38

PLOT DATE: 5/4/2017
DRAWN BY: J. GOODALL
CHECKED BY: C.LATHROP
SHEET 64 OF 186