


STONE FILL, TYPE 1
 A 178+00 RT to A 180+00 RT
 A 173+30 LT to A 179+00 LT (Ditch)

SIGN LEGEND

- R = REMOVE
- R&S = REMOVE AND SALVAGE
- RET = RETAIN
- S = SALVAGED
- N = NEW
- B-B = BACK TO BACK
- - = EXISTING
- = NEW

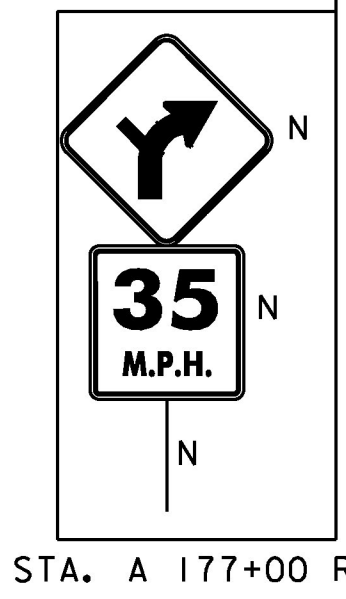

PROJECT NAME: MIDDLEBURY-STARKSBORO	
PROJECT NUMBER: STP 2953(1)	
FILE NAME: z14v227bdr.dgn	PLOT DATE: 5/4/2017
PROJECT LEADER: C.LATHROP	DRAWN BY: J. GOODALL
DESIGNED BY: J. GOODALL	CHECKED BY: C.LATHROP
PLAN SHEET 52	SHEET 78 OF 186

