

MILLED RUMBLE STRIPS
STA. A 184+00 - STA. A 185+75 CTR

STONE FILL, TYPE I
STA. A 180+50 - STA. A 181+00 RT



STEEL BEAM GUARDRAIL, GALVANIZED
STA. A 180+50 - STA. ~~A 181+85 RT~~
~~A 180+60 RT~~

ANCHOR FOR STEEL BEAM GUARDRAIL
AS SHOWN - I ~~A 181+85 RT~~
(SEE STD G1-D)

DURABLE 4 INCH WHITE LINE, (SEE OPTION ITEMS) &
TEMPORARY 4 INCH WHITE LINE, PAINT
(ALL LINES WILL INCLUDE EDGE LINE BREAKS AND
RADI1 FOR SIDE ROADS)
STA. A 180+50 - STA. A 185+75 (SOLID LT & RT)

GEOTEXTILE FOR SILT FENCE
STA. A 180+50 - STA. A 181+00 RT

REMOVING SIGNS
AS SHOWN - 5

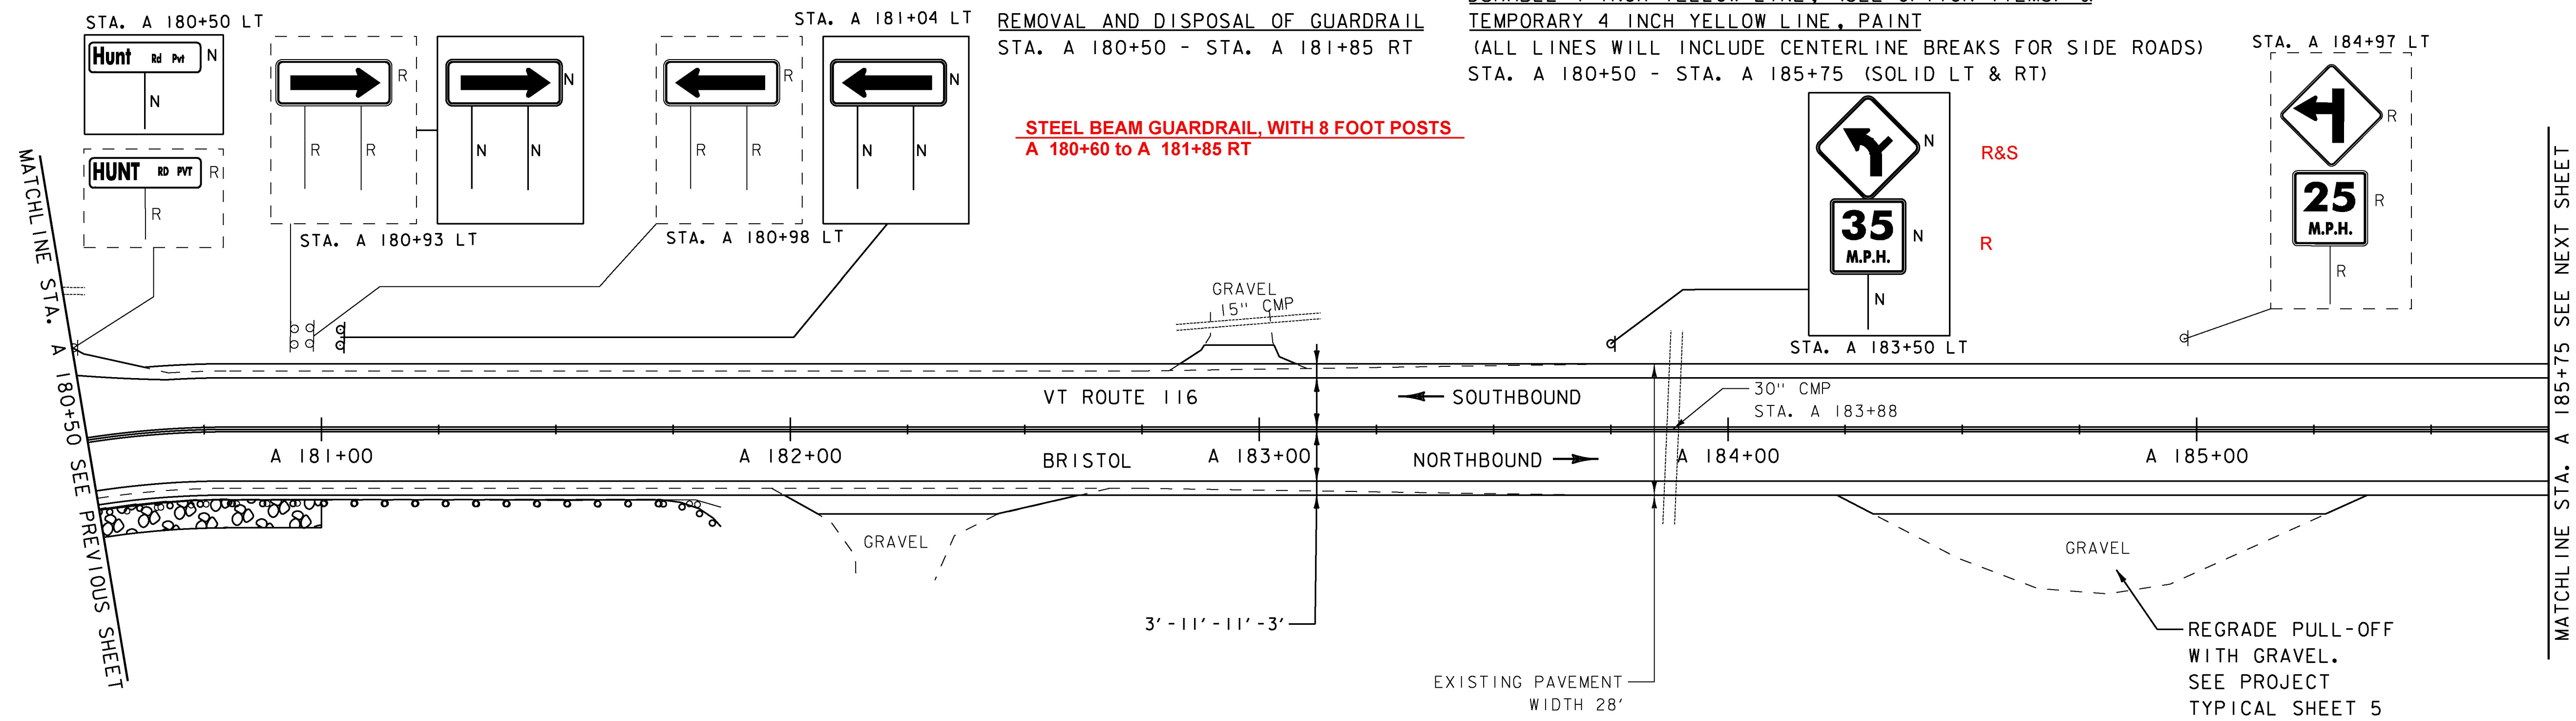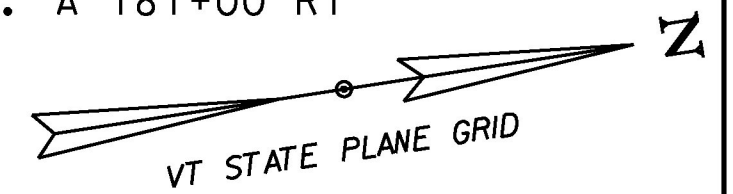



MILLED RUMBLE STRIPS
STA. A 185+75 - STA. A 191+25 CTR

ADJUST HEIGHT OF GUARDRAIL
SEE ITEM DETAIL SHEETS

DURABLE 4 INCH WHITE LINE, (SEE OPTION ITEMS) &
TEMPORARY 4 INCH WHITE LINE, PAINT
(ALL LINES WILL INCLUDE EDGE LINE BREAKS AND
RADI1 FOR SIDE ROADS)
STA. A 185+75 - STA. A 191+25 (SOLID LT & RT)


DURABLE 4 INCH YELLOW LINE, (SEE OPTION ITEMS) &
TEMPORARY 4 INCH YELLOW LINE, PAINT
(ALL LINES WILL INCLUDE CENTERLINE BREAKS FOR SIDE ROADS)
STA. A 185+75 - STA. A 190+00 (SOLID LT & RT)
STA. A 190+00 - STA. A 191+25 (SOLID LT, DASHED RT)

REMOVING SIGNS
AS SHOWN - 1

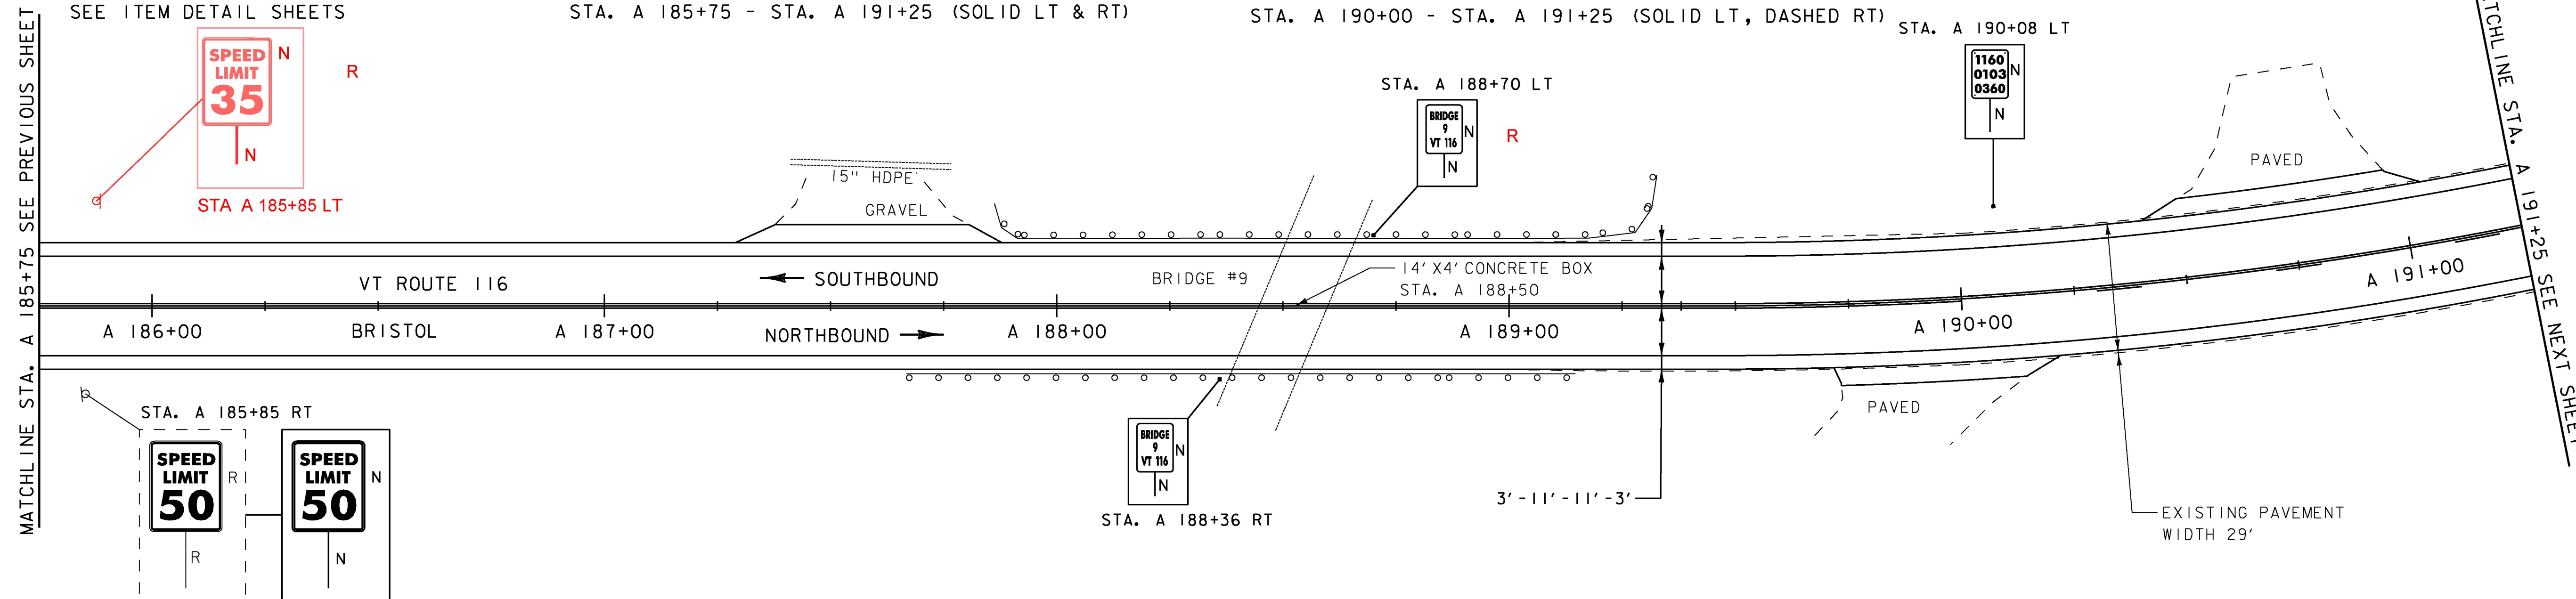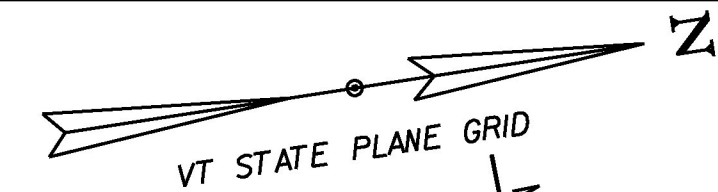

SIGN LEGEND

R = REMOVE
R&S = REMOVE AND SALVAGE
RET = RETAIN
S = SALVAGED
N = NEW
B-B = BACK TO BACK
- - = EXISTING
— = NEW

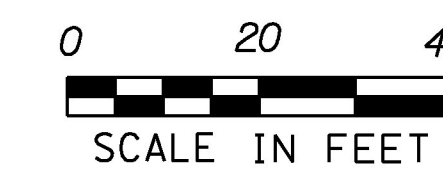

PROJECT NAME: MIDDLEBURY-STARKSBORO
PROJECT NUMBER: STP 2953(I)

FILE NAME: z14V227bdr.dgn
PROJECT LEADER: C.LATHROP
DESIGNED BY: J. GOODALL
PLAN SHEET 53

PLOT DATE: 5/4/2017
DRAWN BY: J. GOODALL
CHECKED BY: C.LATHROP
SHEET 79 OF 186