


DURABLE 4 INCH WHITE LINE, (SEE OPTION ITEMS) & TEMPORARY 4 INCH WHITE LINE, PAINT
 (ALL LINES WILL INCLUDE EDGE LINE BREAKS AND RADII FOR SIDE ROADS)
 STA. A 257+25 - STA. A 262+75 (SOLID LT & RT)

DURABLE 4 INCH YELLOW LINE, (SEE OPTION ITEMS) & TEMPORARY 4 INCH YELLOW LINE, PAINT
 (ALL LINES WILL INCLUDE CENTERLINE BREAKS FOR SIDE ROADS)
 STA. A 257+25 - STA. A 258+55 (DASHED LT, SOLID RT)
 STA. A 258+55 - STA. A 262+75 (SOLID LT & RT)

DURABLE 24 INCH STOP BAR, (SEE OPTION ITEMS) & TEMPORARY 24 INCH STOP BAR, PAINT
 STA. A 258+73 - STA. A 259+06 RT


REMOVING SIGNS AS SHOWN - 2

DURABLE LETTERS OR SYMBOLS, (SEE OPTION ITEMS) & TEMPORARY LETTERS OR SYMBOLS, PAINT
 STA. A 258+90 RT (STOP)

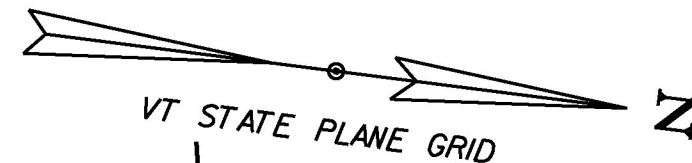

MATCHLINE STA. A 257+25 SEE PREVIOUS SHEET


MATCHLINE STA. A 262+75 SEE NEXT SHEET

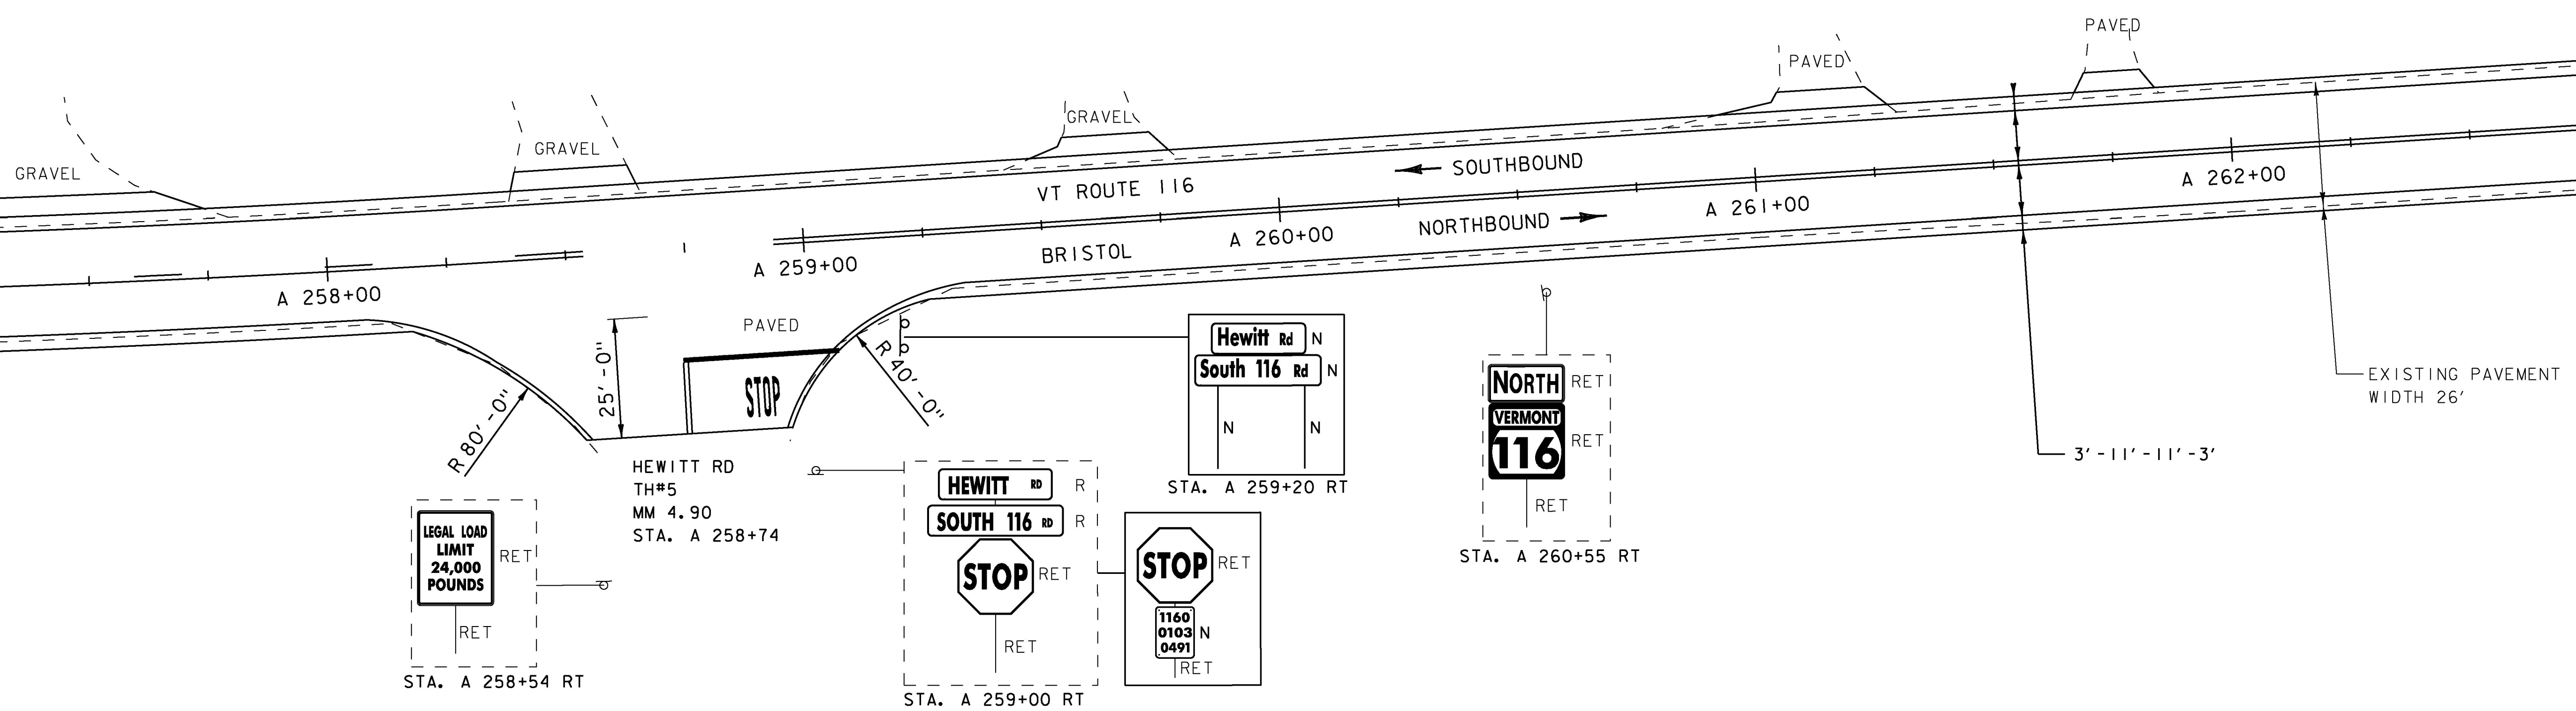

DURABLE 4 INCH WHITE LINE, (SEE OPTION ITEMS) & TEMPORARY 4 INCH WHITE LINE, PAINT
 (ALL LINES WILL INCLUDE EDGE LINE BREAKS AND RADII FOR SIDE ROADS)
 STA. A 262+75 - STA. A 268+25 (SOLID LT & RT)


DURABLE 4 INCH YELLOW LINE, (SEE OPTION ITEMS) & TEMPORARY 4 INCH YELLOW LINE, PAINT
 (ALL LINES WILL INCLUDE CENTERLINE BREAKS FOR SIDE ROADS)
 STA. A 262+75 - STA. A 268+25 (SOLID LT & RT)

The A. Johnson Co
 half mile ahead
 RET RET
 STA. A 266+87 LT

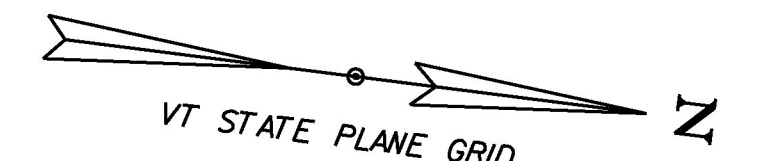

MATCHLINE STA. A 262+75 SEE PREVIOUS SHEET

MATCHLINE STA. A 268+25 SEE NEXT SHEET

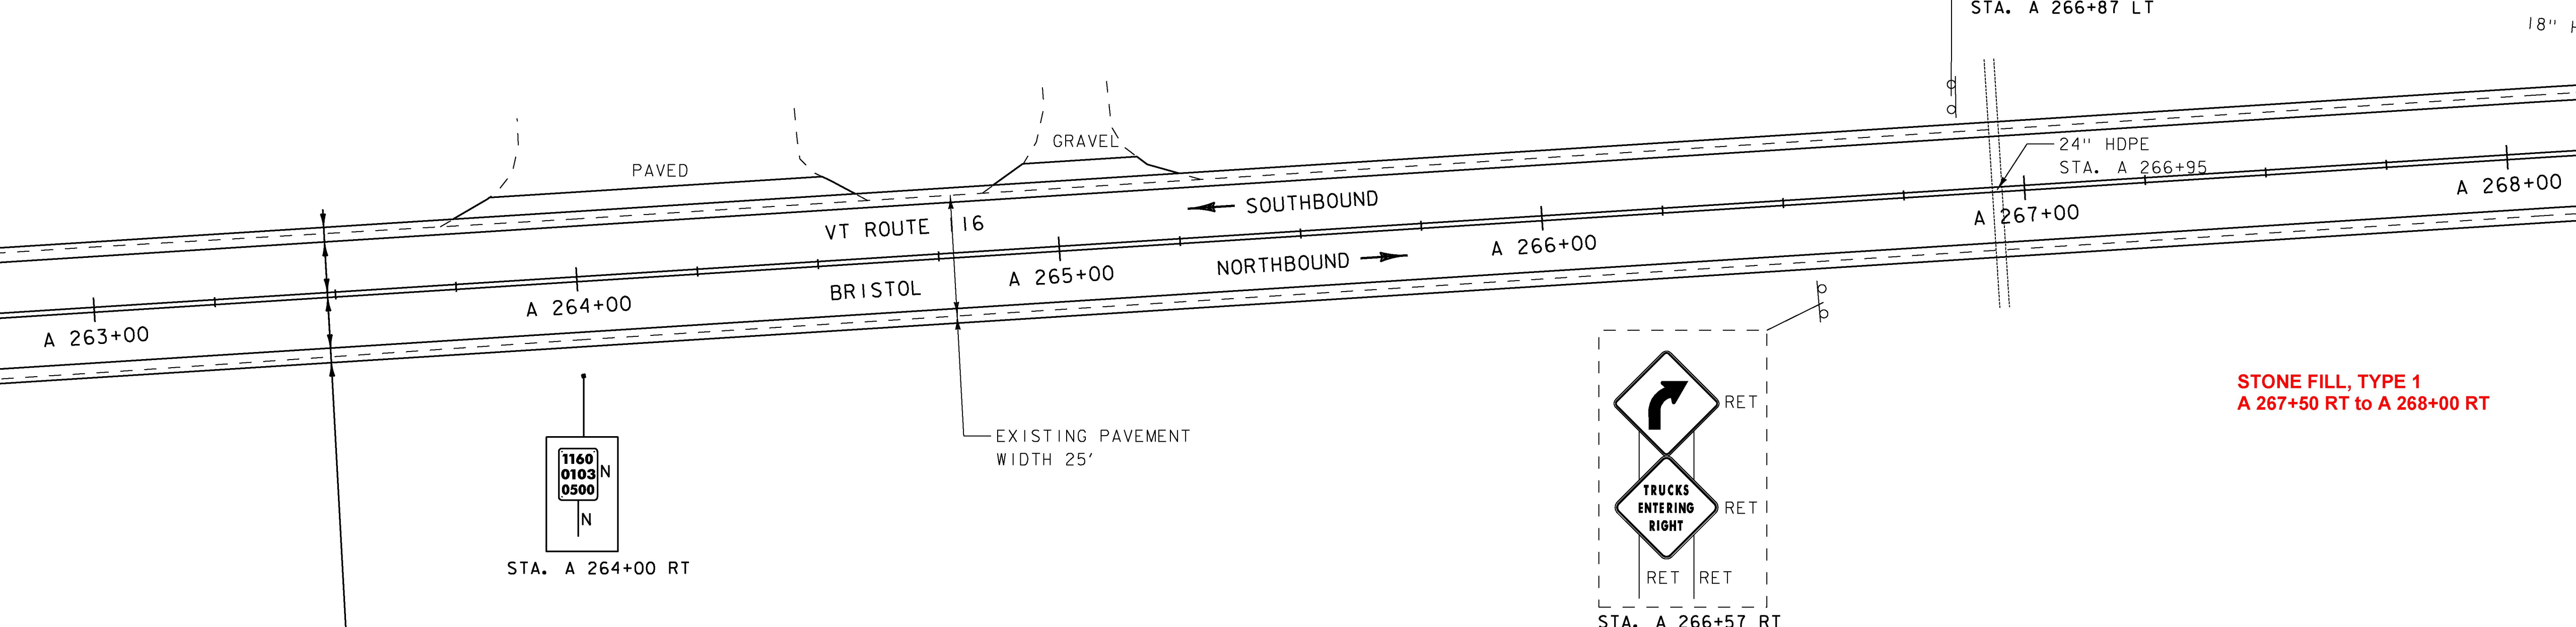

SIGN LEGEND
 R = REMOVE
 R&S = REMOVE AND SALVAGE
 RET = RETAIN
 S = SALVAGED
 N = NEW
 B-B = BACK TO BACK
 - - = EXISTING
 — = NEW



| | |
|-------------------------------------|-----------------------|
| PROJECT NAME: MIDDLEBURY-STARKSBORO | PLOT DATE: 5/4/2017 |
| PROJECT NUMBER: STP 2953(1) | DRAWN BY: J. GOODALL |
| FILE NAME: z14V227bdr.dgn | CHECKED BY: C.LATHROP |
| DESIGNED BY: J. GOODALL | SHEET 86 OF 186 |
| PLAN SHEET 60 | |