


DURABLE 4 INCH WHITE LINE, (SEE OPTION ITEMS) & TEMPORARY 4 INCH WHITE LINE, PAINT
 (ALL LINES WILL INCLUDE EDGE LINE BREAKS AND RADIUS FOR SIDE ROADS)
 STA. A 289+75 - STA. A 295+25 (SOLID LT & RT)

DURABLE 4 INCH YELLOW LINE, (SEE OPTION ITEMS) & TEMPORARY 4 INCH YELLOW LINE, PAINT
 (ALL LINES WILL INCLUDE CENTERLINE BREAKS FOR SIDE ROADS)
 STA. A 289+75 - STA. A 295+25 (SOLID LT & RT)



MATCHLINE STA. A 289+75 SEE PREVIOUS SHEET

STOP COLD PLANE
 BEGIN TRANSITION
 STA. A 290+25 (MM 5.497)


END TRANSITION
 RESUME LEVEL/OVERLAY
 STA. A 291+25 (MM 5.516)

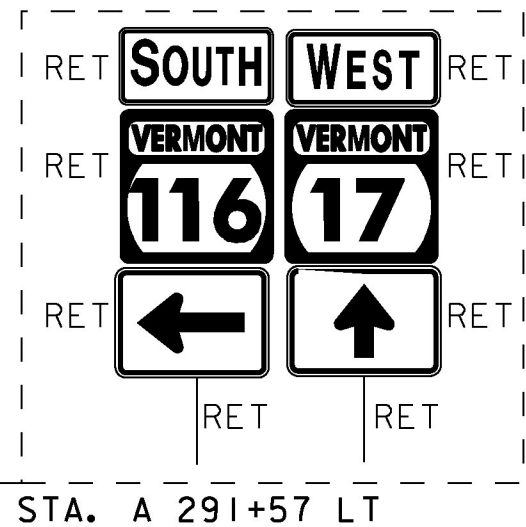

REMOVING SIGNS
 AS SHOWN - 7

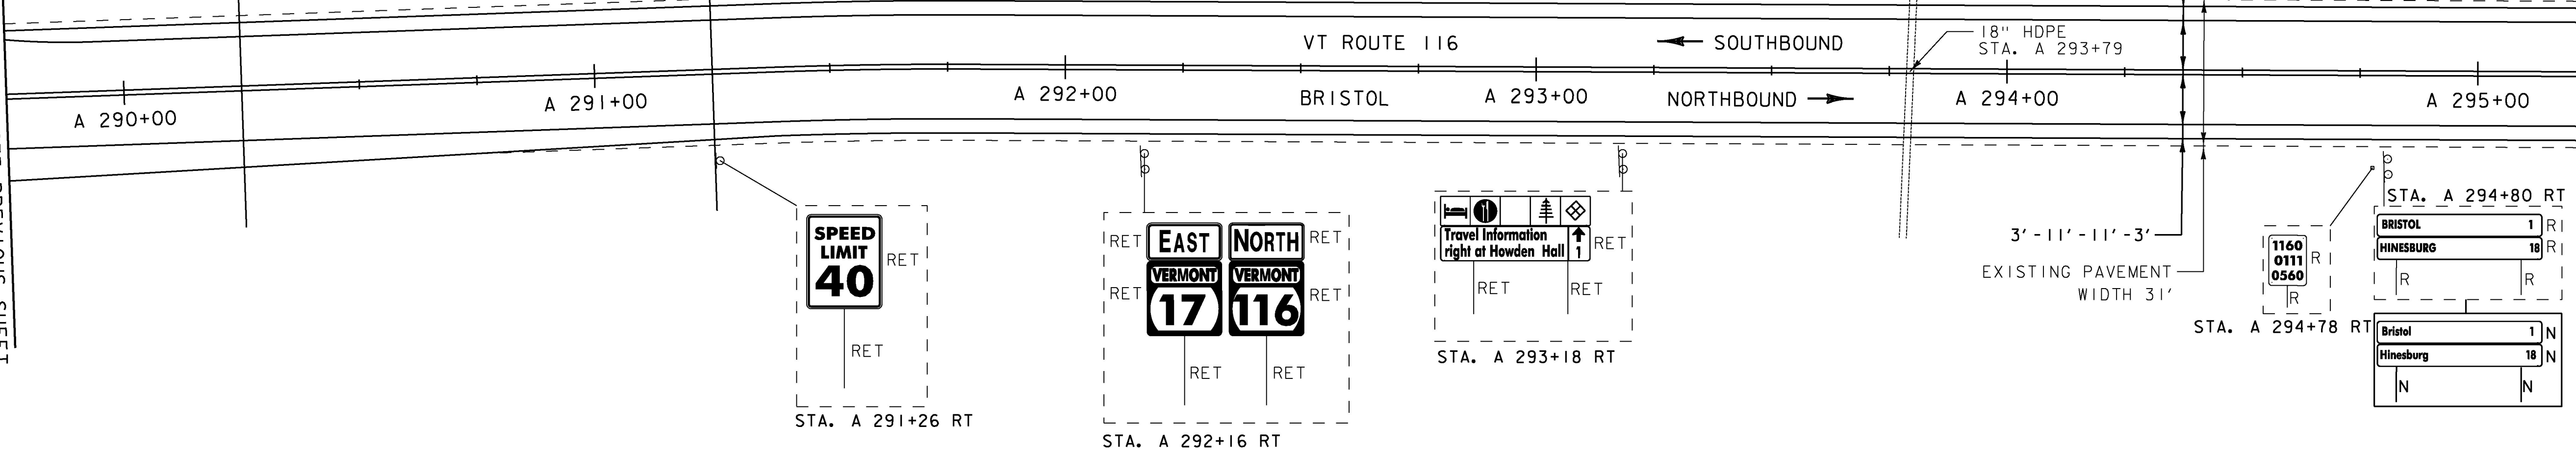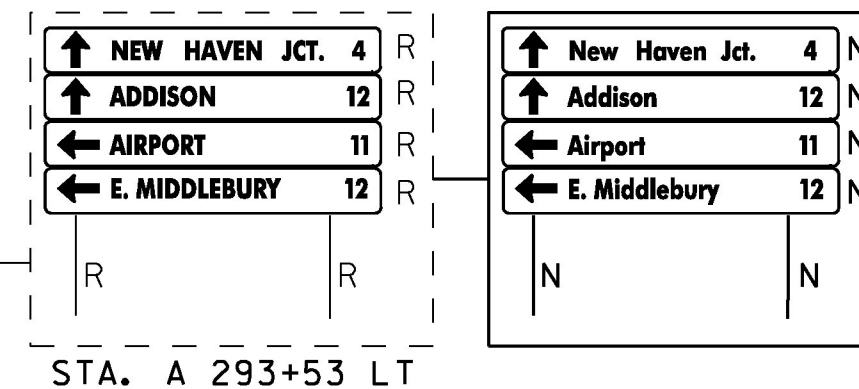

MATCHLINE STA. A 295+25 SEE NEXT SHEET

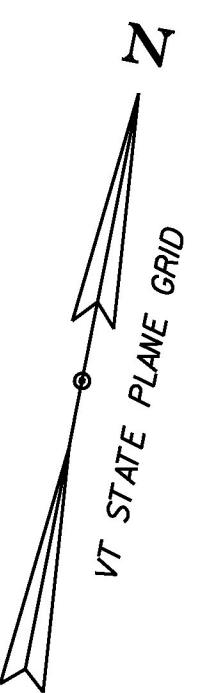

DURABLE 4 INCH WHITE LINE, (SEE OPTION ITEMS) & TEMPORARY 4 INCH WHITE LINE, PAINT
 (ALL LINES WILL INCLUDE EDGE LINE BREAKS AND RADIUS FOR SIDE ROADS)
 STA. A 295+25 - STA. A 300+75 (SOLID LT & RT)

DURABLE 4 INCH YELLOW LINE, (SEE OPTION ITEMS) & TEMPORARY 4 INCH YELLOW LINE, PAINT
 (ALL LINES WILL INCLUDE CENTERLINE BREAKS FOR SIDE ROADS)
 STA. A 295+25 - STA. A 300+75 (SOLID LT & RT)



DURABLE 24 INCH STOP BAR, (SEE OPTION ITEMS) & TEMPORARY 24 INCH STOP BAR, PAINT
 STA. A 300+04 - STA. A 300+35 RT

DURABLE LETTERS OR SYMBOLS, (SEE OPTION ITEMS) & TEMPORARY LETTERS OR SYMBOLS, PAINT
 STA. A 295+42 LT (AHEAD)
 STA. A 295+74 LT (STOP)
 STA. A 300+17 RT (STOP)



REMOVING SIGNS
 AS SHOWN - 2

STONE FILL, TYPE 1
 A 295+55 to A 297+25 LT
 A 297+80 to A 297+93 LT


MATCHLINE STA. A 295+25 SEE PREVIOUS SHEET

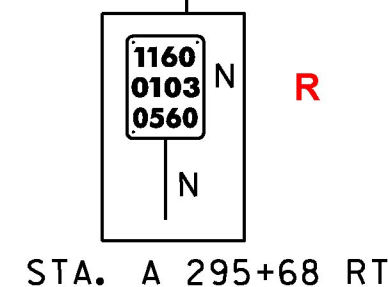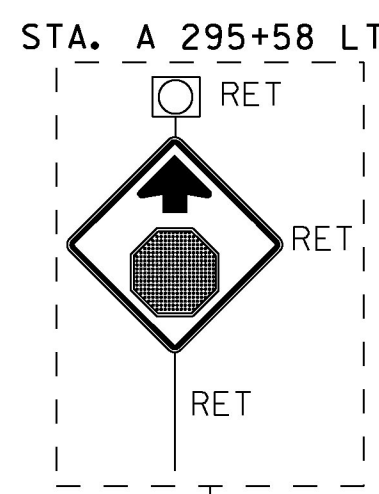





GRAVEL
 15" CMP

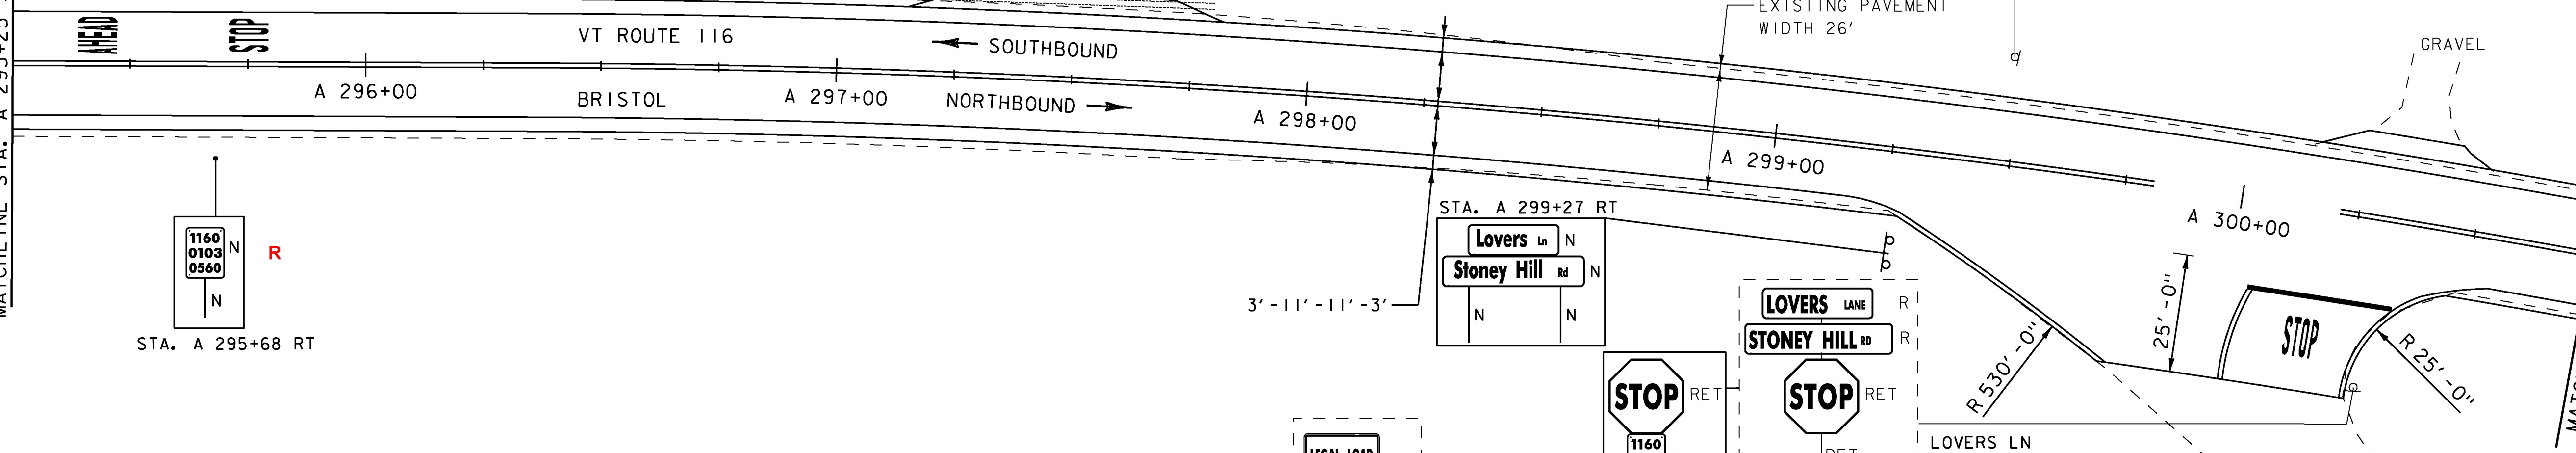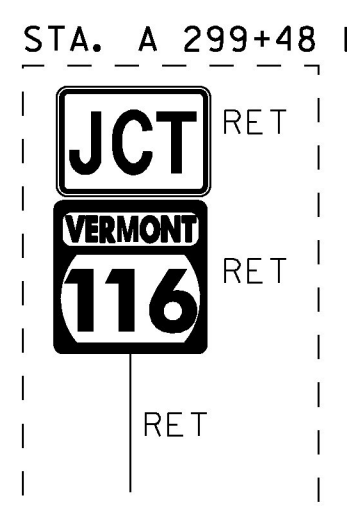

MATCHLINE STA. A 300+75 SEE NEXT SHEET

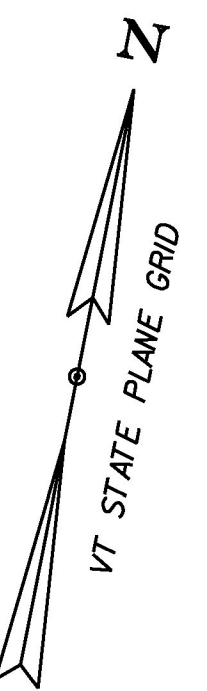

SIGN LEGEND
 R = REMOVE
 R&S = REMOVE AND SALVAGE
 RET = RETAIN
 S = SALVAGED
 N = NEW
 B-B = BACK TO BACK
 - - = EXISTING
 — = NEW

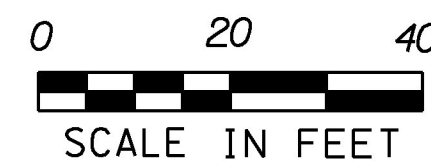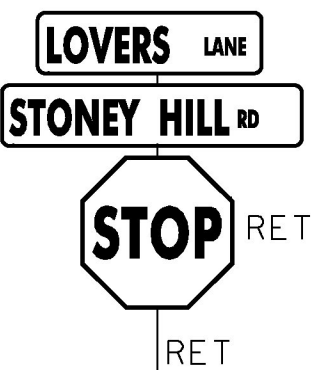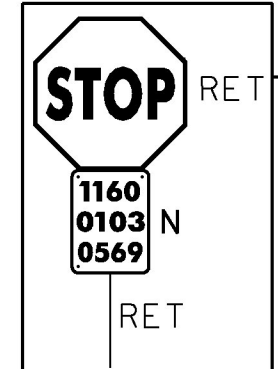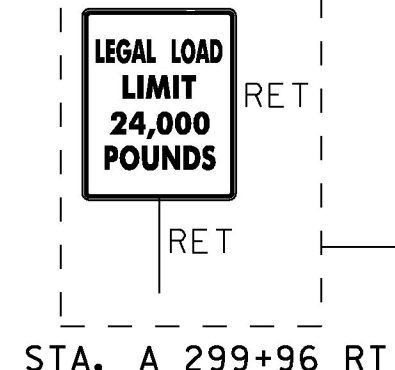

PROJECT NAME: MIDDLEBURY-STARKSBORO
 PROJECT NUMBER: STP 2953(1)
 FILE NAME: z14V227bdr.dgn
 PROJECT LEADER: C.LATHROP
 DESIGNED BY: J. GOODALL
 PLAN SHEET 64

PLOT DATE: 5/4/2017
 DRAWN BY: J. GOODALL
 CHECKED BY: C.LATHROP
 SHEET 90 OF 186