

STONE FILL, TYPE 1 A 313+00 LT
 STA. A 311+50 - STA. A 314+25 LT
 A 311+50 to A 317+15 RT

STEEL BEAM GUARDRAIL, GALVANIZED
 STA. A 311+50 - STA. A 314+75 LT

ANCHOR FOR STEEL BEAM GUARDRAIL
 AS SHOWN - I A 314+75 LT
 (SEE STD G1-D)

REMOVAL AND DISPOSAL OF GUARDRAIL
 STA. A 311+50 - STA. A 314+75 LT

DURABLE 4 INCH WHITE LINE, (SEE OPTION ITEMS) &
 TEMPORARY 4 INCH WHITE LINE, PAINT
 (ALL LINES WILL INCLUDE EDGE LINE BREAKS AND
 RADI FOR SIDE ROADS)
 STA. A 311+50 - STA. A 317+15 (SOLID LT & RT)
 STA. A 312+00 - STA. A 313+20 (DOTTED RT)
 STA. A 313+20 - STA. A 317+15 (SOLID RT)

DURABLE 4 INCH YELLOW LINE, (SEE OPTION ITEMS) &
 TEMPORARY 4 INCH YELLOW LINE, PAINT
 (ALL LINES WILL INCLUDE CENTERLINE BREAKS FOR SIDE ROADS)
 STA. A 311+50 - STA. A 317+15 (SOLID LT & RT)


STONE FILL, TYPE 1
 314+50 to A 315+30 LT
 (Outlet Ditches - Thru Curb Board)

DURABLE LETTERS OR SYMBOLS, (SEE OPTION ITEMS) &
 TEMPORARY LETTERS OR SYMBOLS, PAINT
 STA. A 313+24 RT (ONLY)
 STA. A 313+64 RT (LT ARROW)
 STA. A 314+42 RT (ONLY)
 STA. A 314+82 RT (LT ARROW)
 STA. A 315+58 RT (ONLY)
 STA. A 315+98 RT (LT ARROW)
 STA. A 316+76 RT (ONLY)
 STA. A 317+16 RT (LT ARROW)

GEOTEXTILE FOR SILT FENCE
 STA. A 311+50 - STA. A 314+25 LT

REMOVING SIGNS
 AS SHOWN - 4

BITUMINOUS CONCRETE CURB, TYPE A
 A 311+50 to A 314+25 LT

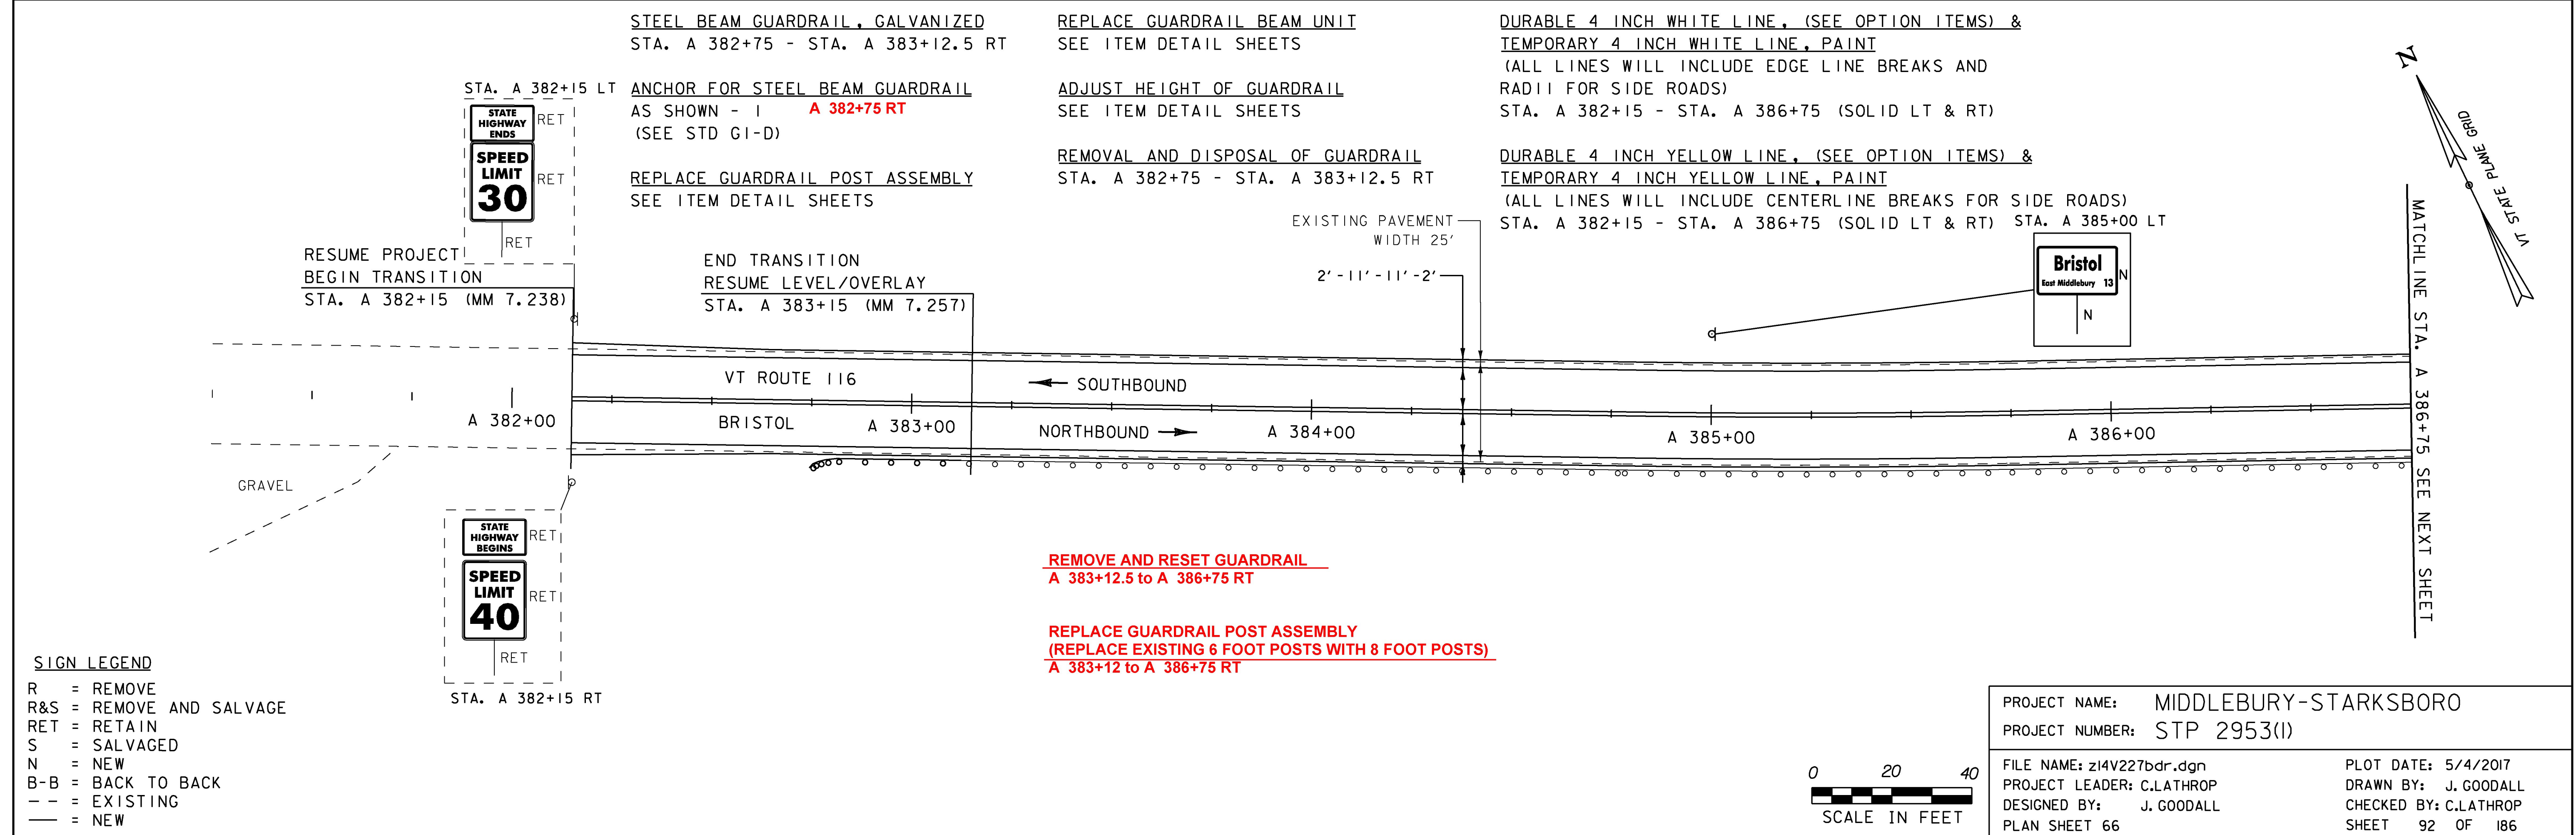

STEEL BEAM GUARDRAIL, GALVANIZED
 STA. A 382+75 - STA. A 383+12.5 RT

ANCHOR FOR STEEL BEAM GUARDRAIL
 AS SHOWN - I A 382+75 RT
 (SEE STD G1-D)

REPLACE GUARDRAIL POST ASSEMBLY
 SEE ITEM DETAIL SHEETS

REPLACE GUARDRAIL BEAM UNIT
 SEE ITEM DETAIL SHEETS

ADJUST HEIGHT OF GUARDRAIL
 SEE ITEM DETAIL SHEETS

REMOVAL AND DISPOSAL OF GUARDRAIL
 STA. A 382+75 - STA. A 383+12.5 RT

DURABLE 4 INCH WHITE LINE, (SEE OPTION ITEMS) &
 TEMPORARY 4 INCH WHITE LINE, PAINT
 (ALL LINES WILL INCLUDE EDGE LINE BREAKS AND
 RADI FOR SIDE ROADS)
 STA. A 382+15 - STA. A 386+75 (SOLID LT & RT)

DURABLE 4 INCH YELLOW LINE, (SEE OPTION ITEMS) &
 TEMPORARY 4 INCH YELLOW LINE, PAINT
 (ALL LINES WILL INCLUDE CENTERLINE BREAKS FOR SIDE ROADS)
 STA. A 382+15 - STA. A 386+75 (SOLID LT & RT)

RESUME PROJECT
 BEGIN TRANSITION
 STA. A 382+15 (MM 7.238)

END TRANSITION
 RESUME LEVEL/OVERLAY
 STA. A 383+15 (MM 7.257)

REMOVE AND RESET GUARDRAIL
 A 383+12.5 to A 386+75 RT

REPLACE GUARDRAIL POST ASSEMBLY
 (REPLACE EXISTING 6 FOOT POSTS WITH 8 FOOT POSTS)
 A 383+12 to A 386+75 RT

SIGN LEGEND
 R = REMOVE
 R&S = REMOVE AND SALVAGE
 RET = RETAIN
 S = SALVAGED
 N = NEW
 B-B = BACK TO BACK
 - - = EXISTING
 — = NEW



| | |
|-------------------------------------|-----------------------|
| PROJECT NAME: MIDDLEBURY-STARKSBORO | PLOT DATE: 5/4/2017 |
| PROJECT NUMBER: STP 2953(I) | DRAWN BY: J. GOODALL |
| FILE NAME: z14V227bdr.dgn | CHECKED BY: C.LATHROP |
| DESIGNED BY: J. GOODALL | SHEET 92 OF 186 |
| PLAN SHEET 66 | |