


DURABLE 4 INCH WHITE LINE, (SEE OPTION ITEMS) &  
 TEMPORARY 4 INCH WHITE LINE, PAINT  
 (ALL LINES WILL INCLUDE EDGE LINE BREAKS AND  
 RADII FOR SIDE ROADS)  
 STA. A 409+50 - STA. A 415+25 (SOLID LT & RT)

DURABLE 4 INCH YELLOW LINE, (SEE OPTION ITEMS) &  
 TEMPORARY 4 INCH YELLOW LINE, PAINT  
 (ALL LINES WILL INCLUDE CENTERLINE BREAKS FOR SIDE ROADS)  
 STA. A 409+50 - STA. A 415+25 (SOLID LT & RT)

STOP LEVEL/OVERLAY  
 BEGIN TRANSITION  
 STA. A 414+00 (MM 7.841)

END TRANSITION  
 RESUME COLD PLANE  
 STA. A 415+00 (MM 7.860)

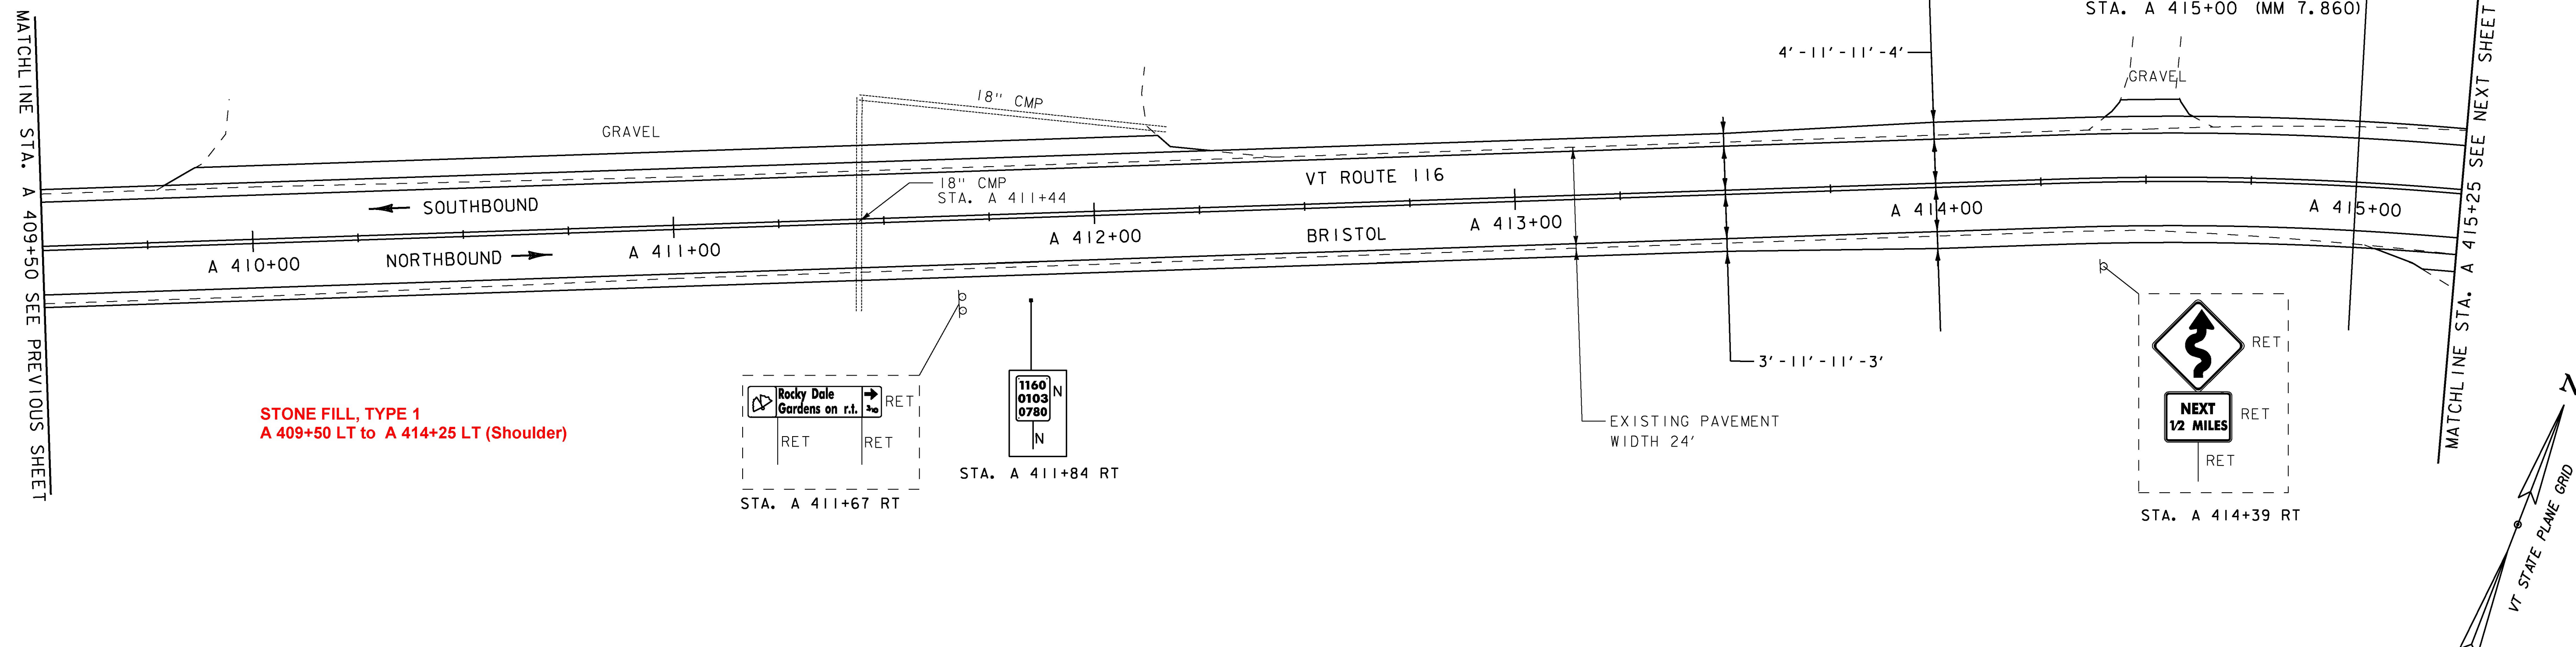


STONE FILL, TYPE 1  
 A 409+50 LT to A 414+25 LT (Shoulder)

REHAB DROP INLETS, CATCH BASINS, OR  
 MANHOLES, CLASS I, CLASS II, CLASS III  
~~STA. A 415+82 LT (GRATE TYPE D)~~  
 STA. A 415+82 RT (GRATE TYPE D)  
 STA. A 419+85 LT (GRATE TYPE D)  
~~STA. A 420+32 RT (GRATE TYPE D)~~

DURABLE 4 INCH WHITE LINE, (SEE OPTION ITEMS) &  
 TEMPORARY 4 INCH WHITE LINE, PAINT  
 (ALL LINES WILL INCLUDE EDGE LINE BREAKS AND  
 RADII FOR SIDE ROADS)  
 STA. A 415+25 - STA. A 420+75 (SOLID LT & RT)

DURABLE 4 INCH YELLOW LINE, (SEE OPTION ITEMS) &  
 TEMPORARY 4 INCH YELLOW LINE, PAINT  
 (ALL LINES WILL INCLUDE CENTERLINE BREAKS FOR SIDE ROADS)  
 STA. A 415+25 - STA. A 420+75 (SOLID LT & RT)

REMOVING SIGNS  
 AS SHOWN - 2

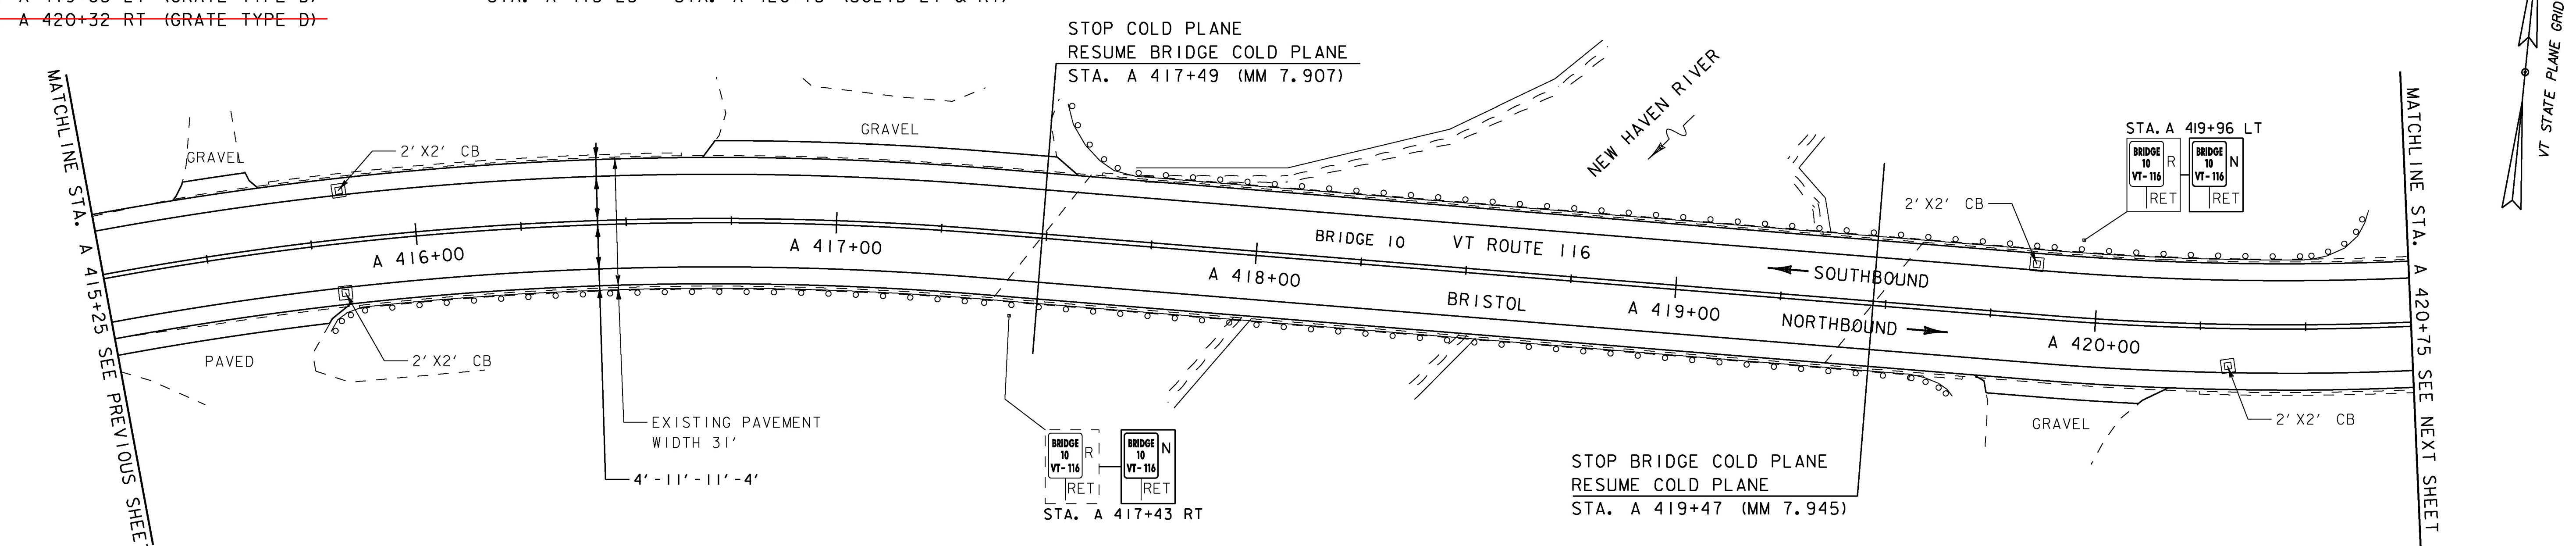

**SIGN LEGEND**  
 R = REMOVE  
 R&S = REMOVE AND SALVAGE  
 RET = RETAIN  
 S = SALVAGED  
 N = NEW  
 B-B = BACK TO BACK  
 - - = EXISTING  
 — = NEW



PROJECT NAME: MIDDLEBURY-STARKSBORO  
 PROJECT NUMBER: STP 2953(I)

FILE NAME: z14V227bdr.dgn  
 PROJECT LEADER: C.LATHROP  
 DESIGNED BY: J. GOODALL  
 PLAN SHEET 69

PLOT DATE: 5/4/2017  
 DRAWN BY: J. GOODALL  
 CHECKED BY: C.LATHROP  
 SHEET 95 OF 186