

MILLED RUMBLE STRIPS
STA. A 565+50 - STA. A 570+75 CTR

STEEL BEAM GUARDRAIL, GALVANIZED
STA. A 567+42.5 - STA. A 567+80 LT

REMOVE AND RESET GUARDRAIL
STA. A 565+50 - STA. A 567+42.5 LT

REPLACE GUARDRAIL POST ASSEMBLY
SEE ITEM DETAIL SHEETS

DURABLE 4 INCH WHITE LINE, (SEE OPTION ITEMS) &
TEMPORARY 4 INCH WHITE LINE, PAINT
(ALL LINES WILL INCLUDE EDGE LINE BREAKS AND
RADII FOR SIDE ROADS)
STA. A 565+50 - STA. A 570+75 (SOLID LT & RT)



REMOVING SIGNS
AS SHOWN - 1

ANCHOR FOR STEEL BEAM GUARDRAIL
AS SHOWN - 1
(SEE STD G1-D) **A 567+80 LT**

REPLACE GUARDRAIL BEAM UNIT
SEE ITEM DETAIL SHEETS

REMOVAL AND DISPOSAL OF GUARDRAIL
STA. A 567+42.5 - STA. A 567+80 LT

DURABLE 4 INCH YELLOW LINE, (SEE OPTION ITEMS) &
TEMPORARY 4 INCH YELLOW LINE, PAINT
(ALL LINES WILL INCLUDE CENTERLINE BREAKS FOR SIDE ROADS)
STA. A 565+50 - STA. A 567+00 (SOLID LT, DASHED RT)
STA. A 567+00 - STA. A 570+75 (SOLID LT & RT)

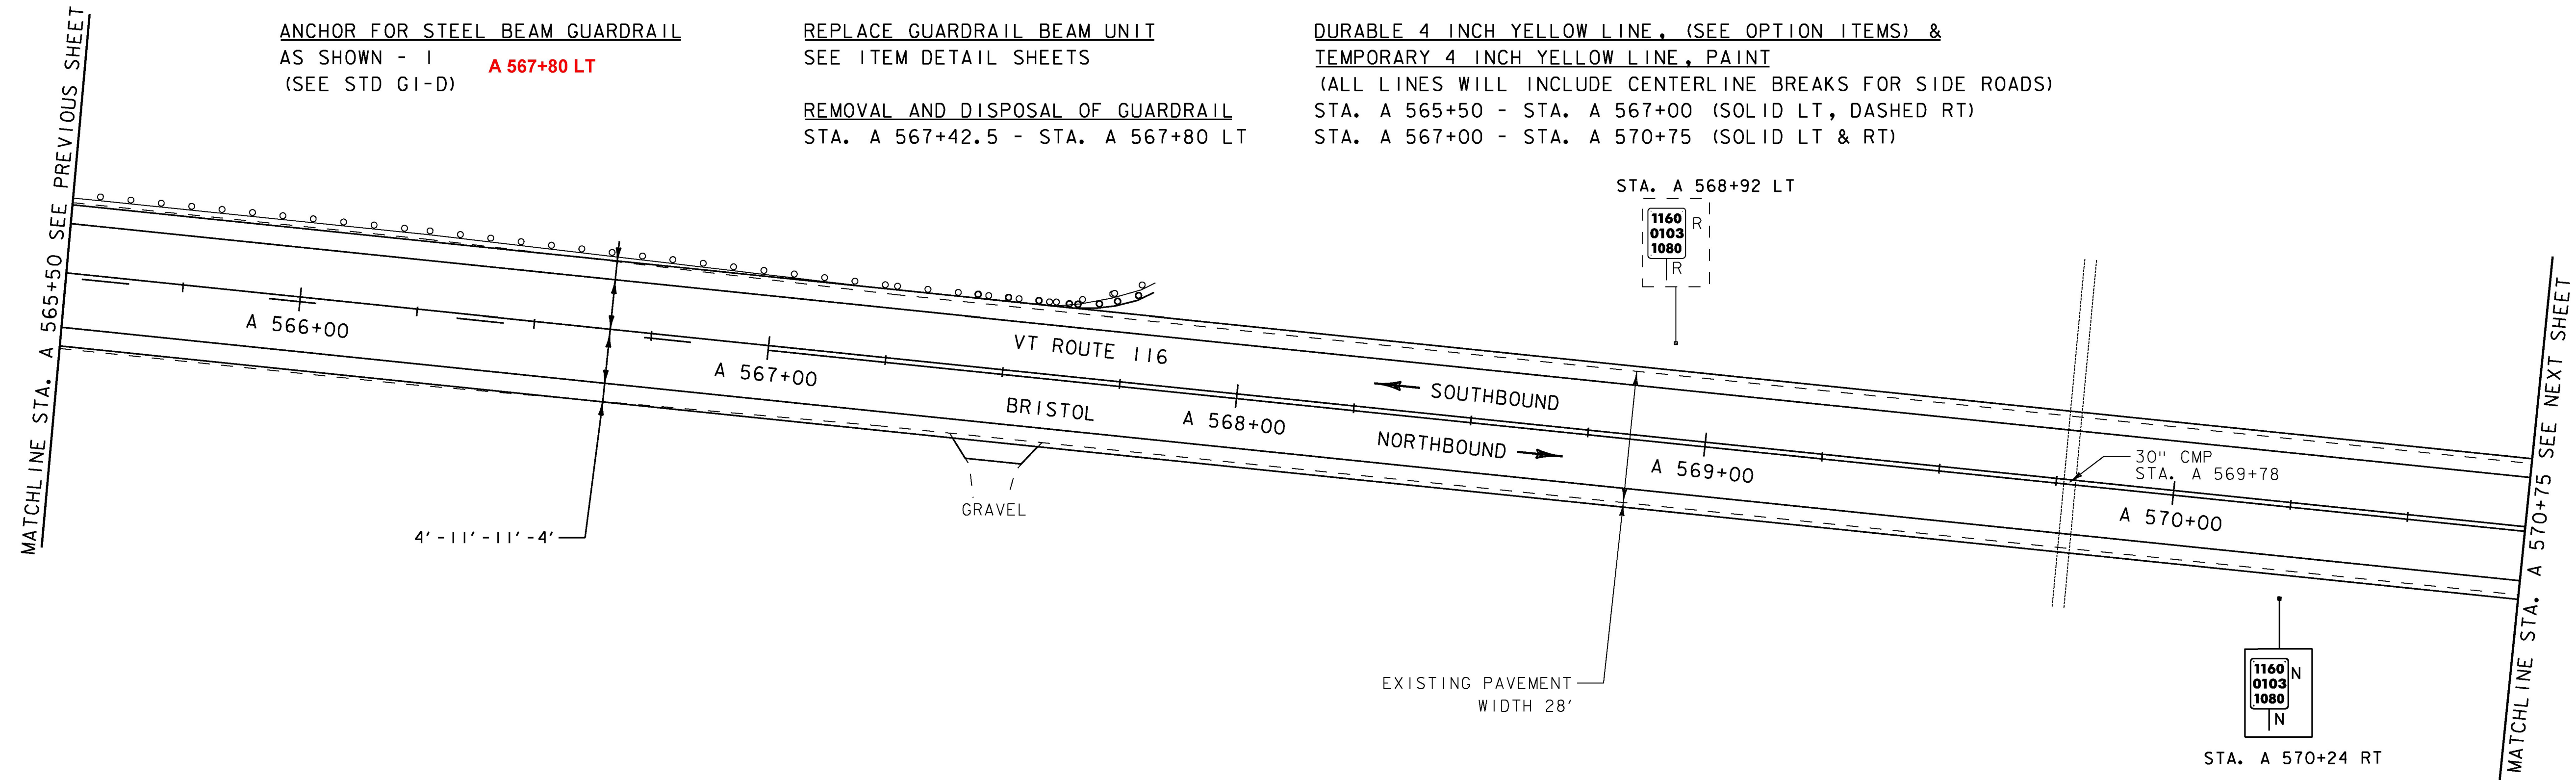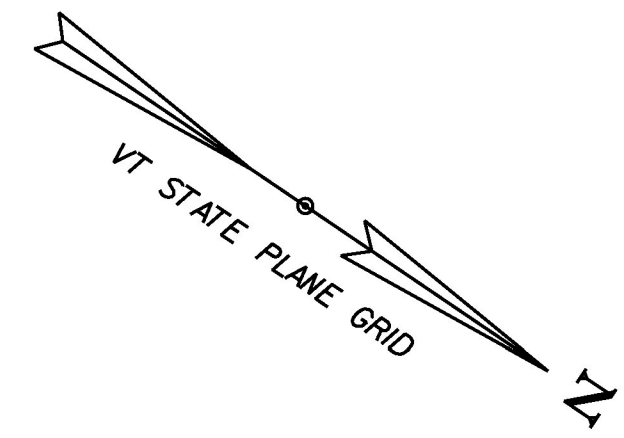

MILLED RUMBLE STRIPS
STA. A 570+75 - STA. A 573+00 CTR
STA. A 573+40 - STA. A 576+50 CTR



DURABLE 4 INCH YELLOW LINE, (SEE OPTION ITEMS) &
TEMPORARY 4 INCH YELLOW LINE, PAINT
(ALL LINES WILL INCLUDE CENTERLINE BREAKS FOR SIDE ROADS)
STA. A 570+75 - STA. A 576+50 (SOLID LT & RT)

DURABLE LETTERS OR SYMBOLS, (SEE OPTION ITEMS) &
TEMPORARY LETTERS OR SYMBOLS, PAINT
STA. A 573+33 RT (STOP)


REMOVING SIGNS
AS SHOWN - 2

DURABLE 4 INCH WHITE LINE, (SEE OPTION ITEMS) &
TEMPORARY 4 INCH WHITE LINE, PAINT
(ALL LINES WILL INCLUDE EDGE LINE BREAKS AND
RADII FOR SIDE ROADS)
STA. A 570+75 - STA. A 576+50 (SOLID LT & RT)

DURABLE 24 INCH STOP BAR, (SEE OPTION ITEMS) &
TEMPORARY 24 INCH STOP BAR, PAINT
STA. A 573+21 - STA. A 573+52 RT

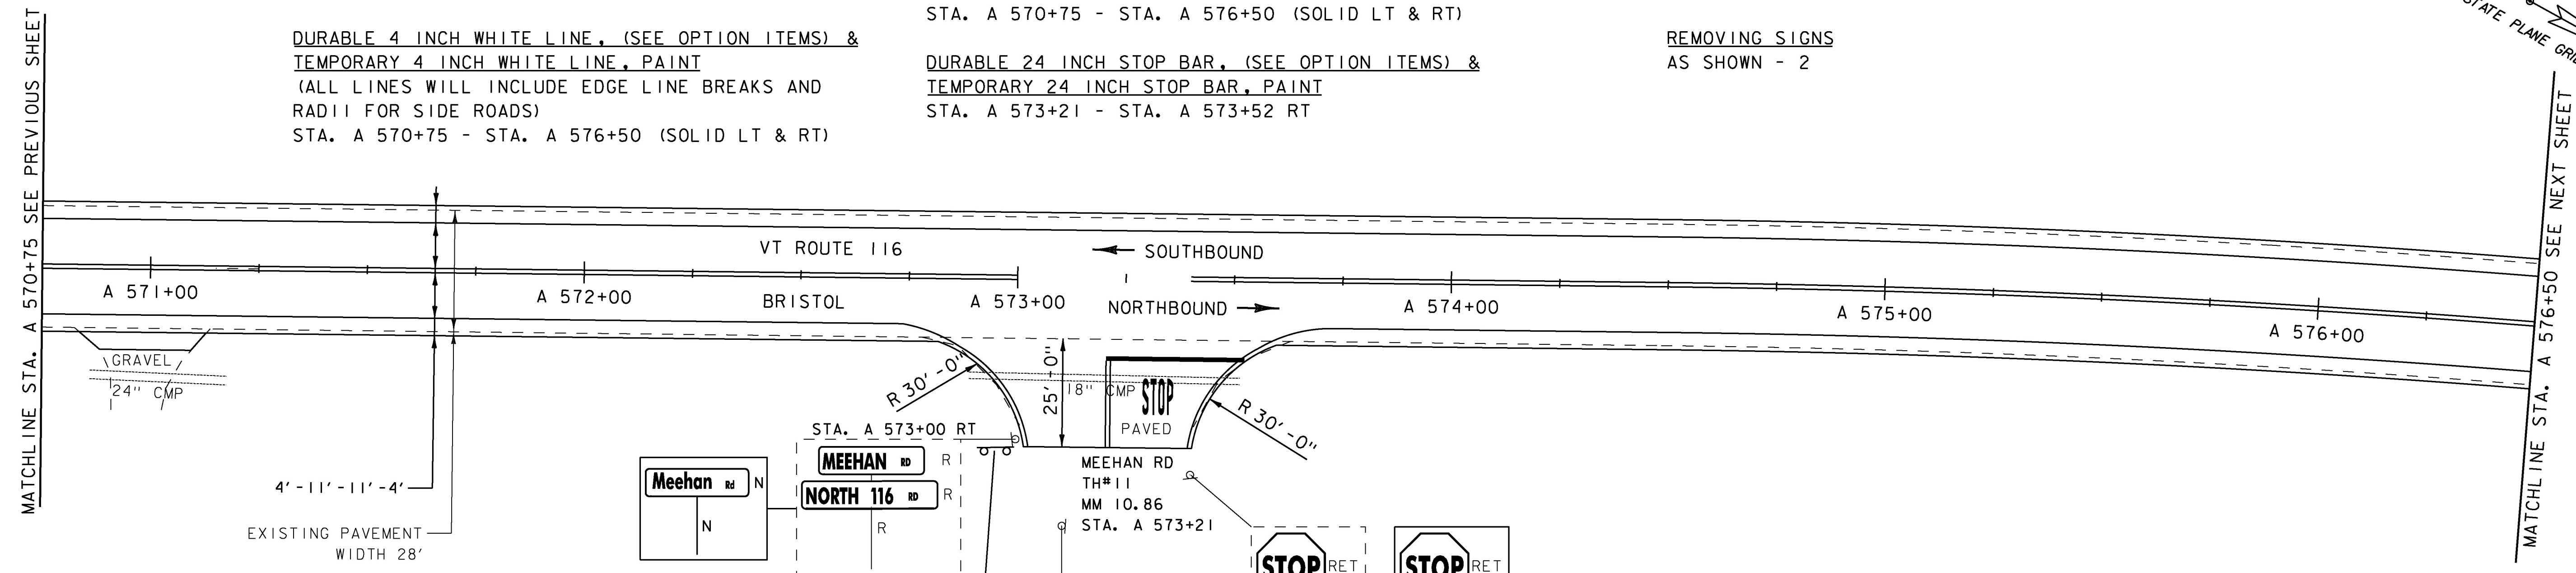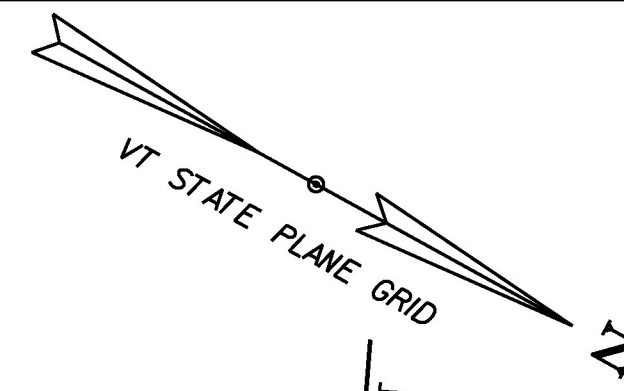

SIGN LEGEND
R = REMOVE
R&S = REMOVE AND SALVAGE
RET = RETAIN
S = SALVAGED
N = NEW
B-B = BACK TO BACK
- - = EXISTING
— = NEW

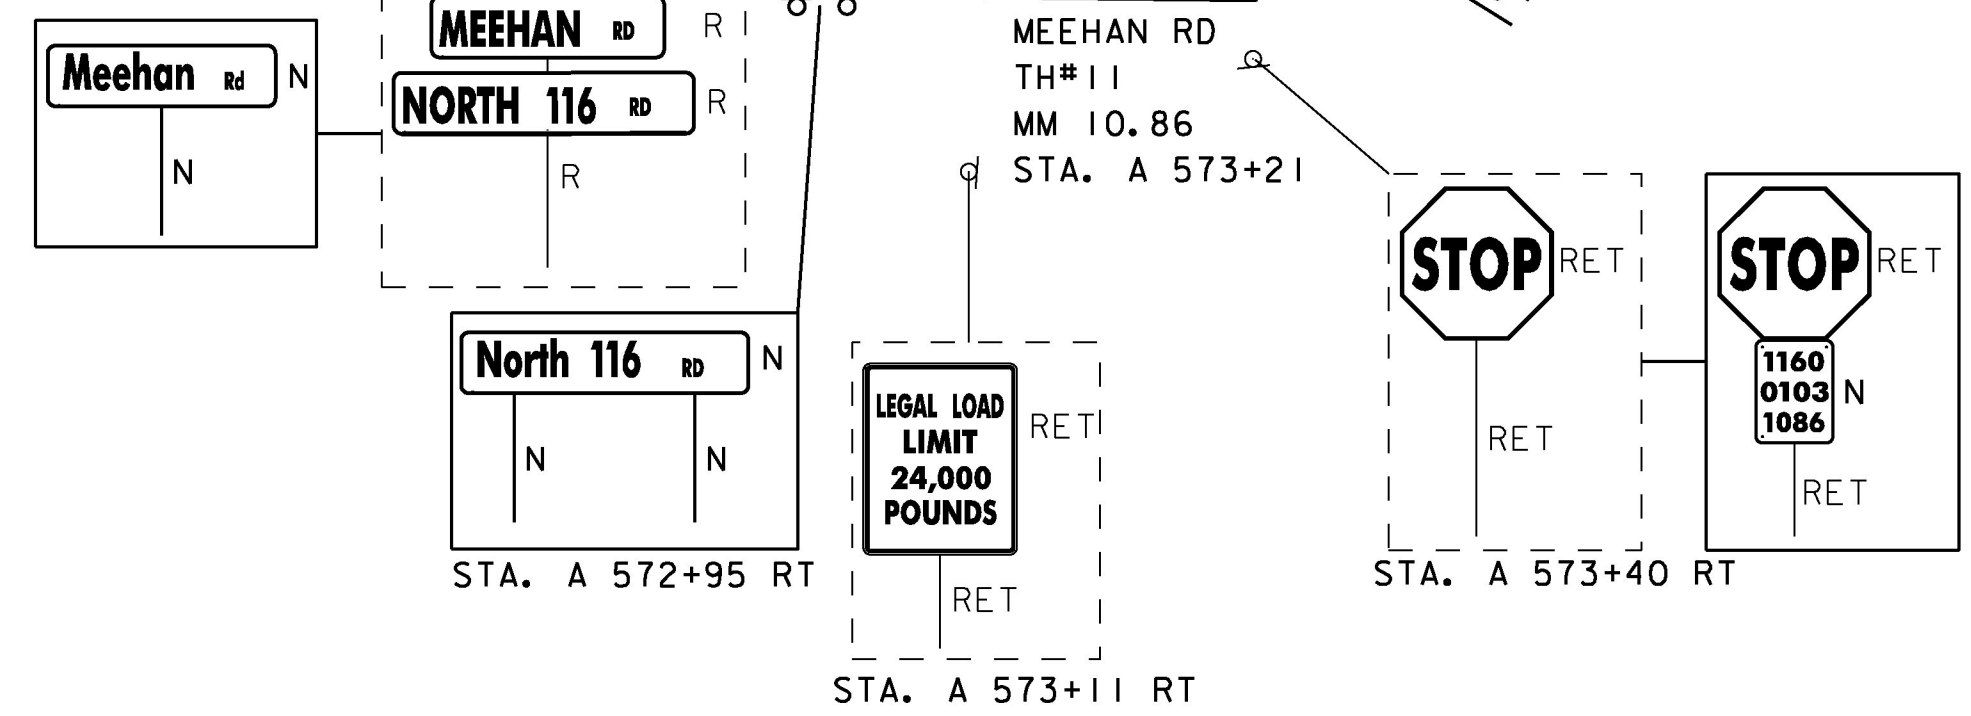

| | |
|-------------------------------------|-----------------------|
| PROJECT NAME: MIDDLEBURY-STARKSBORO | PLOT DATE: 5/4/2017 |
| PROJECT NUMBER: STP 2953(I) | DRAWN BY: J. GOODALL |
| FILE NAME: z14V227bdr.dgn | CHECKED BY: C.LATHROP |
| DESIGNED BY: J. GOODALL | SHEET 109 OF 186 |
| PLAN SHEET 83 | |