

MILLED RUMBLE STRIPS  
STA. B 62+25 - STA. B 65+75 CTR

STEEL BEAM GUARDRAIL, GALVANIZED  
STA. B 62+80 - STA. B 63+17.5 LT  
STA. B 64+40 - STA. B 64+77.5 RT  
STA. B 66+78.5 - STA. B 67+16 LT  
STA. B 65+48.5 - STA. B 65+86 RT

ANCHOR FOR STEEL BEAM GUARDRAIL  
AS SHOWN - 4 B 62+80 LT STA. B 63+36 LT  
(SEE STD G1-D) B 64+40 RT  
B 65+86 RT  
B 67+16 LT

REMOVE AND RESET GUARDRAIL  
STA. B 63+17.5 - STA. B 66+78.5 LT  
STA. B 64+77.5 - STA. B 65+48.5 RT  
+86 RT

REPLACE GUARDRAIL POST ASSEMBLY  
SEE ITEM DETAIL SHEETS


REPLACE GUARDRAIL BEAM UNIT  
SEE ITEM DETAIL SHEETS

REMOVAL AND DISPOSAL OF GUARDRAIL  
STA. B 62+80 - STA. B 63+17.5 LT  
STA. B 64+40 - STA. B 64+77.5 RT  
STA. B 66+78.5 - STA. B 67+16 LT  
STA. B 65+48.5 - STA. B 65+86 RT

DURABLE 4 INCH WHITE LINE, (SEE OPTION ITEMS) & TEMPORARY 4 INCH WHITE LINE, PAINT  
(ALL LINES WILL INCLUDE EDGE LINE BREAKS AND RADII FOR SIDE ROADS)  
STA. B 62+75 - STA. B 68+50 (SOLID LT & RT)


REMOVING SIGNS  
AS SHOWN - 1

DURABLE 4 INCH YELLOW LINE, (SEE OPTION ITEMS) & TEMPORARY 4 INCH YELLOW LINE, PAINT  
(ALL LINES WILL INCLUDE CENTERLINE BREAKS FOR SIDE ROADS)  
STA. B 62+75 - STA. B 68+25 (SOLID LT & RT)  
STA. B 68+25 - STA. B 68+50 (SOLID LT, DASHED RT)

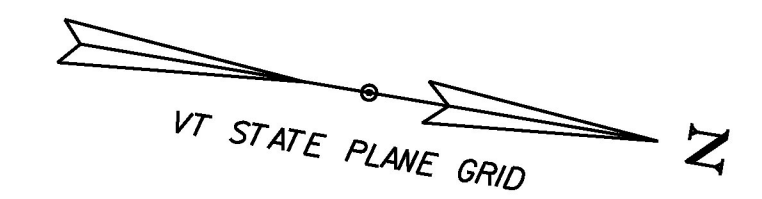

MATCHLINE STA. B 62+75 SEE PREVIOUS SHEET

MATCHLINE STA. B 68+50 SEE NEXT SHEET

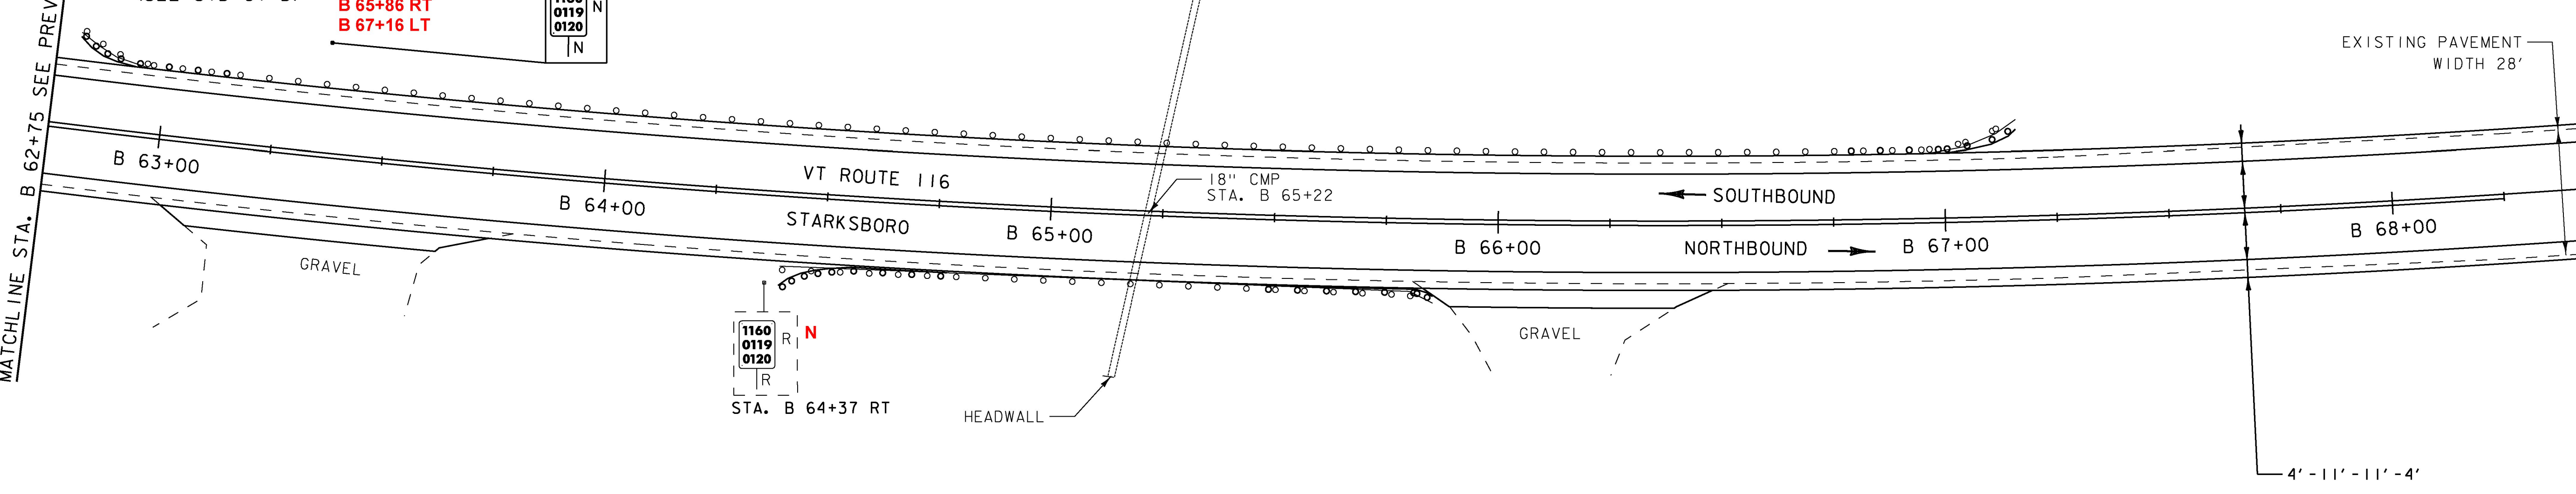

STEEL BEAM GUARDRAIL, GALVANIZED  
STA. B 70+30 - STA. B 70+67.5 RT  
STA. B 70+68 - STA. B 71+05.5 LT  
STA. B 72+87.5 - STA. B 73+25 RT  
STA. B 73+44.5 - STA. B 73+82 LT  
B 72+30.5 to B 72+68 LT

ANCHOR FOR STEEL BEAM GUARDRAIL  
AS SHOWN - 4 B 70+30 RT  
(SEE STD G1-D) B 70+68.5 LT  
B 72+68 LT  
B 73+25 RT

REMOVE AND RESET GUARDRAIL  
STA. B 70+67.5 - STA. B 72+87.5 RT  
STA. B 71+05.5 - STA. B 73+44.5 LT  
B 72+30.5 LT

REPLACE GUARDRAIL POST ASSEMBLY  
SEE ITEM DETAIL SHEETS


REPLACE GUARDRAIL BEAM UNIT  
SEE ITEM DETAIL SHEETS

REMOVAL AND DISPOSAL OF GUARDRAIL  
STA. B 70+30 - STA. B 70+67.5 RT  
STA. B 70+68 - STA. B 71+05.5 LT  
STA. B 72+87.5 - STA. B 73+25 RT  
STA. B 73+44.5 - STA. B 73+82 LT  
B 72+30.5 to B 72+68 LT

DURABLE 4 INCH WHITE LINE, (SEE OPTION ITEMS) & TEMPORARY 4 INCH WHITE LINE, PAINT  
(ALL LINES WILL INCLUDE EDGE LINE BREAKS AND RADII FOR SIDE ROADS)  
STA. B 68+50 - STA. B 74+25 (SOLID LT & RT)


DURABLE 4 INCH YELLOW LINE, (SEE OPTION ITEMS) & TEMPORARY 4 INCH YELLOW LINE, PAINT  
(ALL LINES WILL INCLUDE CENTERLINE BREAKS FOR SIDE ROADS)  
STA. B 68+50 - STA. B 74+25 (SOLID LT, DASHED RT)

REMOVING SIGNS  
AS SHOWN - 1

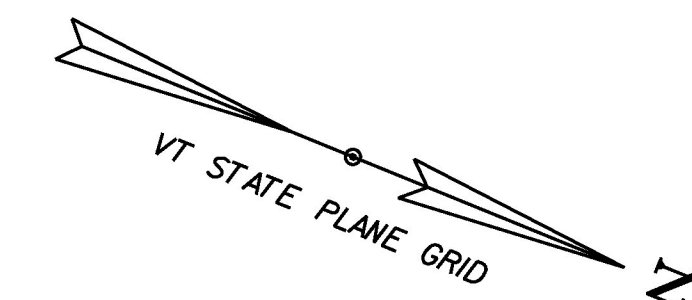

MATCHLINE STA. B 68+50 SEE PREVIOUS SHEET

MATCHLINE STA. B 74+25 SEE NEXT SHEET

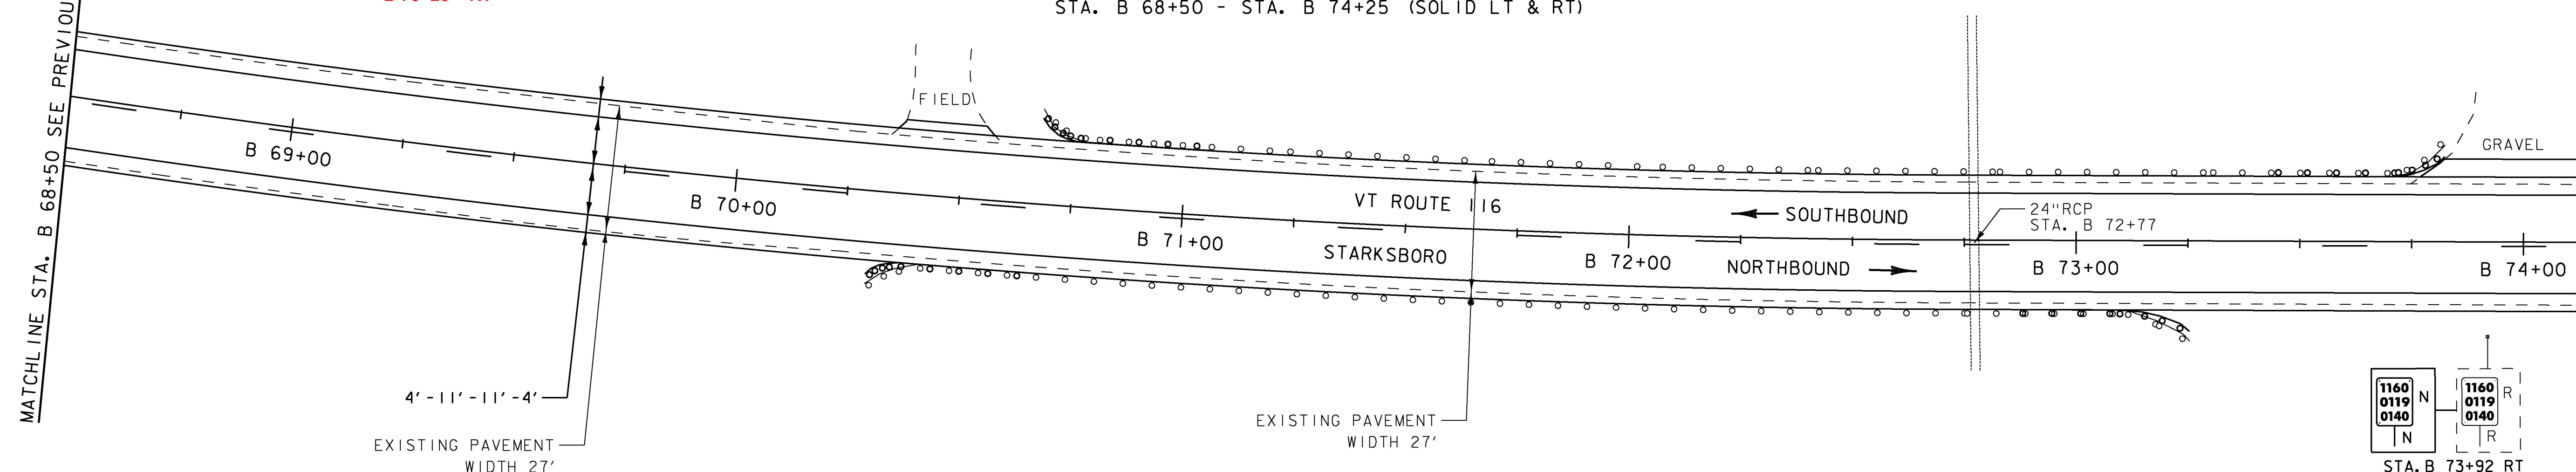

**SIGN LEGEND**  
R = REMOVE  
R&S = REMOVE AND SALVAGE  
RET = RETAIN  
S = SALVAGED  
N = NEW  
B-B = BACK TO BACK  
- - = EXISTING  
— = NEW



PROJECT NAME: MIDDLEBURY-STARKSBORO  
PROJECT NUMBER: STP 2953(I)

FILE NAME: z14V227bdr.dgn  
PROJECT LEADER: C.LATHROP  
DESIGNED BY: J. GOODALL  
PLAN SHEET 96

PLOT DATE: 5/4/2017  
DRAWN BY: J. GOODALL  
CHECKED BY: C.LATHROP  
SHEET 122 OF 186