


WP NO.	NORTHING	EASTING
1	540455.19	1481055.81
2	540449.09	1481083.79
3	540442.41	1481114.45


WORKING POINTS

NOTE: CONTRACTOR SHALL VERIFY ALL SURVEY CONTROL AND ELEVATIONS WITH THE ENGINEER PRIOR TO CONSTRUCTION.

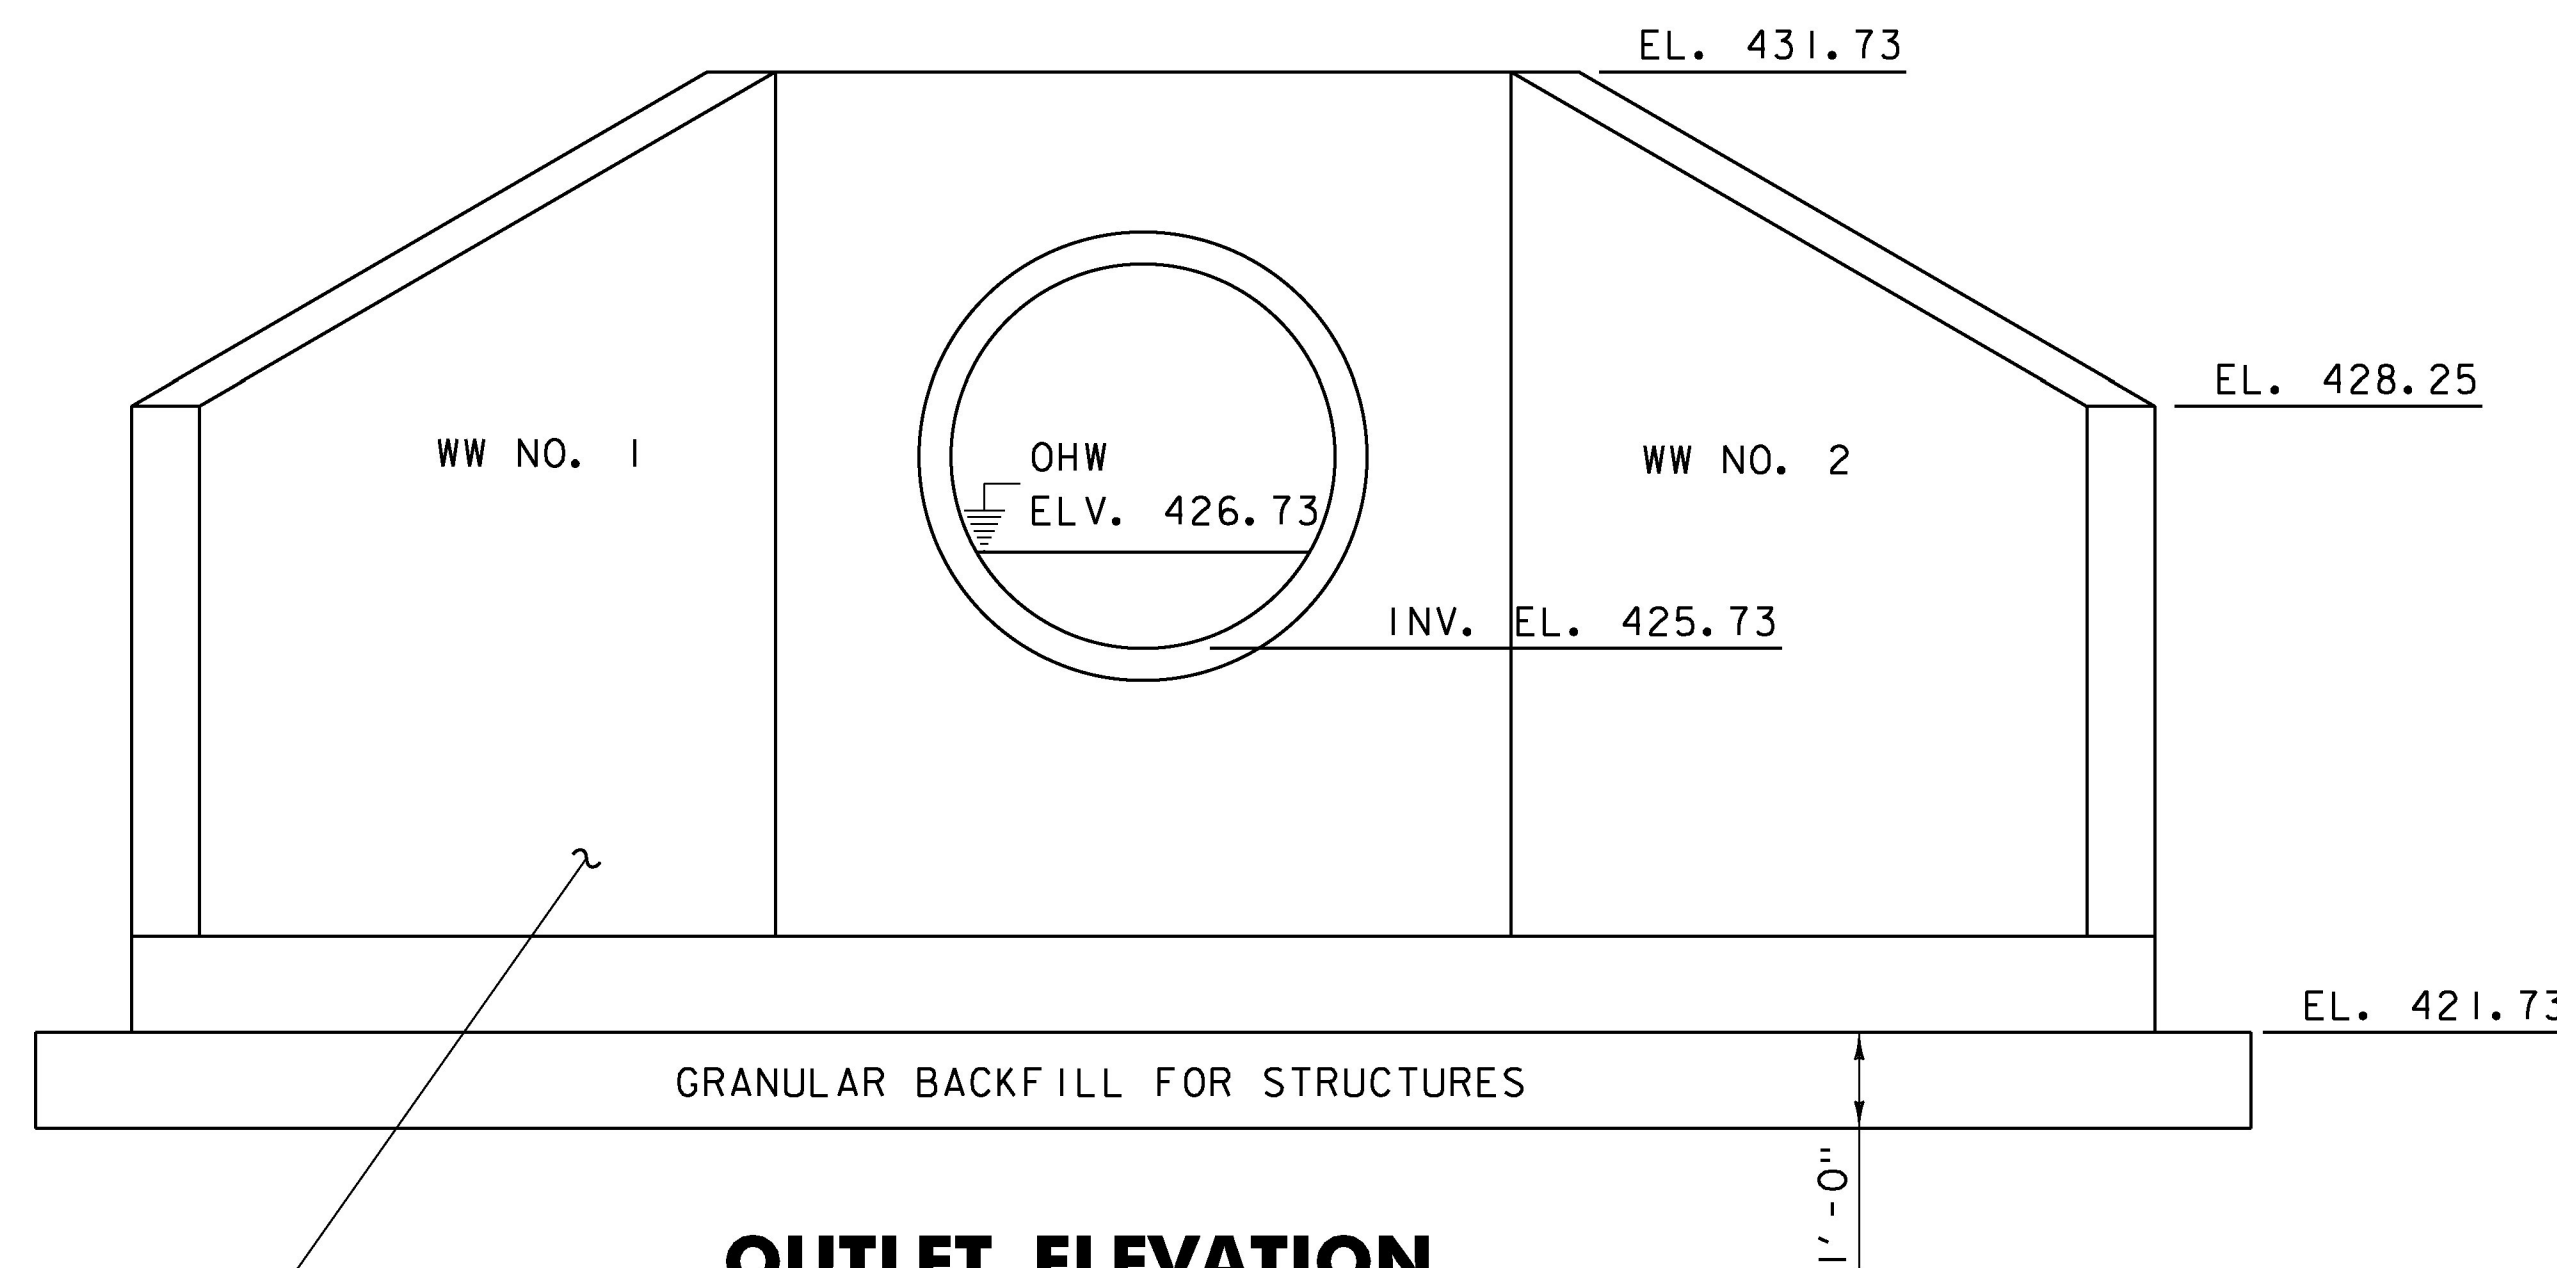

OUTLET ELEVATION

SCALE 1/2" = 1'-0"

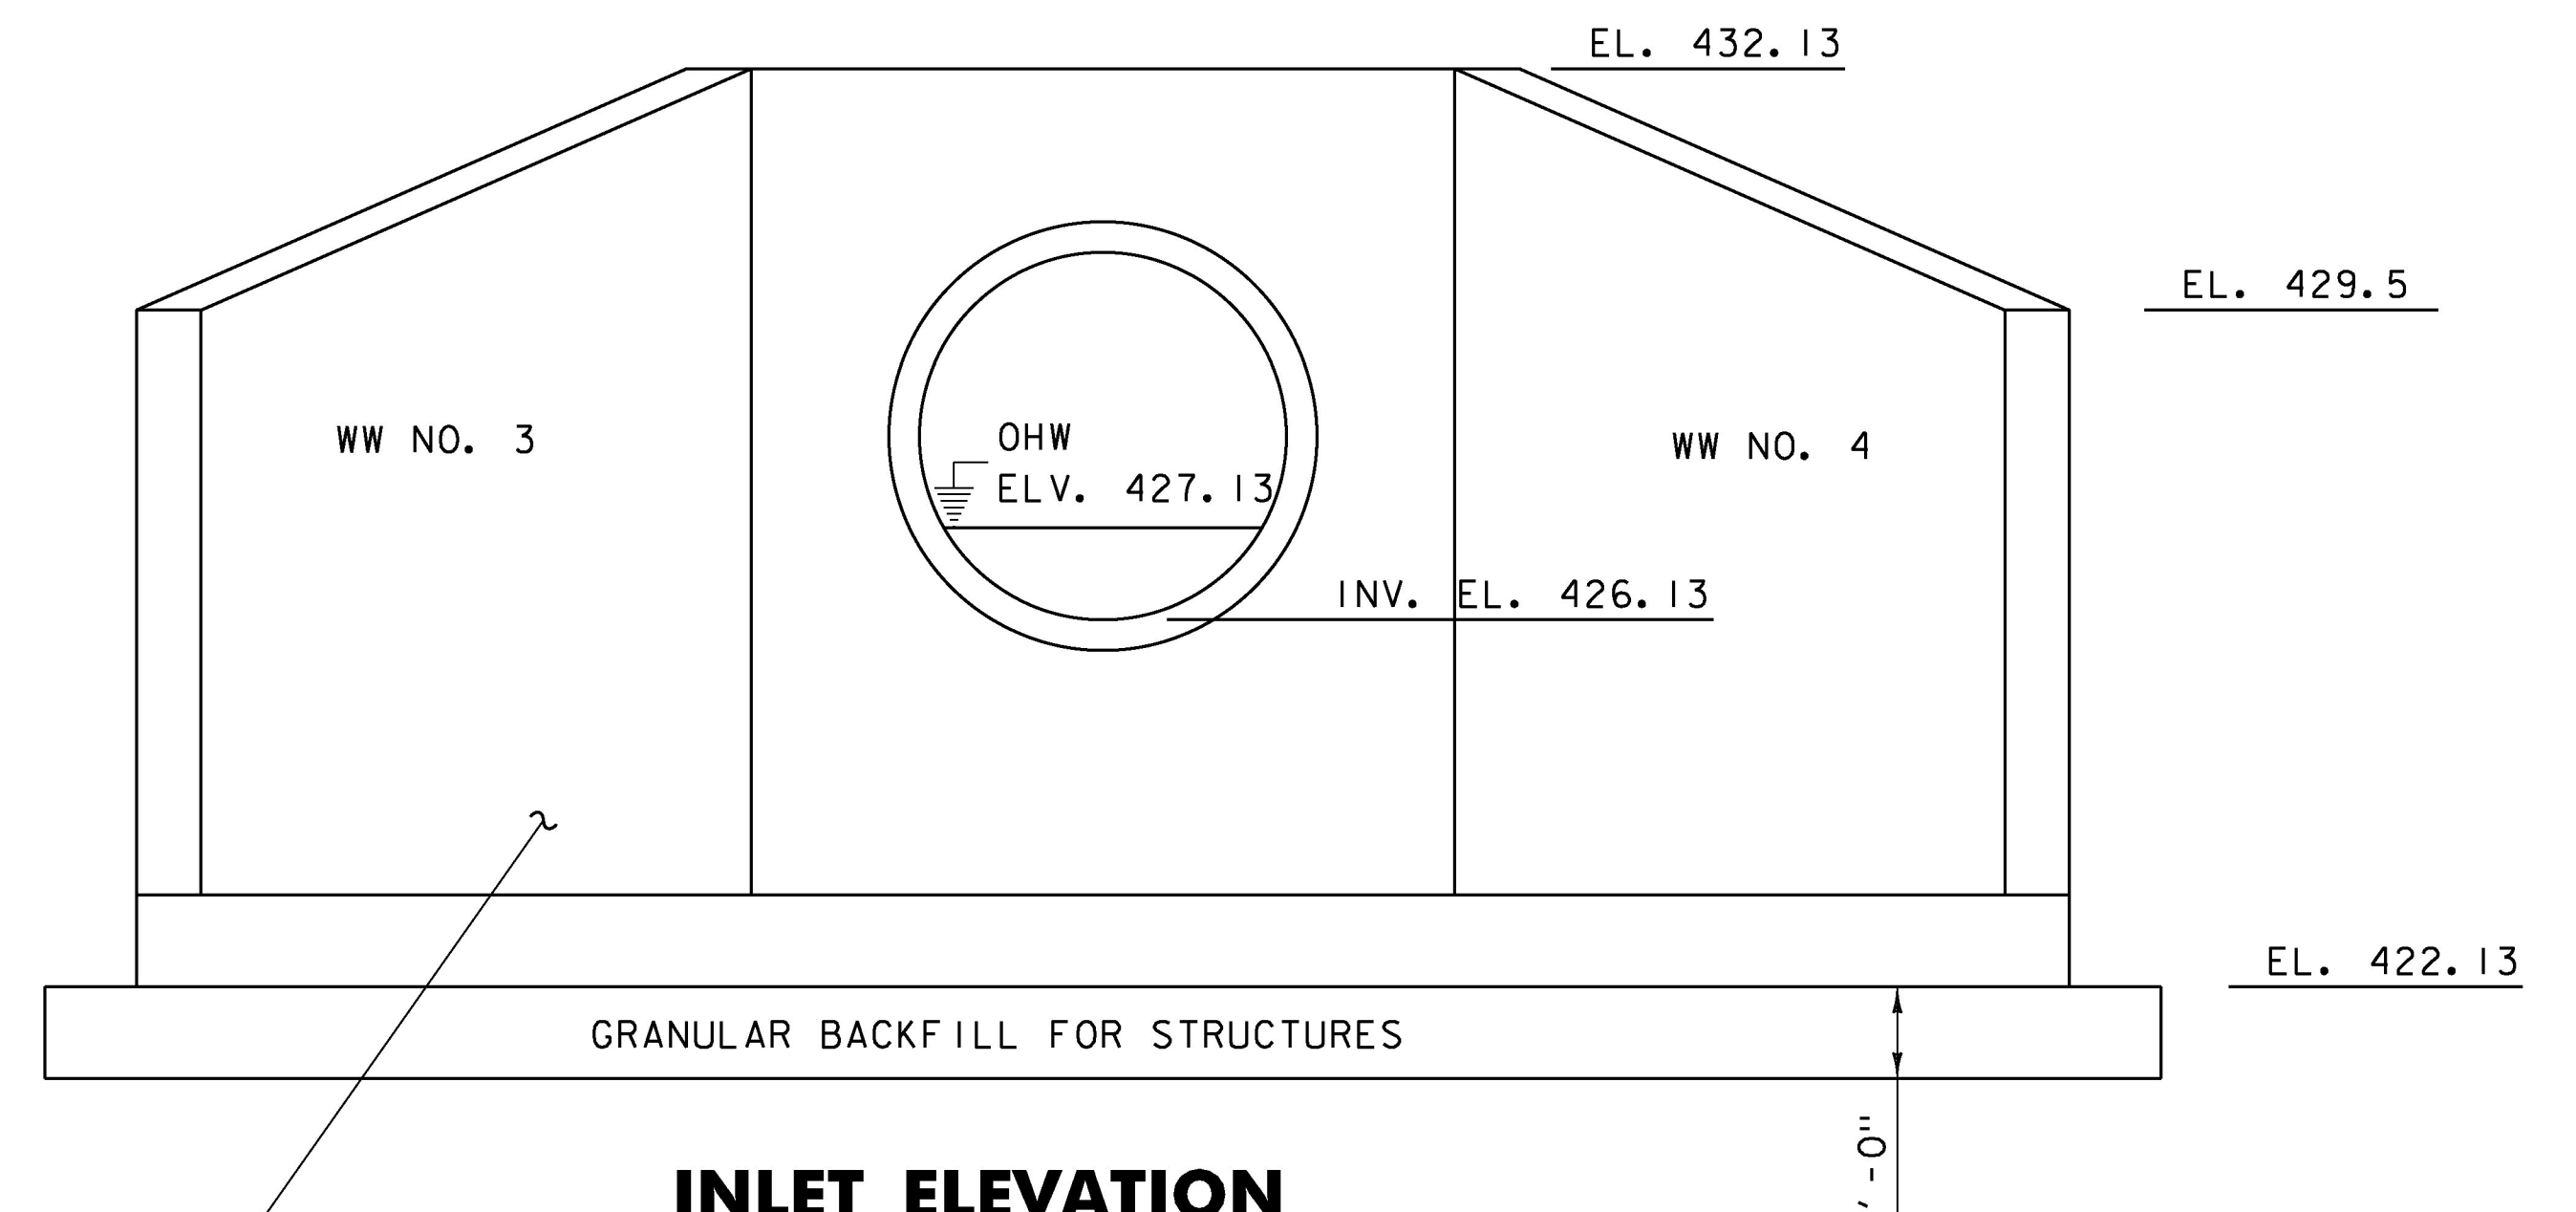

INLET ELEVATION

SCALE 1/2" = 1'-0"

A 36" CULVERT WAS INSTALLED INSTEAD OF THE 48" CULVERT CHANGE ORDER #3

CONCRETE HEADWALL, CUTOFF WALL, AND WINGWALLS

CONCRETE HEADWALL, CUTOFF WALL, AND WINGWALLS

PROJECT NAME: MIDDLEBURY-STARKSBORO	PLOT DATE: 5/4/2017
PROJECT NUMBER: STP 2953(1)	DRAWN BY: S.SOLLA
FILE NAME: z14V227mml131str.dgn	CHECKED BY: C.LATHROP
PROJECT LEADER: C.LATHROP	SHEET 126 OF 186
DESIGNED BY: S.SOLLA	

MIDDLEBURY