


SOIL DESIGNATION	SLOPES	HYDROLOGIC GROUP CLASSIFICATION	SOIL ERODIBILITY COEFFICIENTS (K)
AdB= ADAMS LOAMY FINE SAND	5-12%	A	.17
AdD= ADAMS LOAMY FINE SAND	12-30%	A	.17
EIB= ELMWOOD FINE SANDY LOAM, COARSE VARIANT	0-8%	C/D	.15
SaE= SALMON VERY FINE SANDY LOAM	12-50%	B	.49

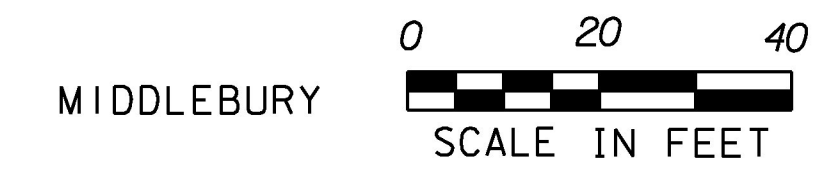

PROJECT NAME: MIDDLEBURY-STARKSBORO	PLOT DATE: 5/4/2017
PROJECT NUMBER: STP 2953(I)	DRAWN BY: S.SOLLA
FILE NAME: z14V227mml131erobdr.dgn	CHECKED BY: C.LATHROP
DESIGNED BY: S.SOLLA	SHEET 130 OF 186
EPSC EXISTING CONDITIONS PLAN SHEET	