

# STATE OF VERMONT AGENCY OF TRANSPORTATION




## PROPOSED IMPROVEMENT TOWNS OF WORCESTER AND ELMORE COUNTIES OF WASHINGTON AND LAMOILLE VT ROUTE 12 (MAJOR COLLECTOR)

BEGINNING IN THE TOWN OF WORCESTER ON VT ROUTE 12 AT MM 4.972 AND EXTENDING NORTHERLY  
ALONG VT ROUTE 12 FOR A DISTANCE OF APPROXIMATELY 500.00 FEET (0.095 MILES) AND STOPPING AT MM 5.066 IN THE TOWN OF WORCESTER.  
RESUMING IN THE TOWN OF WORCESTER ON VT ROUTE 12 AT MM 5.828 AND EXTENDING NORTHERLY  
ALONG VT ROUTE 12 FOR A DISTANCE OF APPROXIMATELY 19,188.87 FEET (3.634 MILES) AND STOPPING AT MM 1.609 IN THE TOWN OF ELMORE.  
RESUMING IN THE TOWN OF ELMORE ON VT ROUTE 12 AT MM 2.017 AND EXTENDING NORTHERLY  
ALONG VT ROUTE 12 FOR A DISTANCE OF APPROXIMATELY 450.00 FEET (0.086 MILES) AND ENDING AT MM 2.102 IN THE TOWN OF ELMORE.


LENGTH OF ROADWAY = 19,188.87 FEET (3.634 MILES)  
LENGTH OF PROJECT = 20,038.87 FEET (3.795 MILES)

WORK TO BE PERFORMED UNDER THIS PROJECT INCLUDES SURFACE PREPARATION INVOLVING PATCHING, POT HOLE REPAIR, CRACK SEALING, COLD PLANING, MICRO-MILLING, PAVING, RECLAIMING, ROADWAY CRACK TREATMENTS, TRAFFIC MARKINGS AND OTHER HIGHWAY RELATED ITEMS.

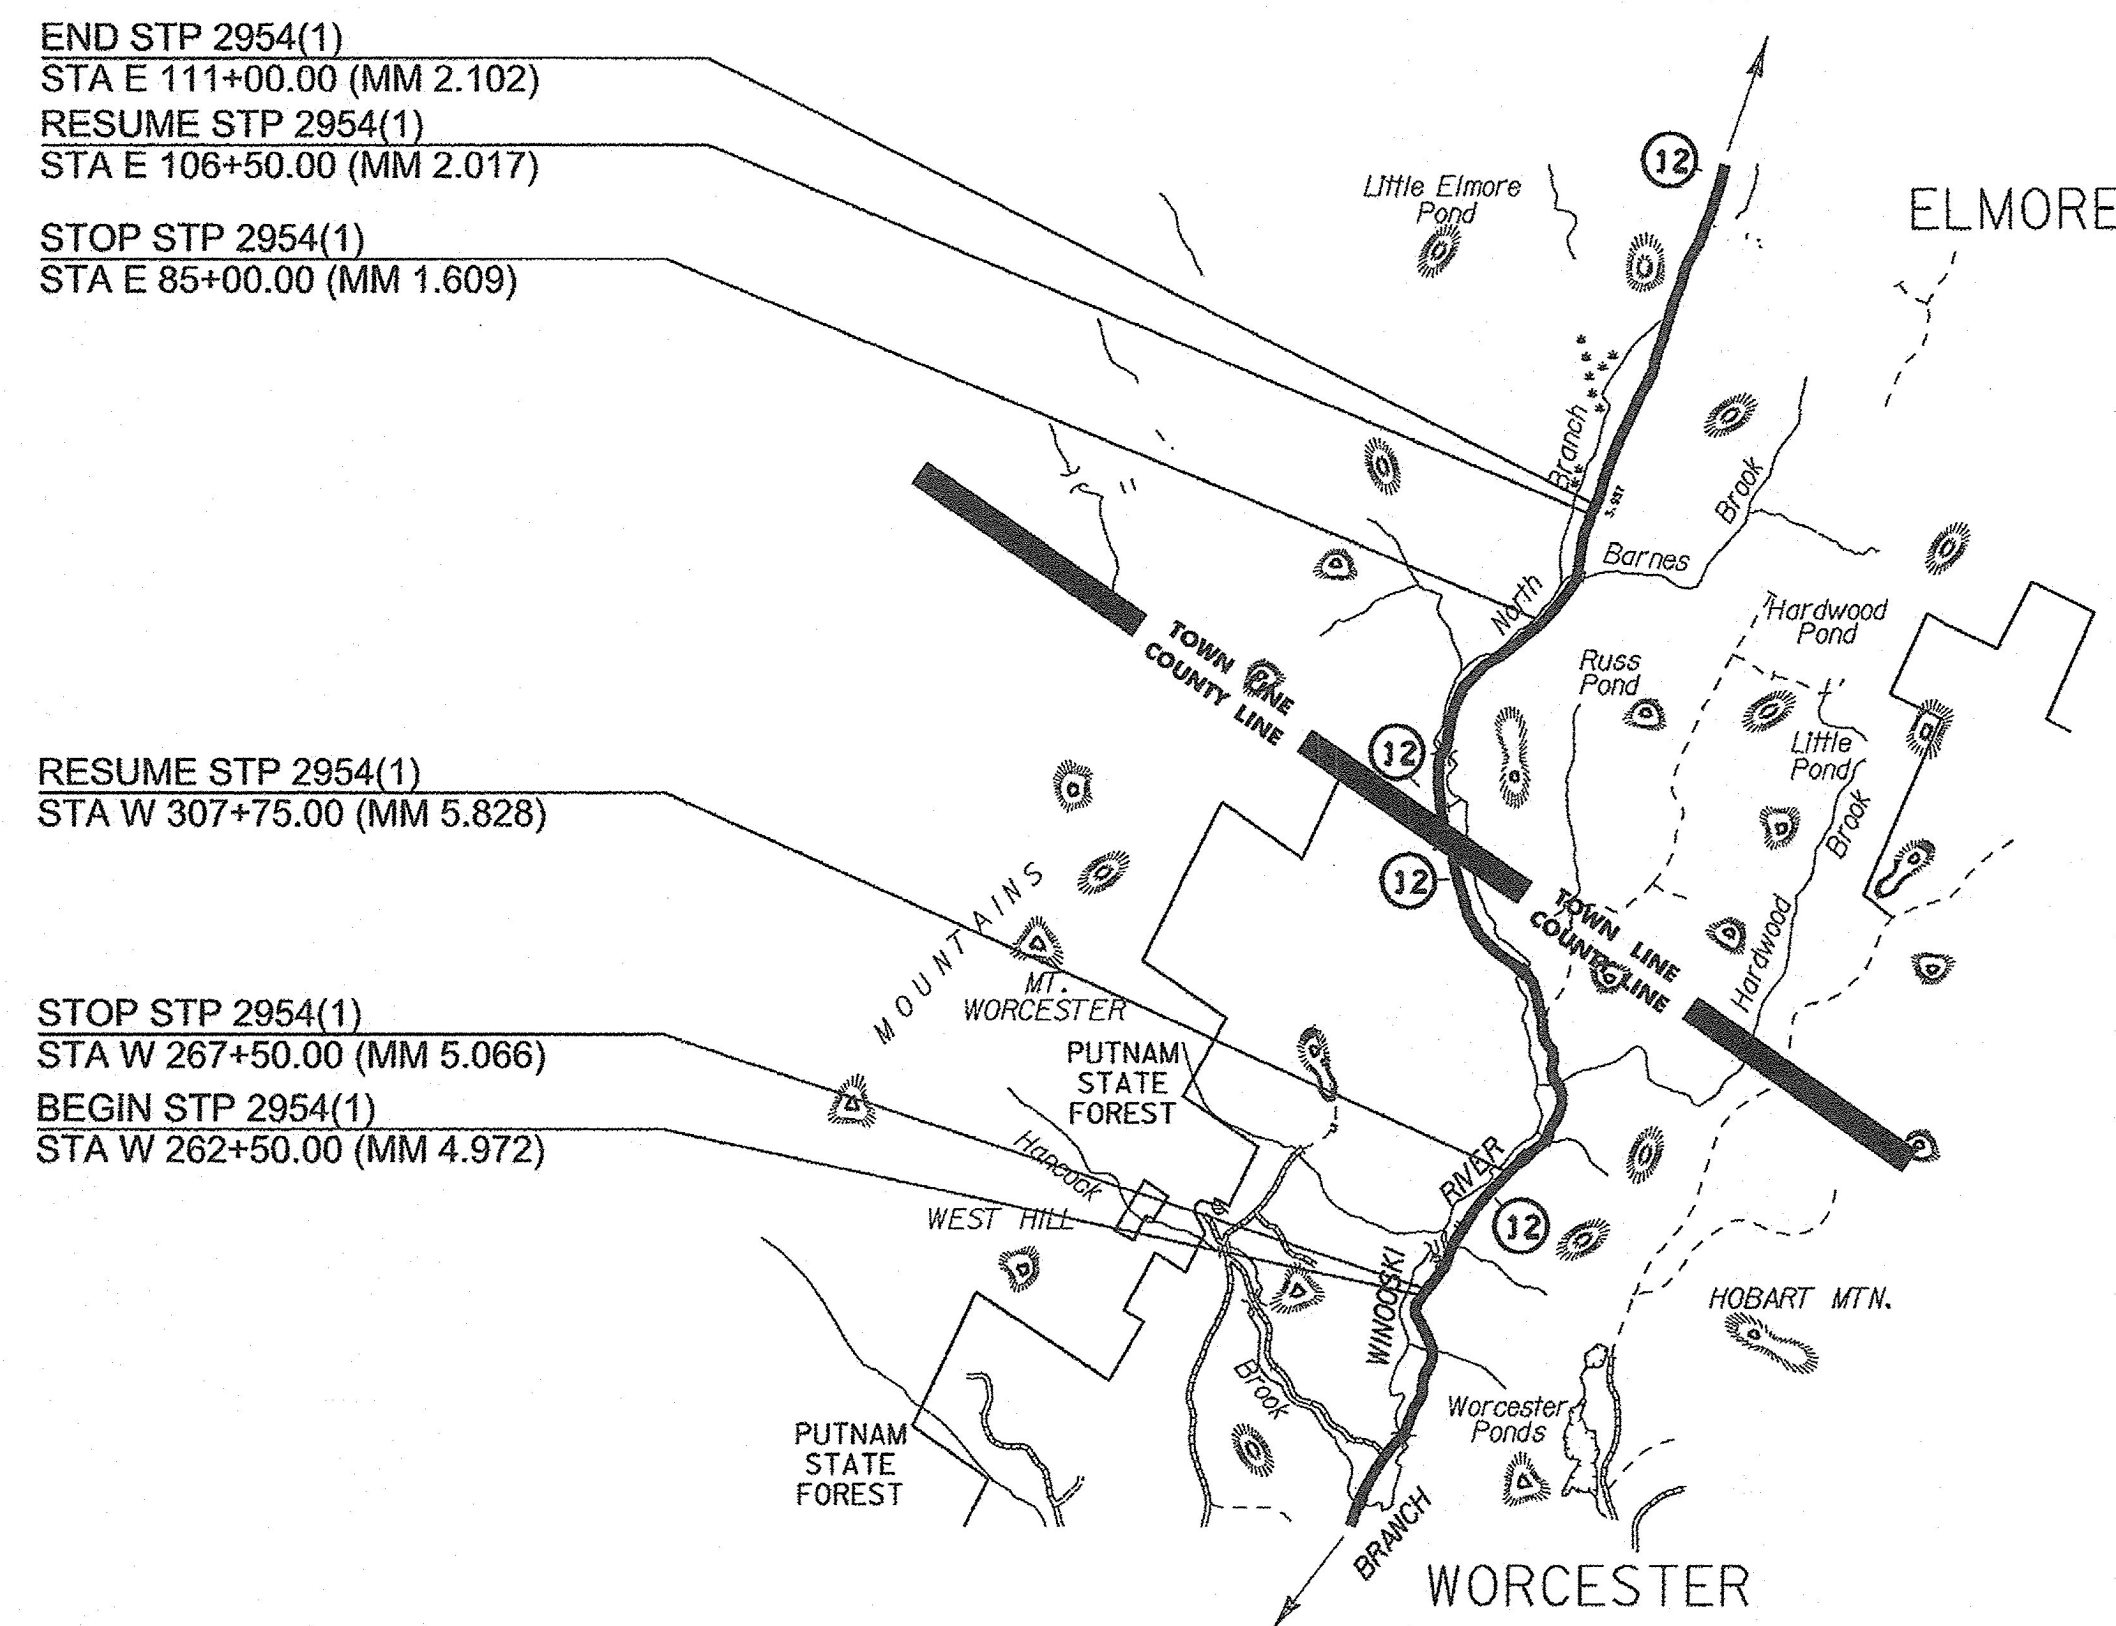

NOT TO SCALE

RECORD PLANS	
CONTRACTOR:	PIKE INDUSTRIES, INC. - BERLIN, VT
RESIDENT ENGINEER:	JEFF COTA
CONSTRUCTION BEGAN:	AUGUST 30, 2016
CONSTRUCTION COMPLETE:	NOVEMBER 09, 2016
RECORD PLANS BY:	JEFF COTA & AARON WEAVER
I HEREBY CERTIFY THAT ALL THE CONSTRUCTION REQUIRED BY THIS SET OF DRAWINGS HAS BEEN ACCOMPLISHED AS INDICATED HEREIN.	
BY:	RESIDENT ENGINEER
DATE:	6/6/18
NOTE: Any further information concerning final quantities, amounts or other details relative to this project may be found by contacting Vtrans Records Management.	

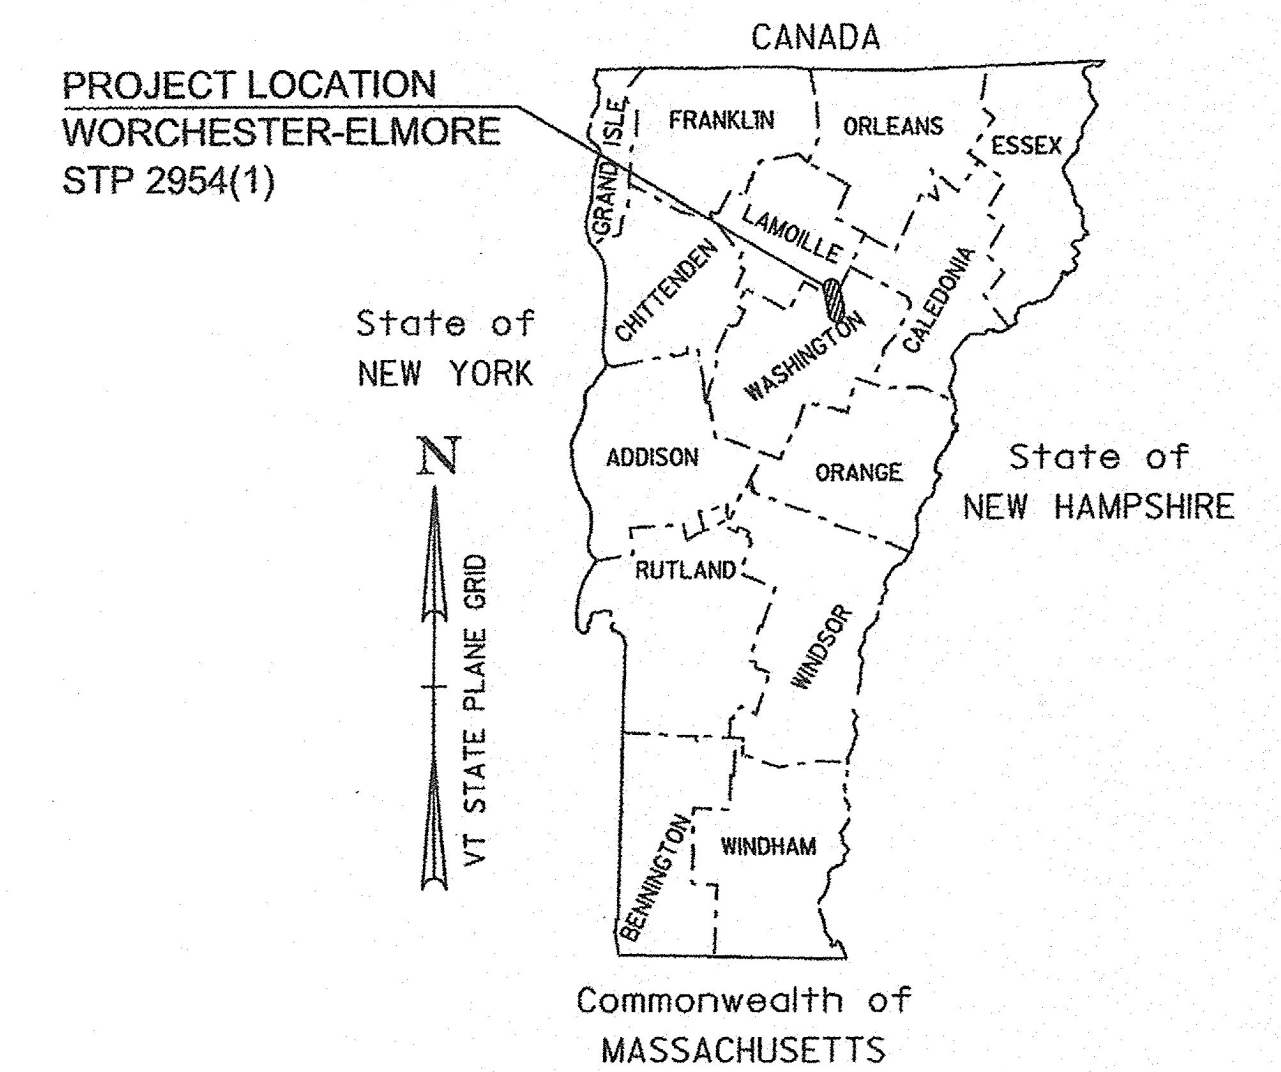

CONSTRUCTION IS TO BE CARRIED ON IN ACCORDANCE WITH THESE PLANS AND THE STANDARD SPECIFICATIONS FOR CONSTRUCTION DATED 2011, AS APPROVED BY THE FEDERAL HIGHWAY ADMINISTRATION ON JULY 20, 2011 FOR USE ON THIS PROJECT, INCLUDING ALL SUBSEQUENT REVISIONS AND SUCH REVISED SPECIFICATIONS AND SPECIAL PROVISIONS AS ARE INCORPORATED IN THESE PLANS.

QUALITY ASSURANCE PROGRAM : LEVEL 2	
SURVEYED BY:	NA
SURVEYED DATE:	NA
DATUM	
VERTICAL	NA
HORIZONTAL	NA

STATION LEGEND: W = WORCESTER  
E = ELMORE

DIRECTOR OF PROJECT DELIVERY	
APPROVED	DATE 5/9/2018
PROJECT MANAGER : JONATHAN C. HARRINGTON, P.E.	
PROJECT NAME : WORCESTER-ELMORE	
PROJECT NUMBER : STP 2954(1)	
SHEET 1 OF 33 SHEETS	