



CRACK TREATMENT DETAIL - NO. 1

NOT TO SCALE
WORCESTER:
(SEE PLAN SHEET 1 FOR LOCATIONS)

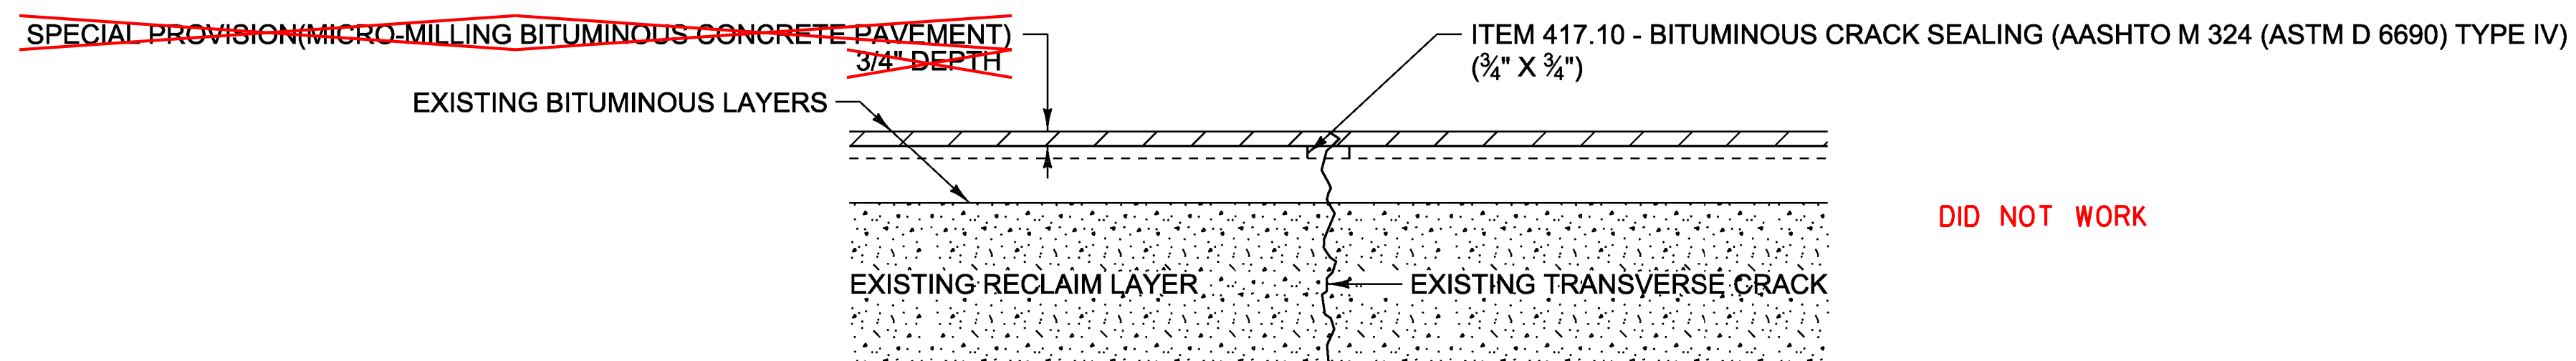

CRACK TREATMENT DETAIL - NO. 2

NOT TO SCALE
WORCESTER:
(SEE PLAN SHEET 1 FOR LOCATIONS)

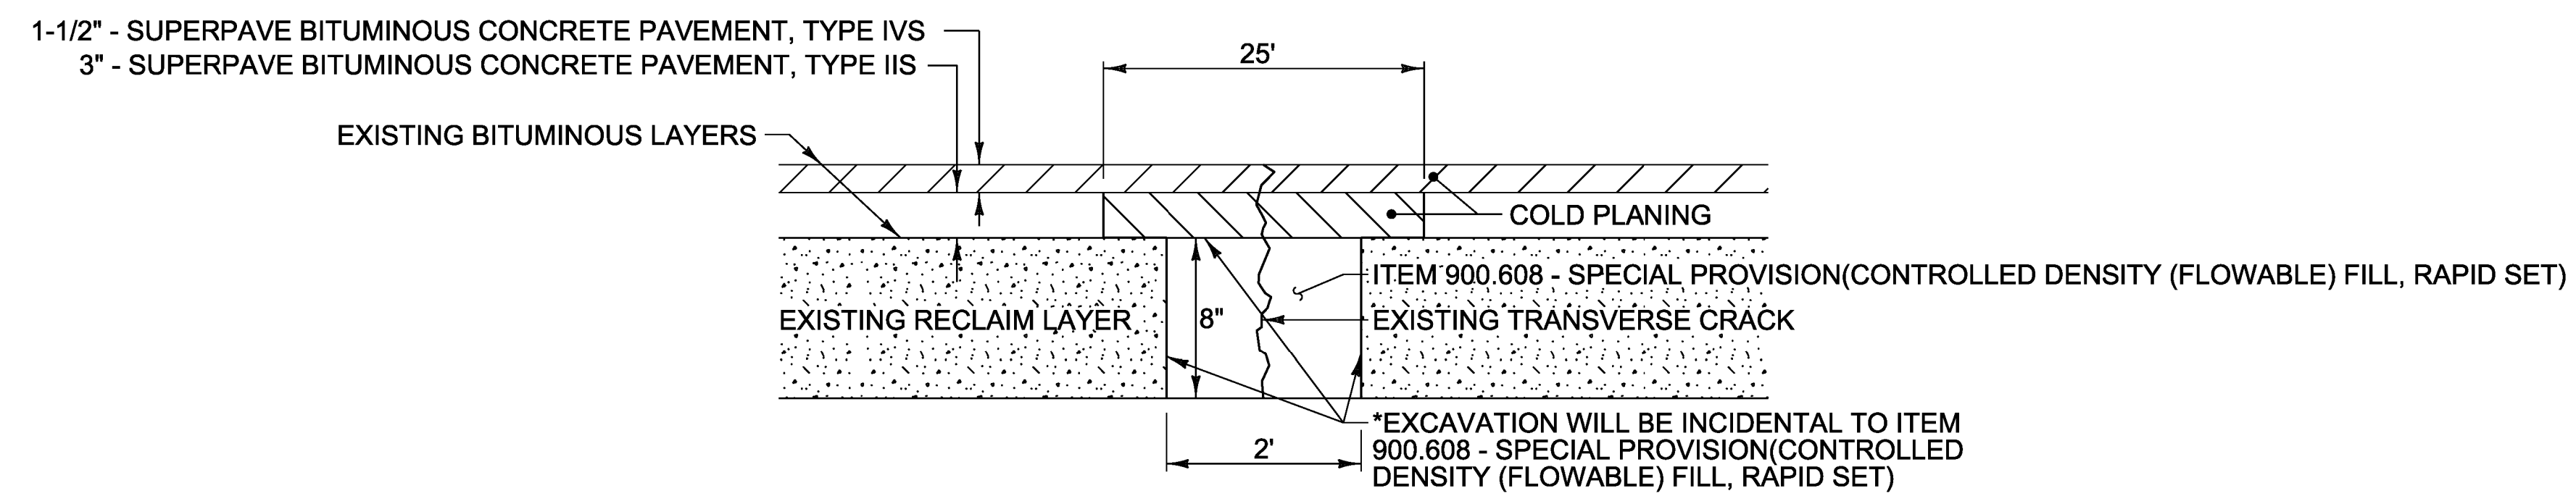

CRACK TREATMENT DETAIL - NO. 3

NOT TO SCALE
ELMORE:
(SEE PLAN SHEET 20 FOR LOCATIONS)

PROJECT NAME: WORCESTER-ELMORE
PROJECT NUMBER: STP 2954(I)

FILE NAME: pl4v231wrk.dgn
PROJECT LEADER: J. HARRINGTON
DESIGNED BY: B. KIPP
DETAIL SHEET 1

PLOT DATE: 13-MAY-2016
DRAWN BY: B. KIPP
CHECKED BY: N. PAPPAS
SHEET 6 OF 33