
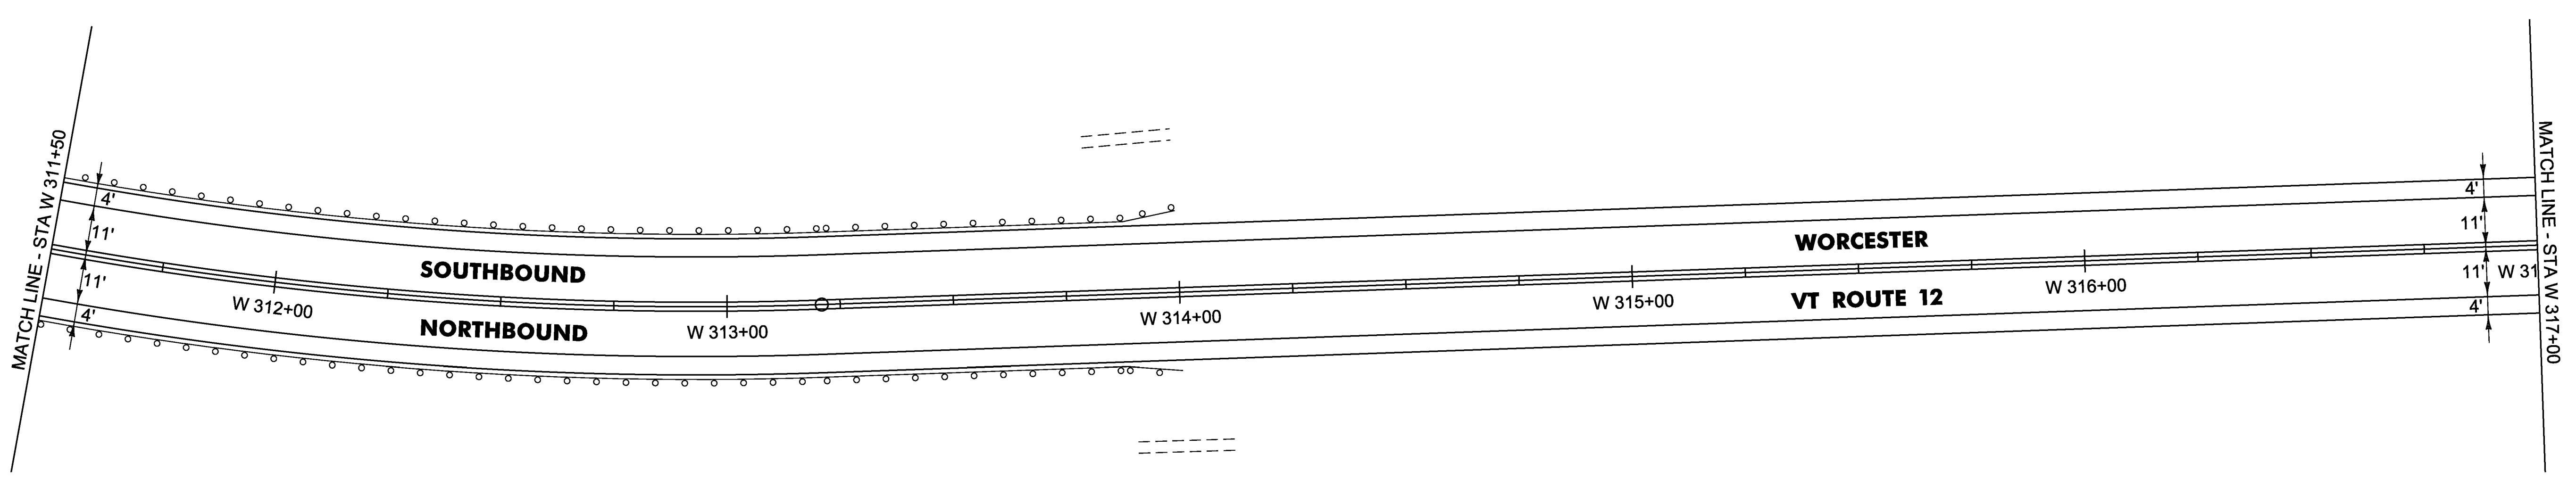
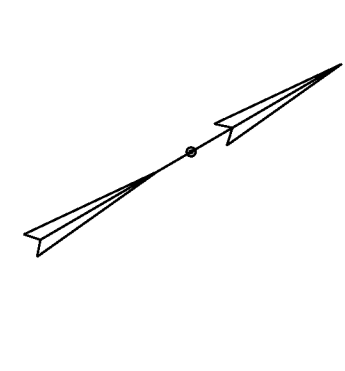
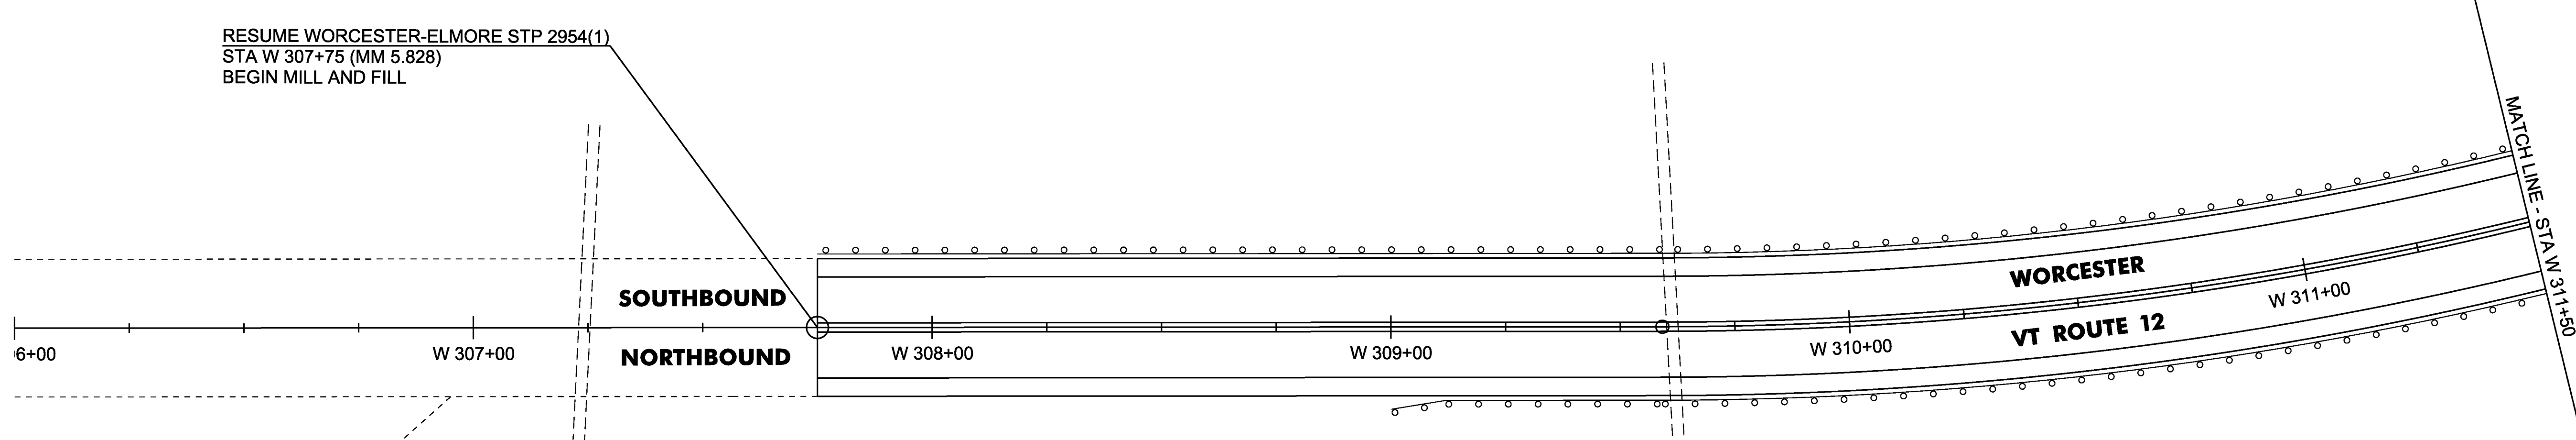


DURABLE 4 INCH WHITE LINE (OPTION BID ITEM)
W 306+00 TO W 317+00 RT & LT
TEMPORARY 4 INCH WHITE LINE, PAINT
W 306+00 TO W 317+00 RT & LT

DURABLE 4 INCH YELLOW LINE (OPTION BID ITEM)
W 306+00 TO W 317+00 RT & LT
TEMPORARY 4 INCH YELLOW LINE, PAINT
W 306+00 TO W 317+00 RT & LT

RESUME WORCESTER-ELMORE STP 2954(1)
STA W 307+75 (MM 5.828)
BEGIN MILL AND FILL

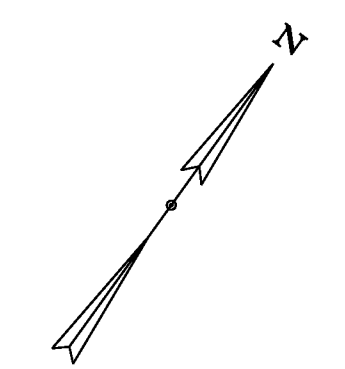

NOT TO SCALE

PROJECT NAME: WORCESTER-ELMORE	PLOT DATE: 13-MAY-2016
PROJECT NUMBER: STP 2954(1)	DRAWN BY: B. KIPP
FILE NAME: pl4v23lwrk.dgn	CHECKED BY: N. PAPPAS
PROJECT LEADER: J. HARRINGTON	SHEET 12 OF 33
DESIGNED BY: B. KIPP	
PLAN SHEET 2	