
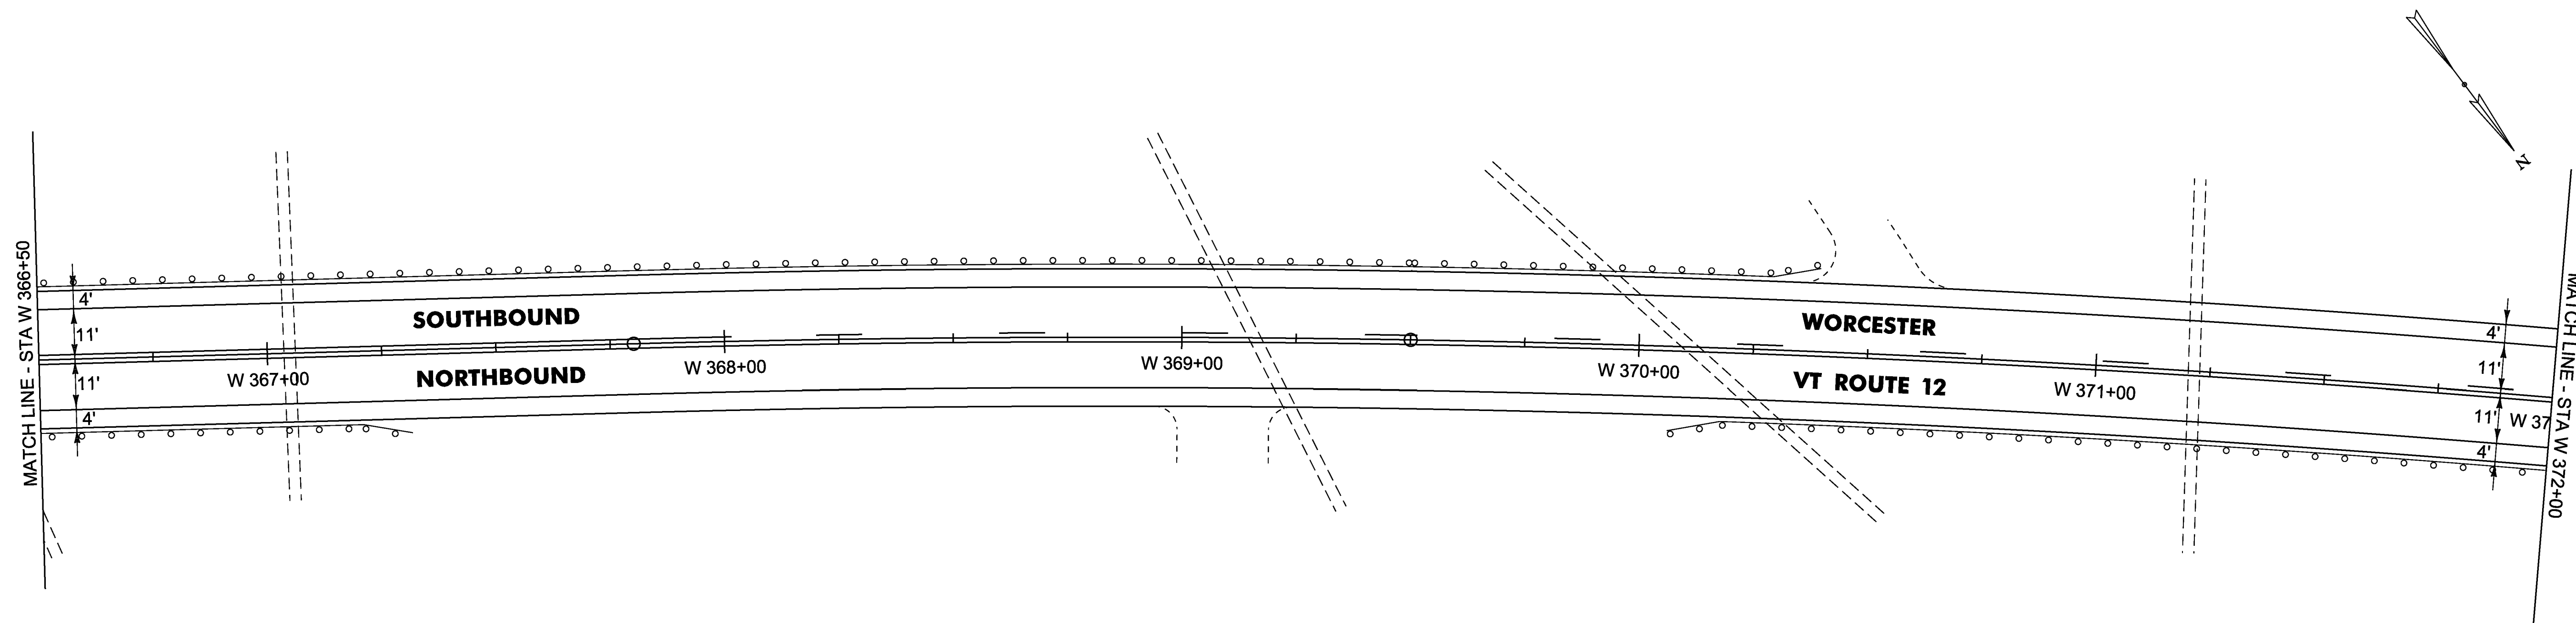


DURABLE 4 INCH WHITE LINE (OPTION BID ITEM)
W 361+00 TO W 372+00 RT & LT

TEMPORARY 4 INCH WHITE LINE, PAINT
W 361+00 TO W 372+00 RT & LT

DURABLE 4 INCH YELLOW LINE (OPTION BID ITEM)
W 361+00 TO W 365+90 DASHED RT, SOLID LT
W 365+90 TO W 368+00 SOLID RT & LT
W 368+00 TO W 372+00 SOLID RT, DASHED LT

TEMPORARY 4 INCH YELLOW LINE, PAINT
W 361+00 TO W 365+90 DASHED RT, SOLID LT
W 365+90 TO W 368+00 SOLID RT & LT
W 368+00 TO W 372+00 SOLID RT, DASHED LT

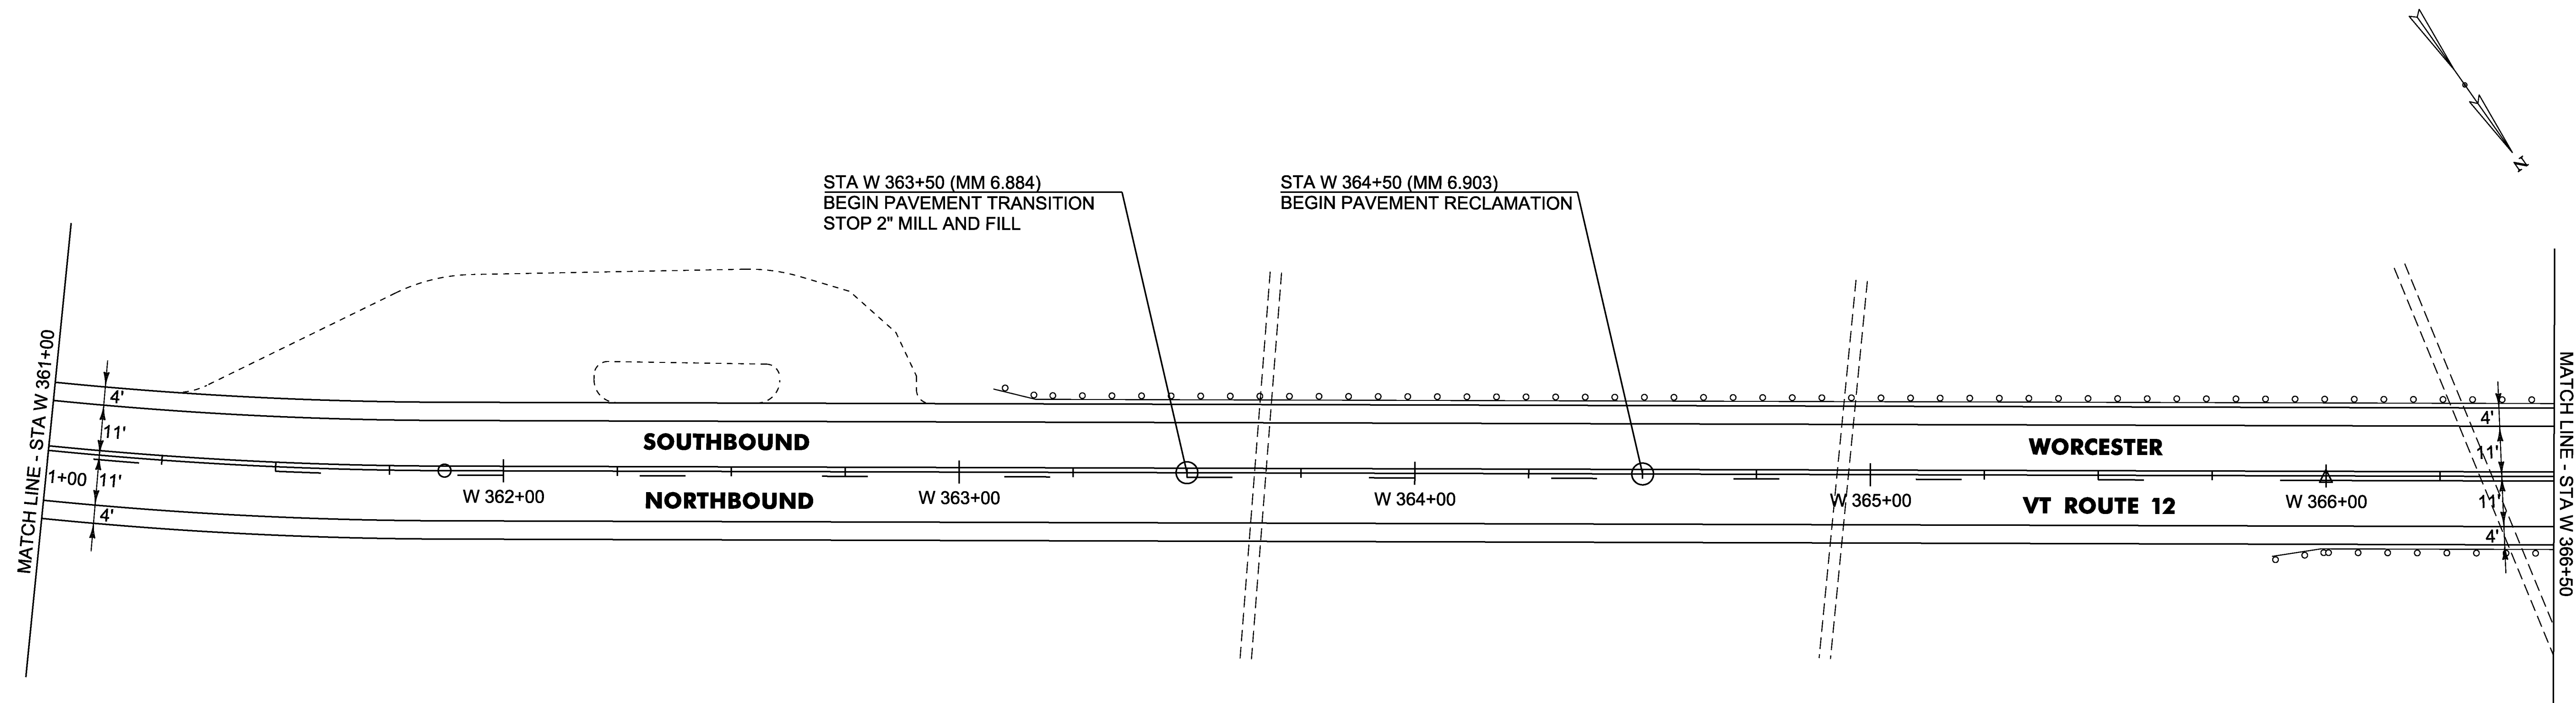

NOT TO SCALE

PROJECT NAME: WORCESTER-ELMORE	PLOT DATE: 13-MAY-2016
PROJECT NUMBER: STP 2954(I)	DRAWN BY: B. KIPP
FILE NAME: pl4v23lwrk.dgn	CHECKED BY: N. PAPPAS
PROJECT LEADER: J. HARRINGTON	SHEET 17 OF 33
DESIGNED BY: B. KIPP	
PLAN SHEET 7	