


DURABLE 4 INCH WHITE LINE (OPTION BID ITEM)  
W 383+00 TO W 394+00 RT & LT

TEMPORARY 4 INCH WHITE LINE, PAINT  
W 383+00 TO W 394+00 RT & LT

DURABLE 4 INCH YELLOW LINE (OPTION BID ITEM)  
W 383+00 TO W 394+00 SOLID RT & LT

TEMPORARY 4 INCH YELLOW LINE, PAINT  
W 383+00 TO W 394+00 SOLID RT & LT

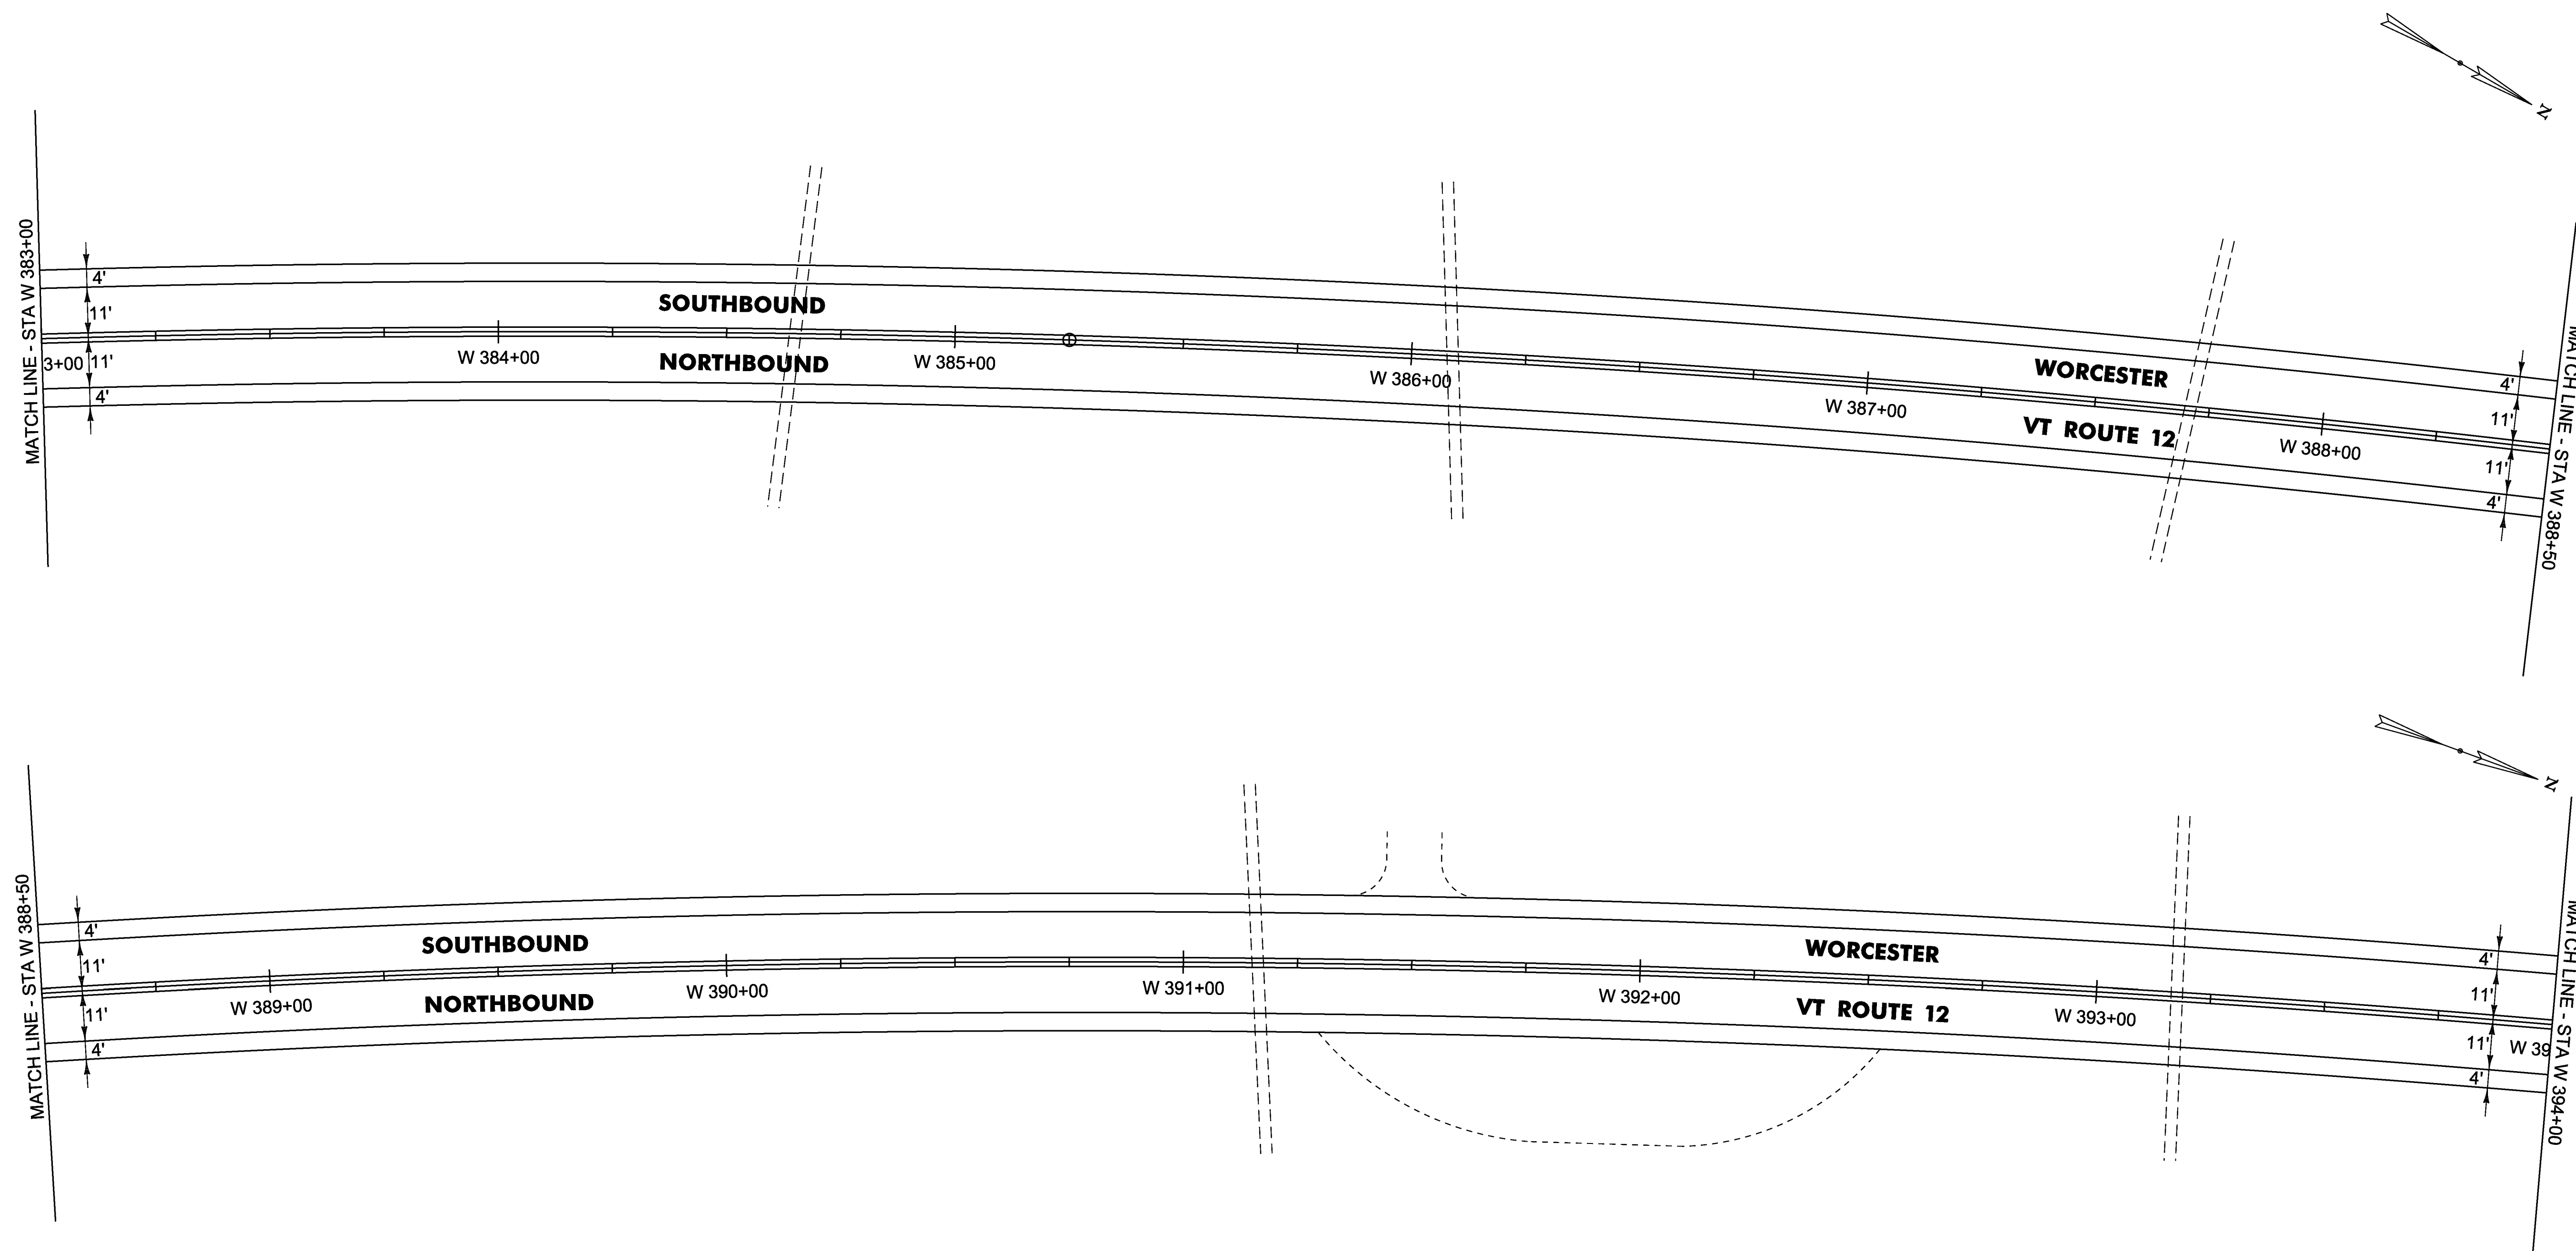

**NOT TO SCALE**

PROJECT NAME: WORCESTER-ELMORE	PLOT DATE: 13-MAY-2016
PROJECT NUMBER: STP 2954(I)	DRAWN BY: B. KIPP
FILE NAME: pl4v23lwrk.dgn	CHECKED BY: N. PAPPAS
PROJECT LEADER: J. HARRINGTON	SHEET 19 OF 33
DESIGNED BY: B. KIPP	
PLAN SHEET 9	