
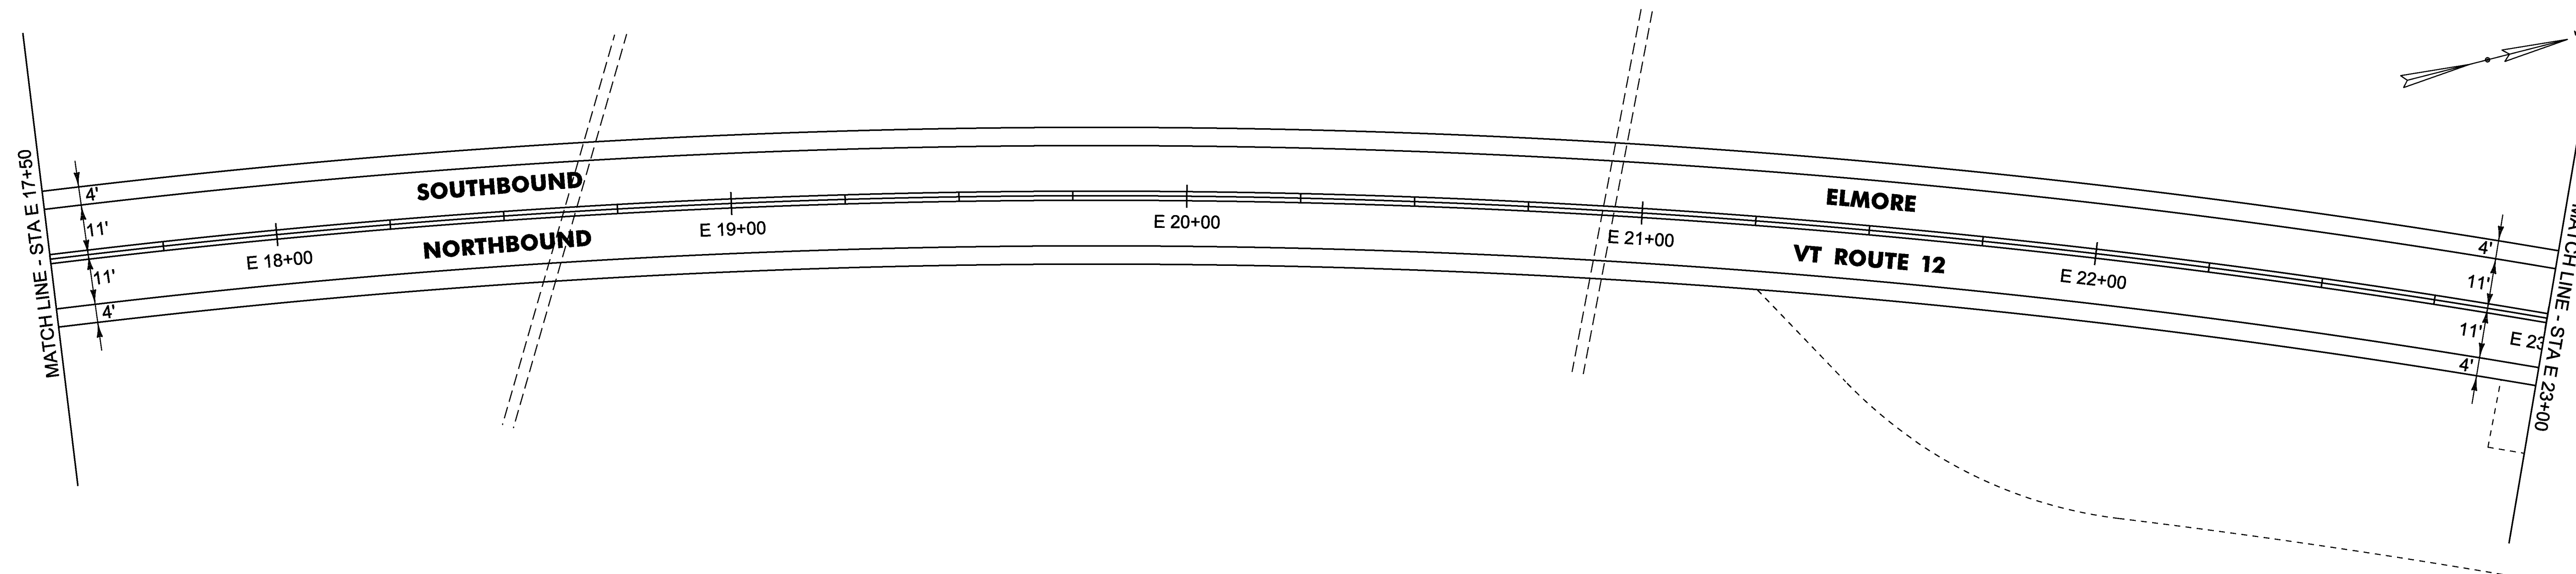
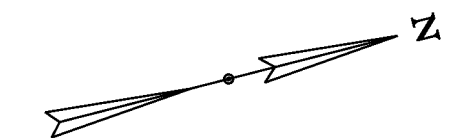
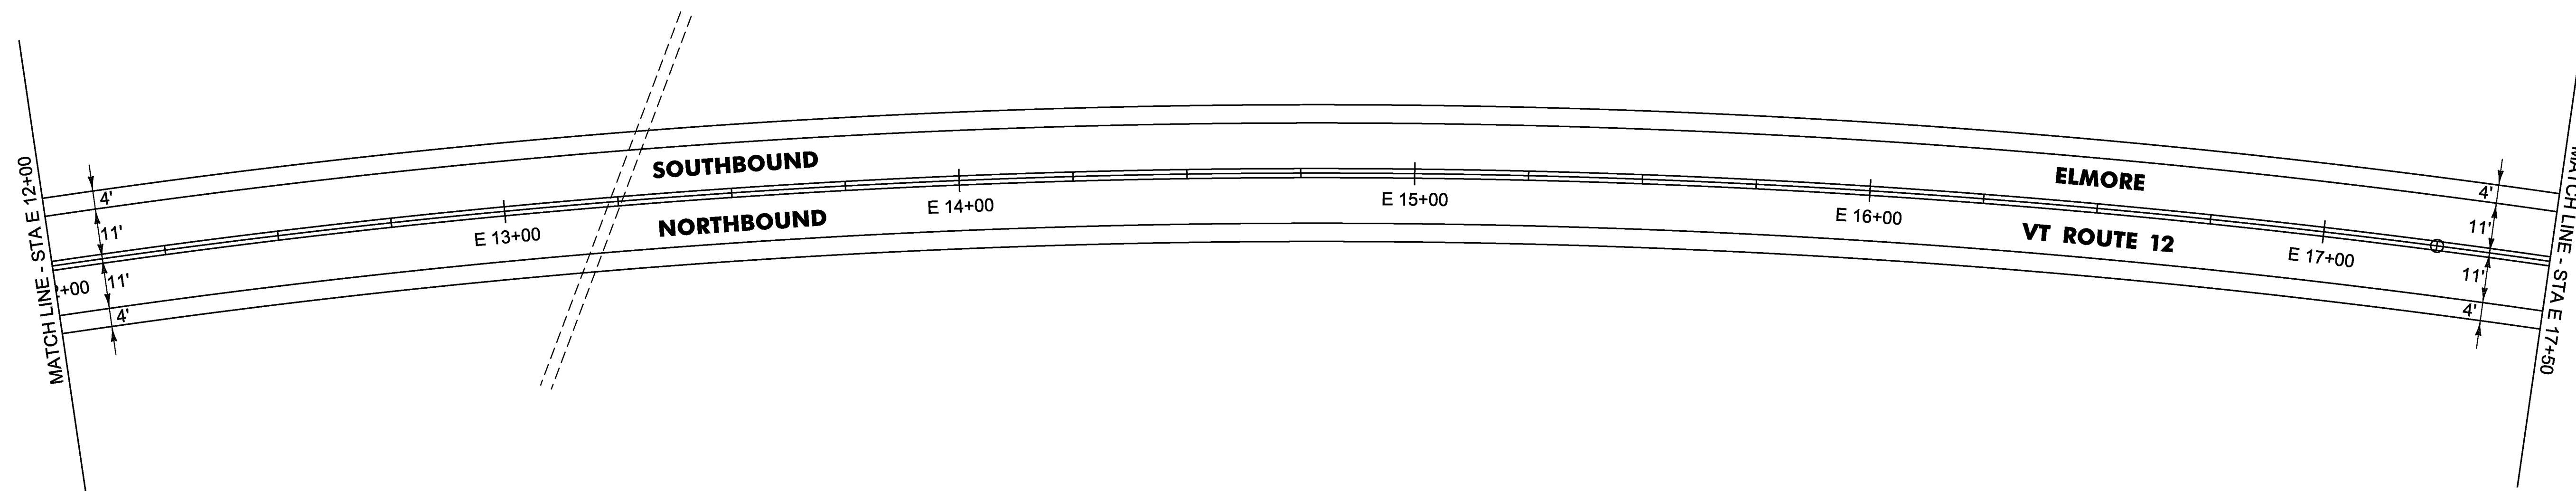


DURABLE 4 INCH WHITE LINE (OPTION BID ITEM)  
E 12+00 TO E 23+00 RT & LT

TEMPORARY 4 INCH WHITE LINE, PAINT  
E 12+00 TO E 23+00 RT & LT

DURABLE 4 INCH YELLOW LINE (OPTION BID ITEM)  
E 12+00 TO E 23+00 SOLID RT & LT

TEMPORARY 4 INCH YELLOW LINE, PAINT  
E 12+00 TO E 23+00 SOLID RT & LT

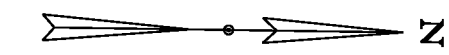

**NOT TO SCALE**

PROJECT NAME:	WORCESTER-ELMORE
PROJECT NUMBER:	STP 2954(I)
FILE NAME:	pl4v23lwrk.dgn
PROJECT LEADER:	J. HARRINGTON
DESIGNED BY:	B. KIPP
PLAN SHEET	I3
PLOT DATE:	I3-MAY-2016
DRAWN BY:	B. KIPP
CHECKED BY:	N. PAPPAS
SHEET	23 OF 33