
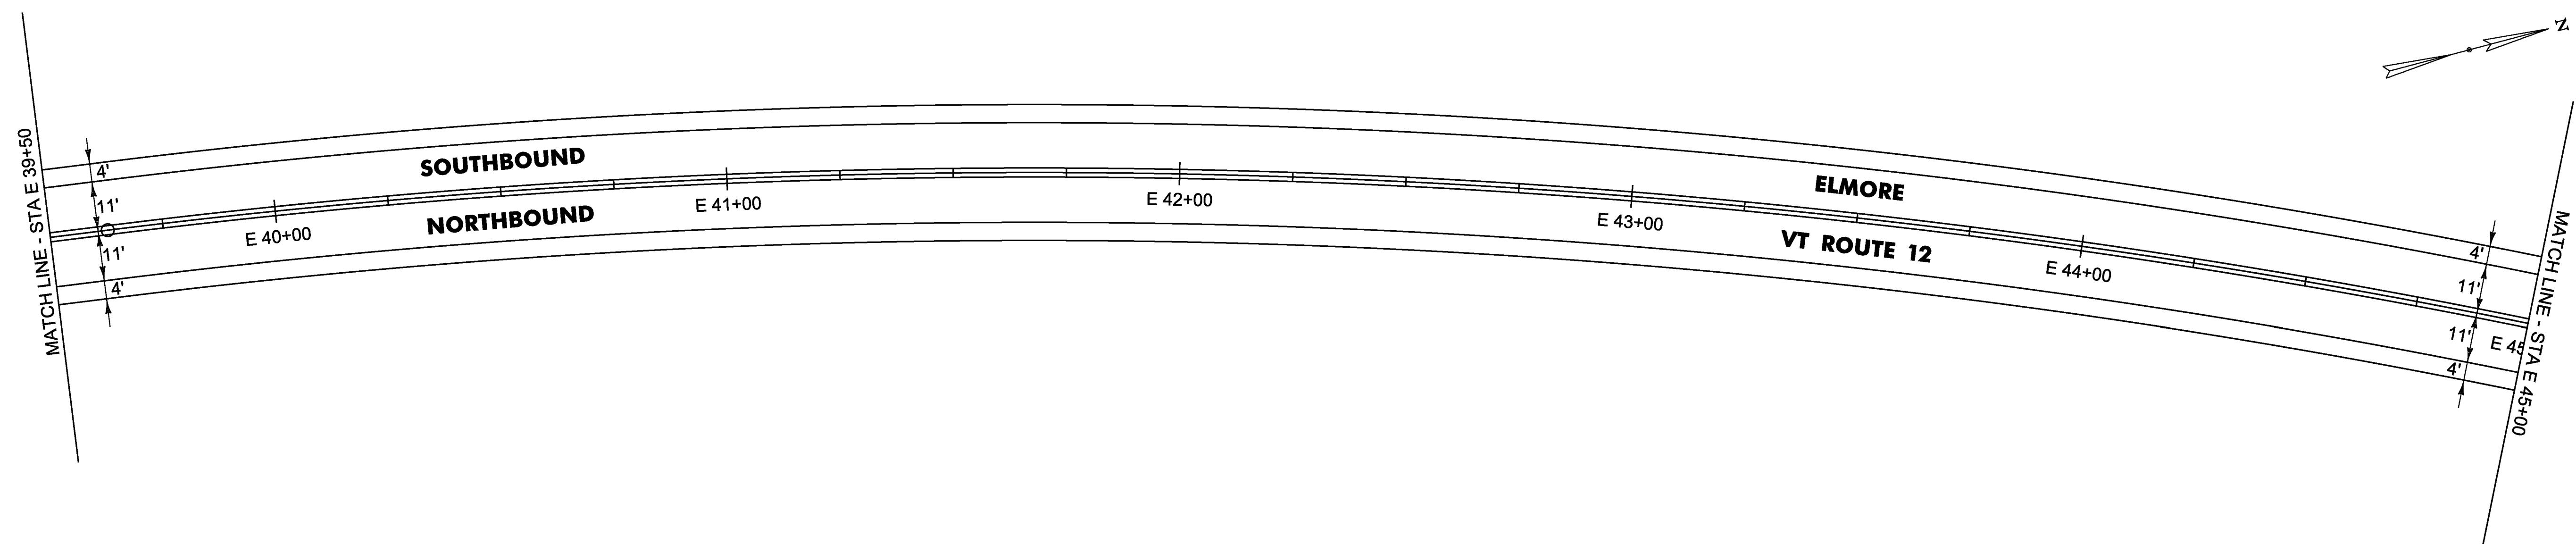


DURABLE 4 INCH WHITE LINE (OPTION BID ITEM)  
E 34+00 TO E 45+00 RT & LT

DURABLE 4 INCH YELLOW LINE (OPTION BID ITEM)  
E 34+00 TO E 45+00 SOLID RT & LT

TEMPORARY 4 INCH WHITE LINE, PAINT  
E 34+00 TO E 45+00 RT & LT

TEMPORARY 4 INCH YELLOW LINE, PAINT  
E 34+00 TO E 45+00 SOLID RT & LT

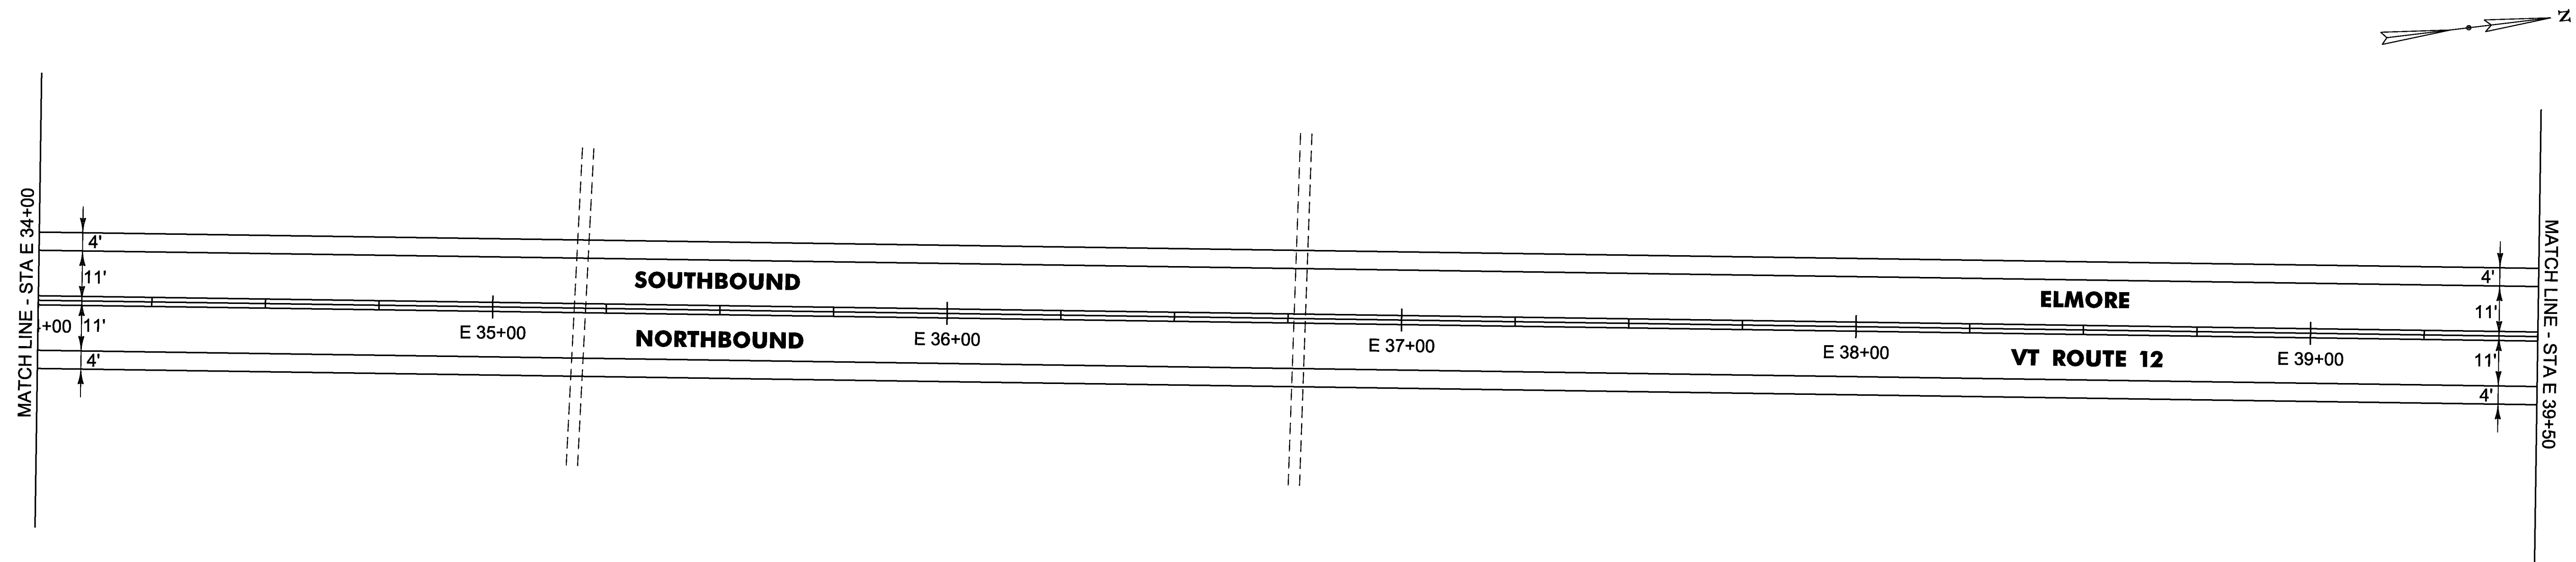

NOT TO SCALE

PROJECT NAME: WORCESTER-ELMORE	PLOT DATE: 13-MAY-2016
PROJECT NUMBER: STP 2954(I)	DRAWN BY: B. KIPP
FILE NAME: pl4v23lwrk.dgn	CHECKED BY: N. PAPPAS
PROJECT LEADER: J. HARRINGTON	SHEET 25 OF 33
DESIGNED BY: B. KIPP	
PLAN SHEET 15	