

NOTES:

1. MATERIALS AND PLACEMENT FOR SPECIAL PROVISION (GABION MATTRESS) SHALL MEET THE REQUIREMENTS OF SECTION 900 OF THE SPECIAL PROVISIONS.


2. GEOTEXTILE UNDER STONE FILL SHALL BE PLACED ON TOP OF THE STONE FILL TYPE II. GEOTEXTILE SHALL HAVE A ONE FOOT KEY AROUND THE PERIMETER OF THE STONE FILL TYPE II AND A ONE FOOT OVERLAP BETWEEN EACH ROLL. ALL COSTS ASSOCIATED WITH THIS WORK WILL BE INCLUDED IN THE UNIT PRICE BID FOR ITEM 649.31, GEOTEXTILE UNDER STONE FILL.

3. DOUBLE NET TEMPORARY EROSION MATTING (BIODEGRADABLE) WITH A 12 MONTH LONGEVITY SHALL BE ATTACHED TO THE TOP OF THE WELDED WIRE MESH OF THE GABION MATTRESS. ALL COSTS ASSOCIATED WITH THIS WORK WILL BE INCLUDED IN THE UNIT PRICE BID FOR ITEM 653.20, TEMPORARY EROSION MATTING.

4. TOP SOIL SHALL BE PLACED ON TOP OF THE DOUBLE NET TEMPORARY EROSION MATTING (BIODEGRADABLE) AND SHALL THEN BE HYDROSEEDING/HYDROMULCHED. TOP SOIL SHALL FILL IN ALL GAPS BETWEEN THE GABION MATTRESS AND ADJACENT SOIL AS DIRECTED BY THE ENGINEER. PAYMENT WILL BE MADE UNDER THE APPROPRIATE SECTION 651 CONTRACT ITEMS

IF VEGETATION IS NOT ESTABLISHED BY THE CONTRACT COMPLETION DATE A LAYER OF DOUBLE NET TEMPORARY EROSION MATTING (BIODEGRADABLE) SHALL BE PLACED ON THE TOPSOIL AS DIRECTED BY THE ENGINEER. A QUANTITY FOR DOUBLE NET TEMPORARY EROSION MATTING (BIODEGRADABLE) HAS BEEN ADDED TO THE QUANTITIES. ALL COSTS ASSOCIATED WITH THIS WORK WILL BE INCLUDED IN THE UNIT PRICE BID FOR ITEM 653.20, TEMPORARY EROSION MATTING.

5. EMULSIFIED ASPHALT SHALL BE APPLIED TO ALL EXISTING PAVEMENT SURFACES AT A RATE OF 0.080 GAL/SY (+/- 0.01GAL/SY) OR AS DIRECTED BY THE ENGINEER.

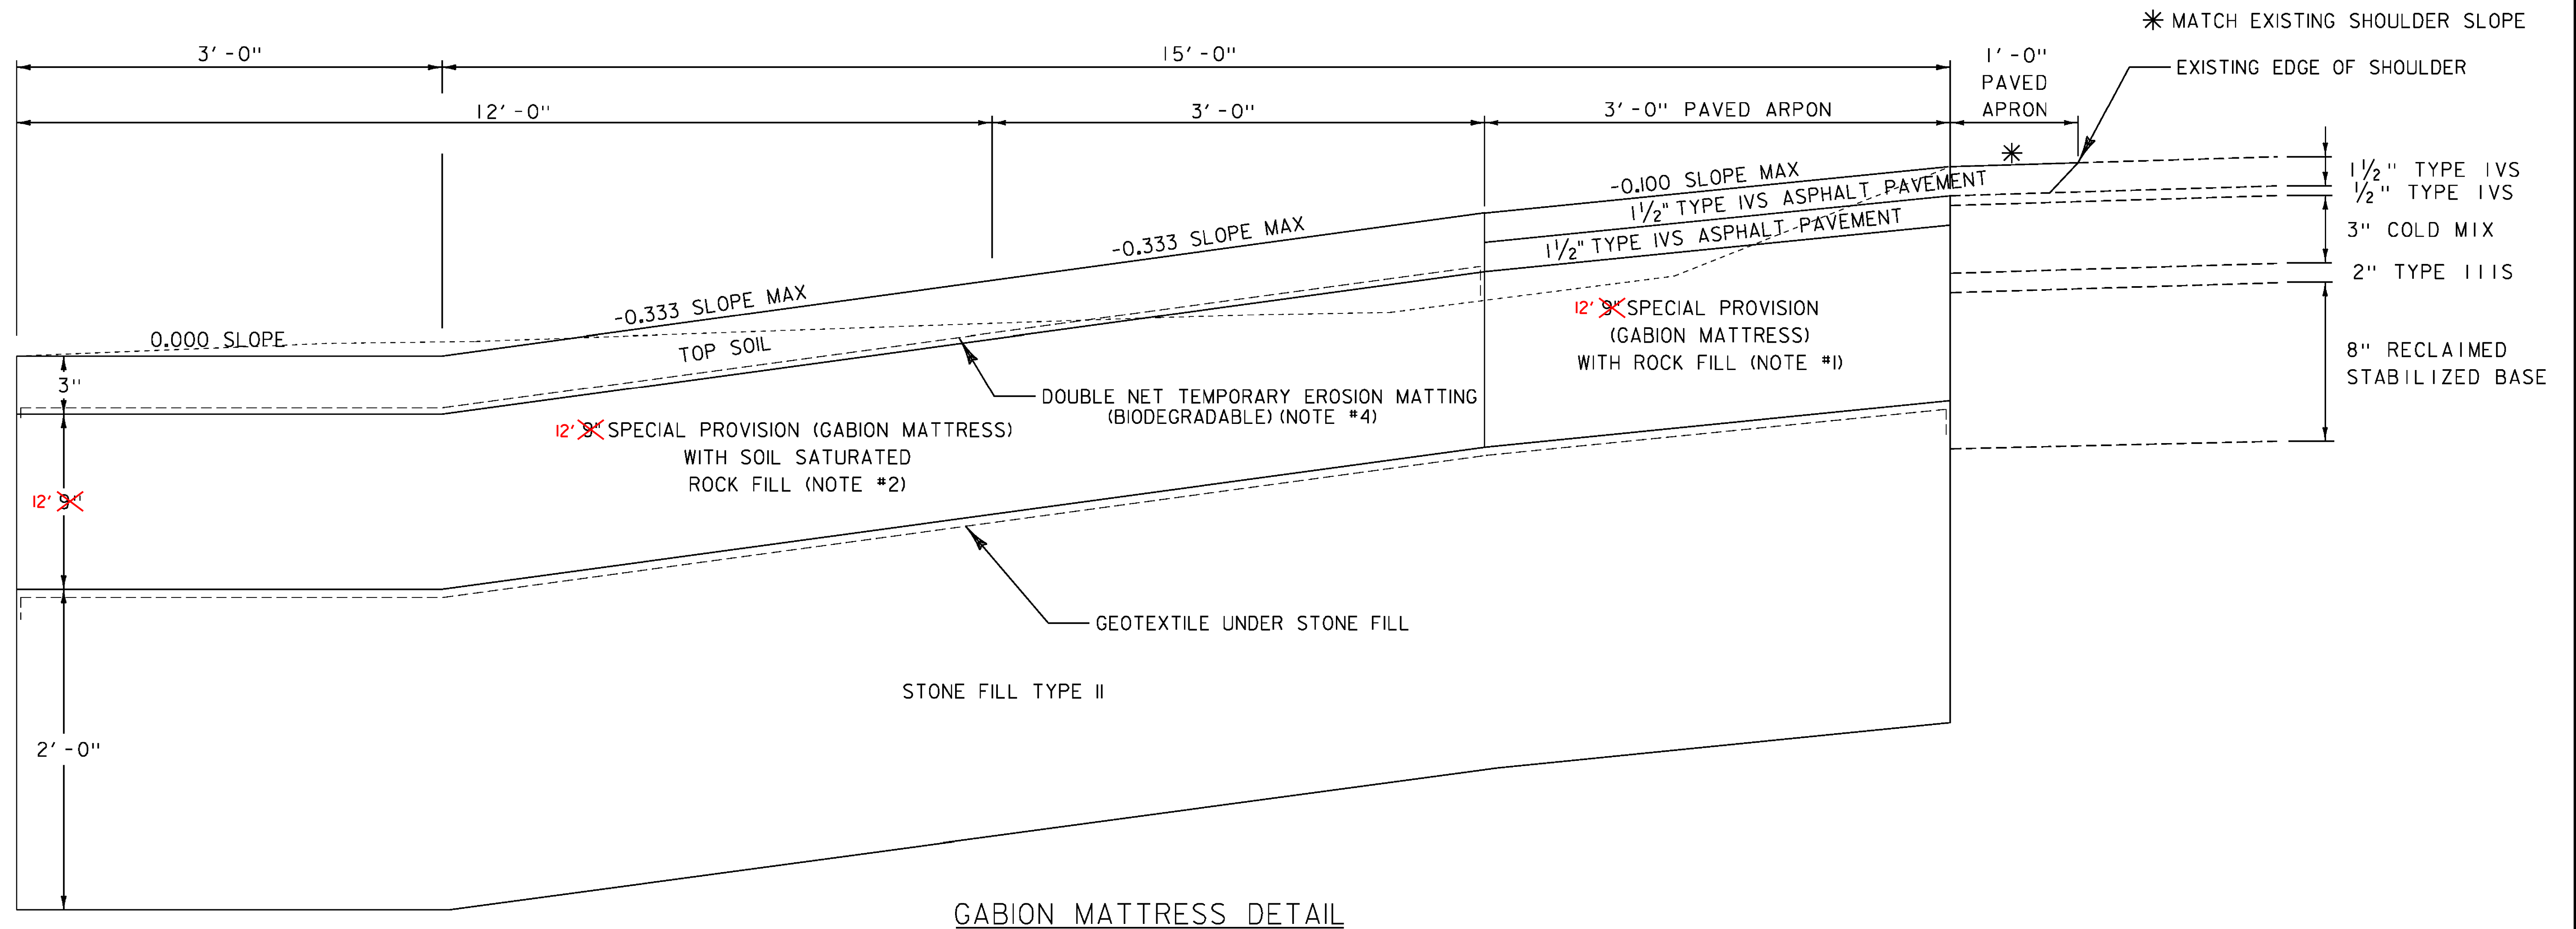

GABION MATTRESS DETAIL

NOT TO SCALE

PROJECT NAME: ESSEX	PLOT DATE: 18-JUN-2015
PROJECT NUMBER: STP 2912(2)	DRAWN BY: N. PAPPAS
FILE NAME: p14v256_details.dgn	CHECKED BY: M. FOWLER
PROJECT LEADER: M. FOWLER	SHEET 4 OF 17
DESIGNED BY: N. PAPPAS	
GABION WALL DETAIL SHEET 1	