
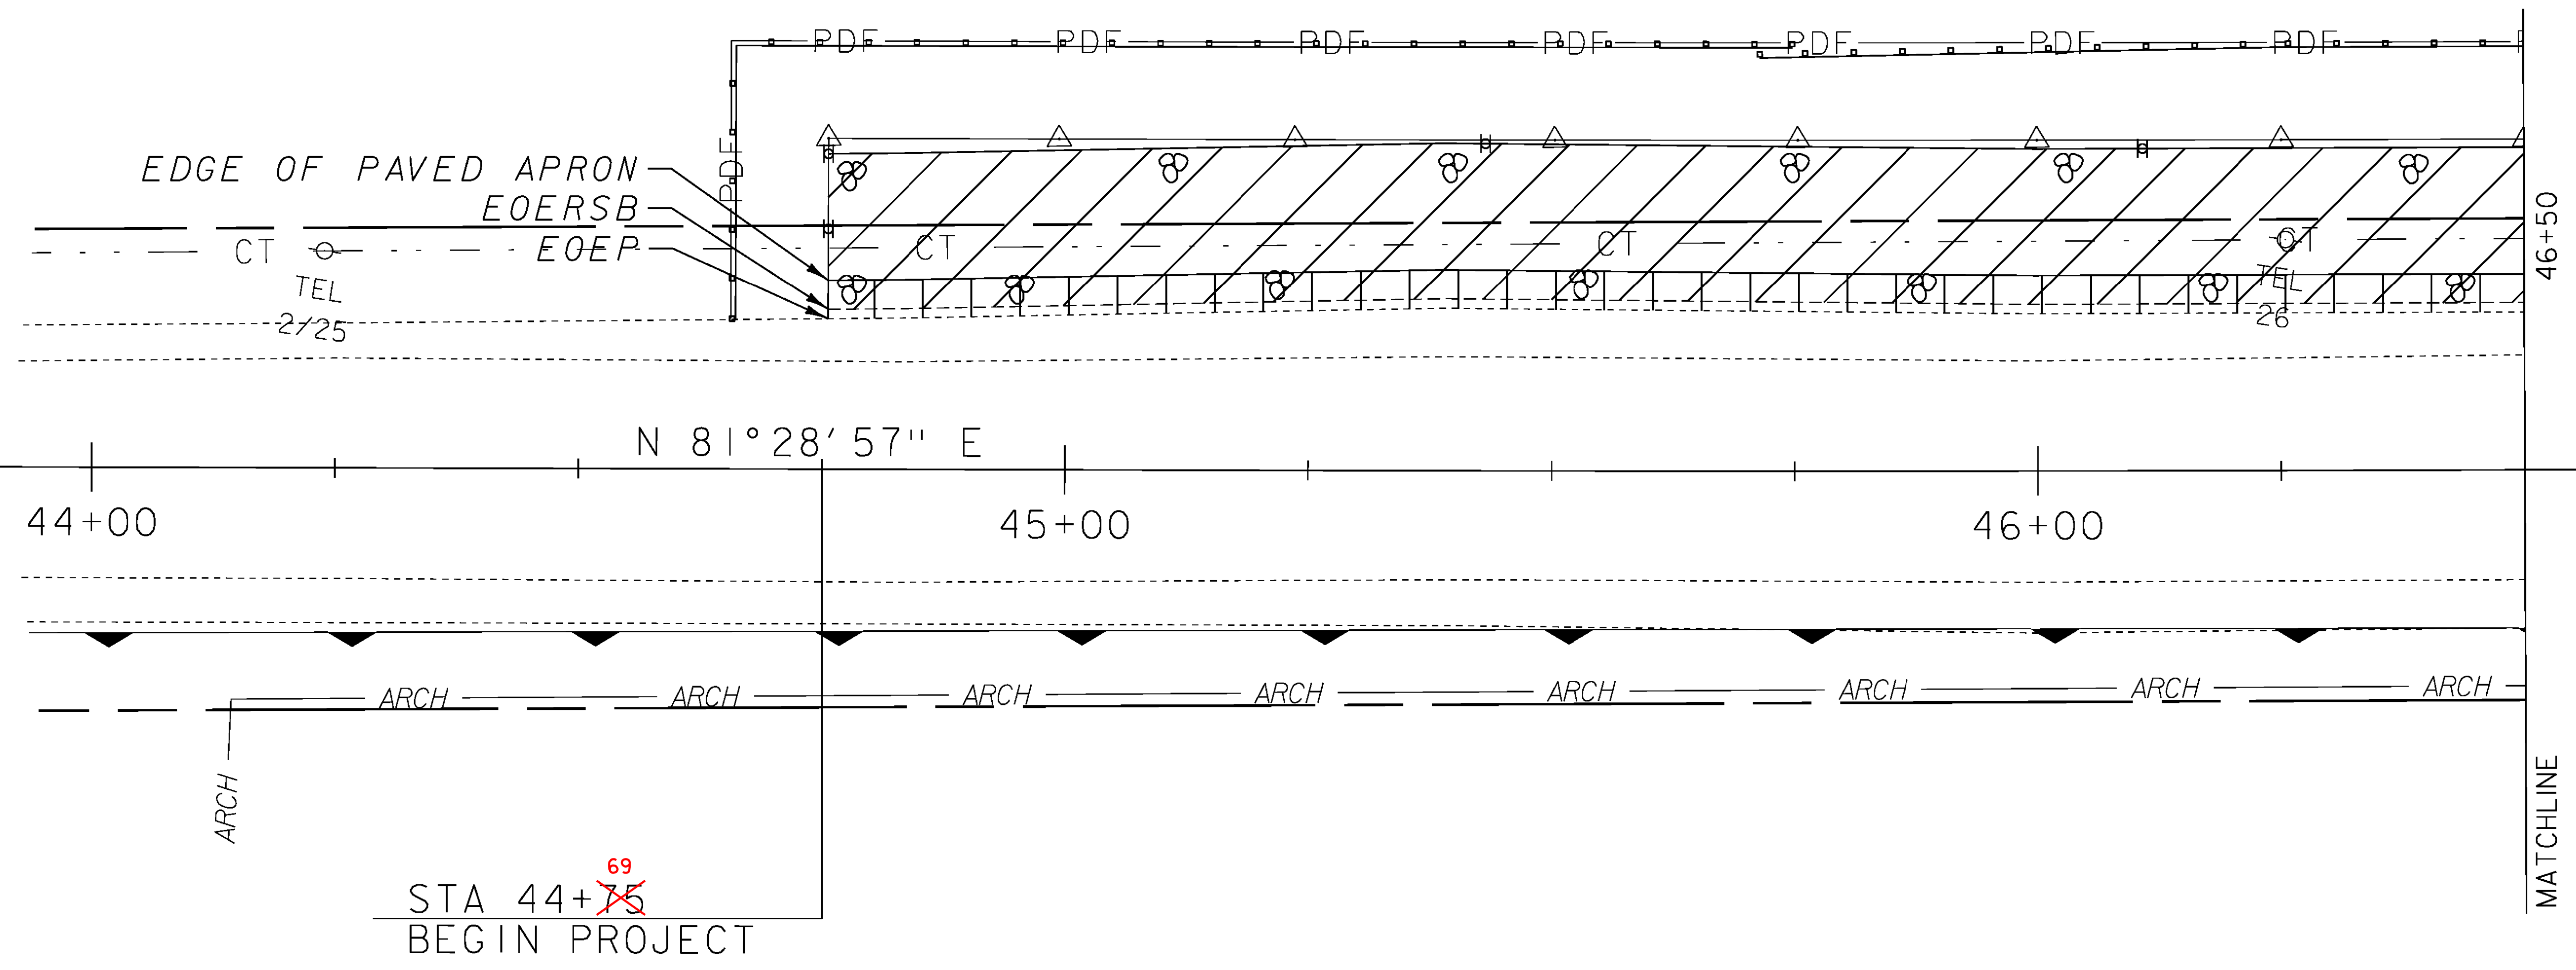


STONE FILL, TYPE II
 STA 44+75 TO 46+50 LT
 GEOTEXTILE UNDER STONE FILL
 STA 44+75 TO 46+50 LT
 GEOTEXTILE FOR SILT FENCE
 STA 44+66 TO 46+50 LT

SPECIAL PROVISION (GABION MATTRESS)
 STA 44+75 TO 46+50 LT


PROJECT DEMARCATION FENCE
 STA 44+66 TO 46+50 LT

DELINEATOR WITH STEEL POST
 STA 44+75 LT (24.71 FT)
 STA 44+75 LT (32.42 FT)
 STA 45+43 LT (33.63 FT)
 STA 46+11 LT (33.13 FT)

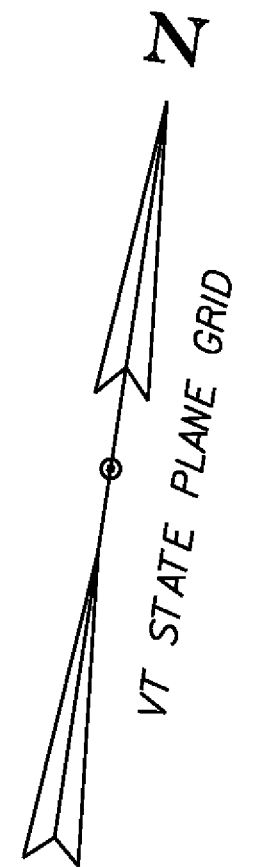

LEGEND	
	CUT AND FILL LIMITS
	EOERSB EDGE OF EXISTING RECLAIMED STABILIZED BASE
	EOEP EDGE OF EXISTING PAVEMENT
	GABION MATTRESS
	PAVED APRON

NOTE: ALL UTILITY POLES NEED TO BE SUPPORTED WHILE WORK IS BEING CONDUCTED NEAR A UTILITY POLE. CONTRACTOR SHALL COORDINATE WORK WITH THE UTILITY COMPANY. SEE THE UTILITY SPECIAL PROVISIONS FOR ADDITIONAL INFORMATION AND REQUIREMENTS.

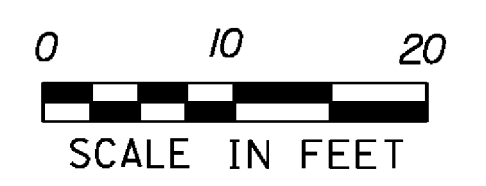

PROJECT NAME: ESSEX	PLOT DATE: 08-JUN-2015
PROJECT NUMBER: STP 2912(2)	DRAWN BY: N.PAPPAS
FILE NAME: pl4v256_bdr.dgn	CHECKED BY: M. FOWLER
DESIGNED BY: N. PAPPAS	SHEET 7 OF 17
PLAN SHEET 1	