




45+00

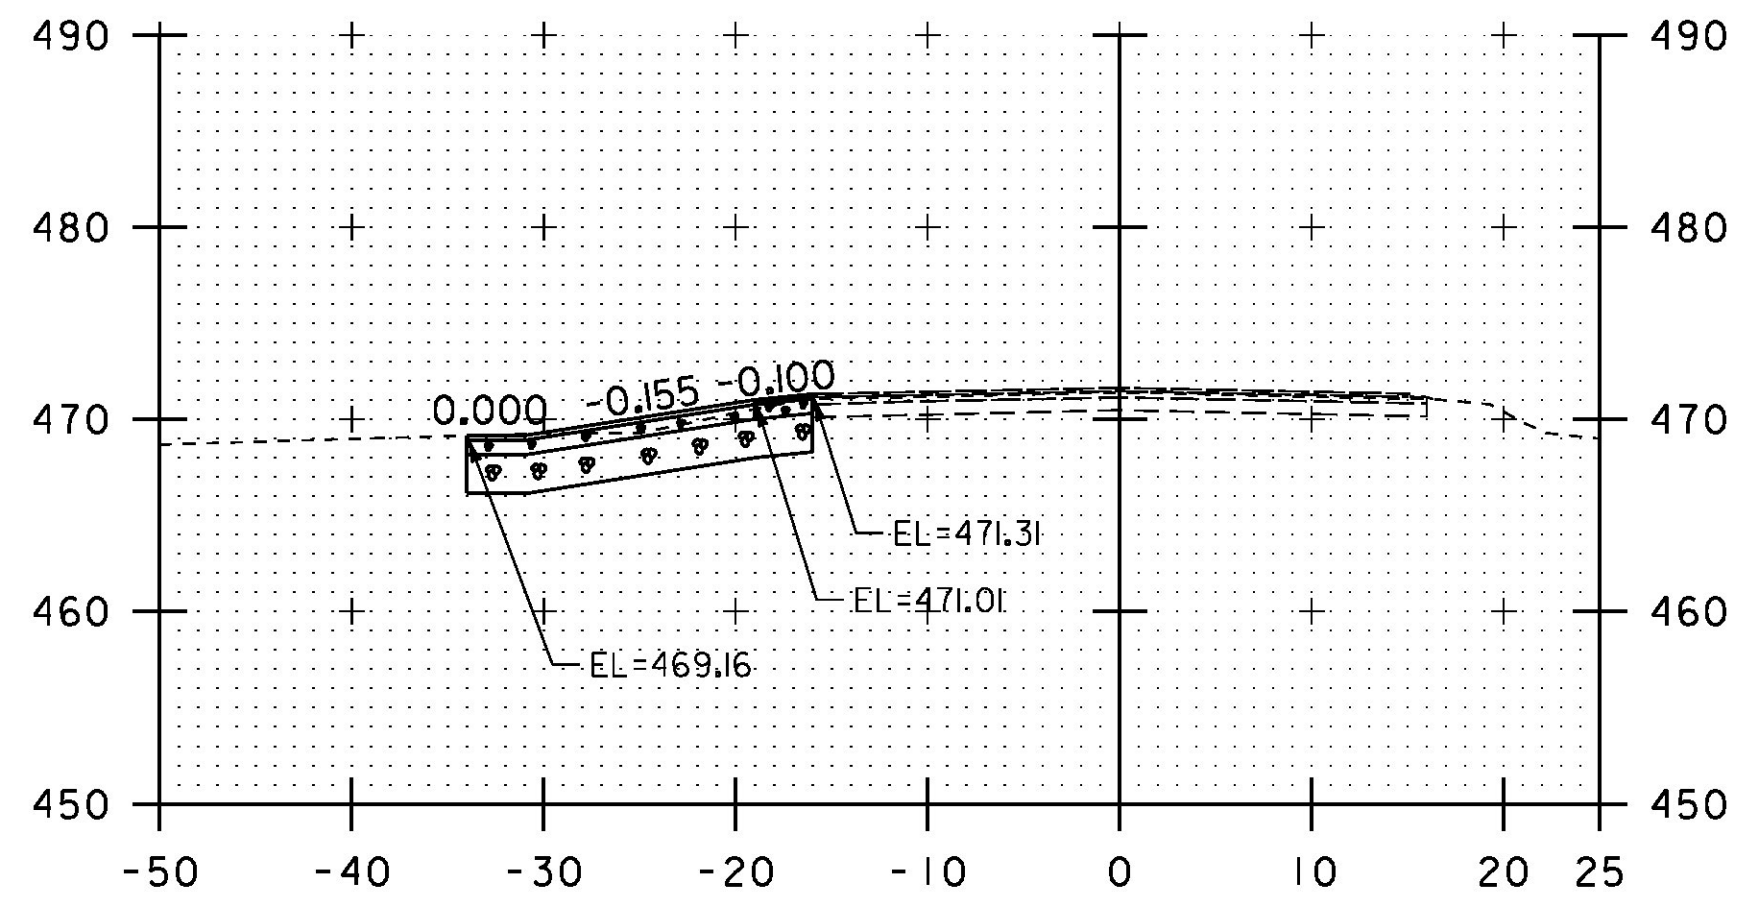


45+75

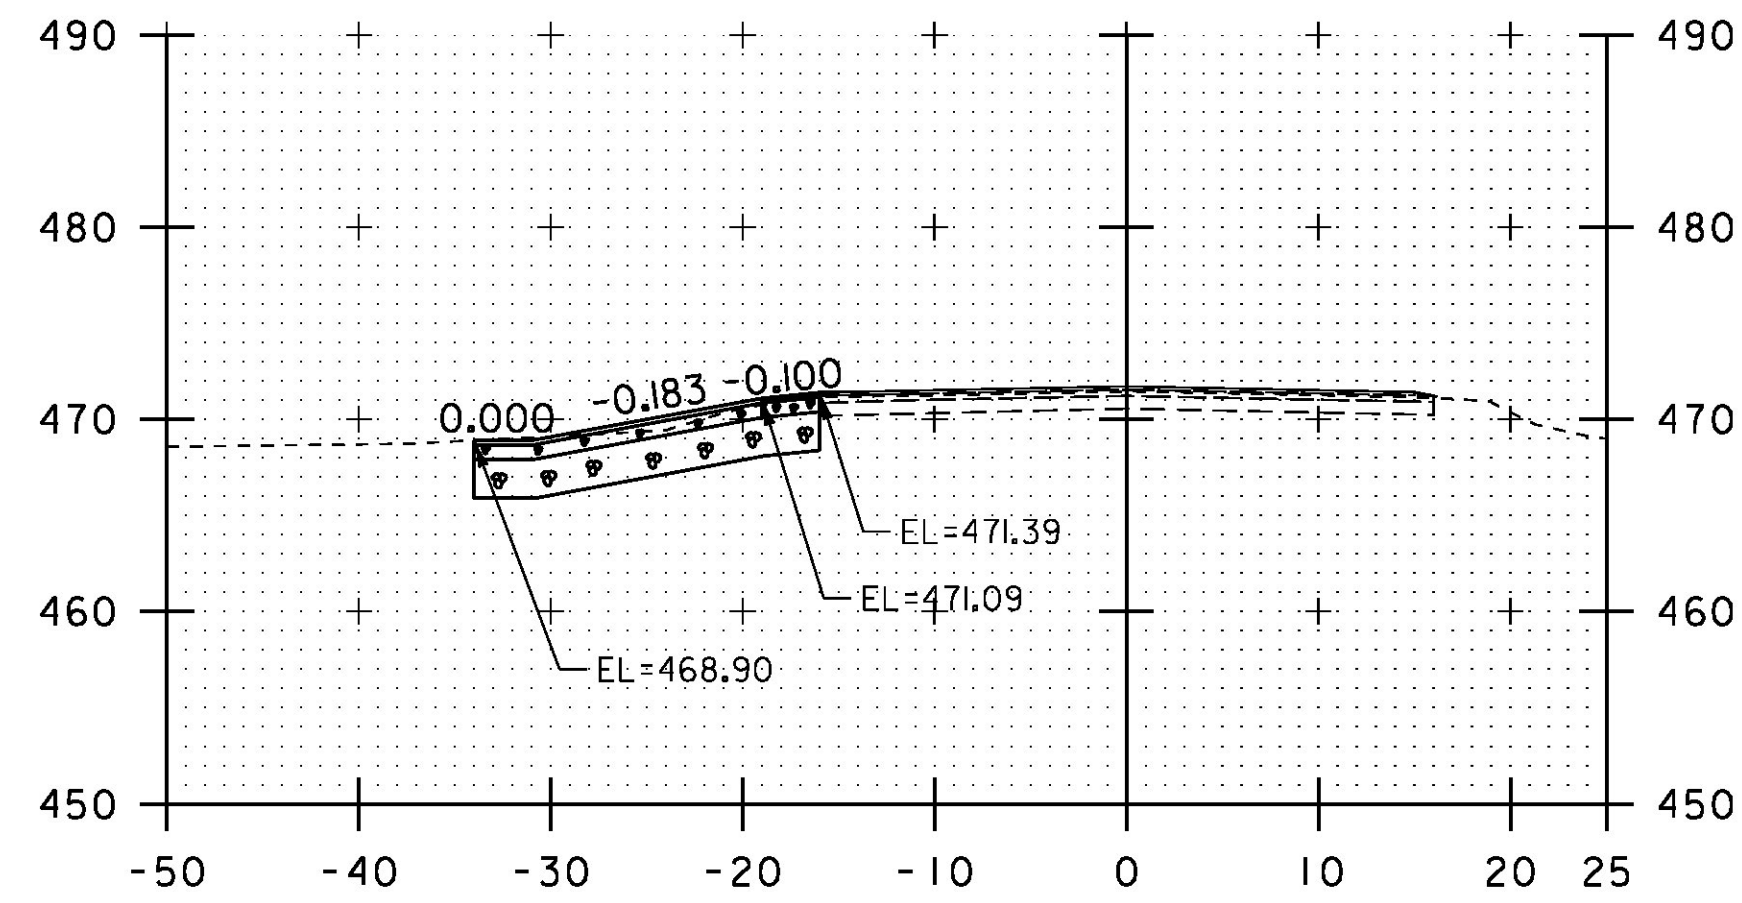


46+50

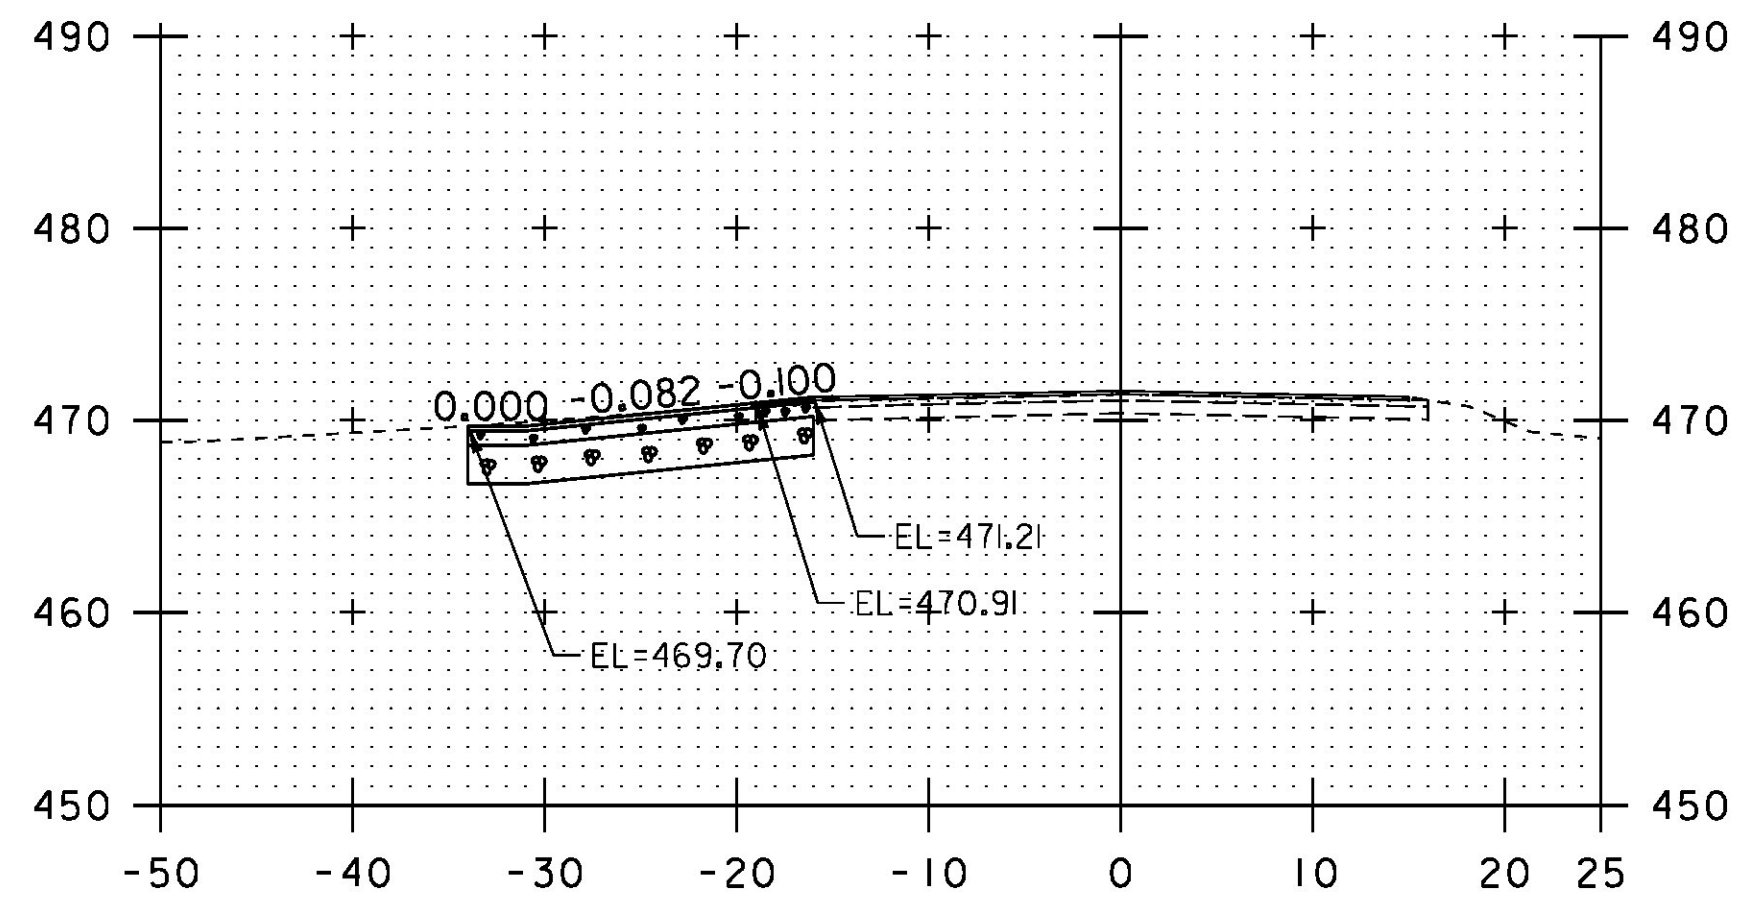


44+75 BEGIN PROJECT  
SPECIAL PROVISION (GABION MATTRESS)

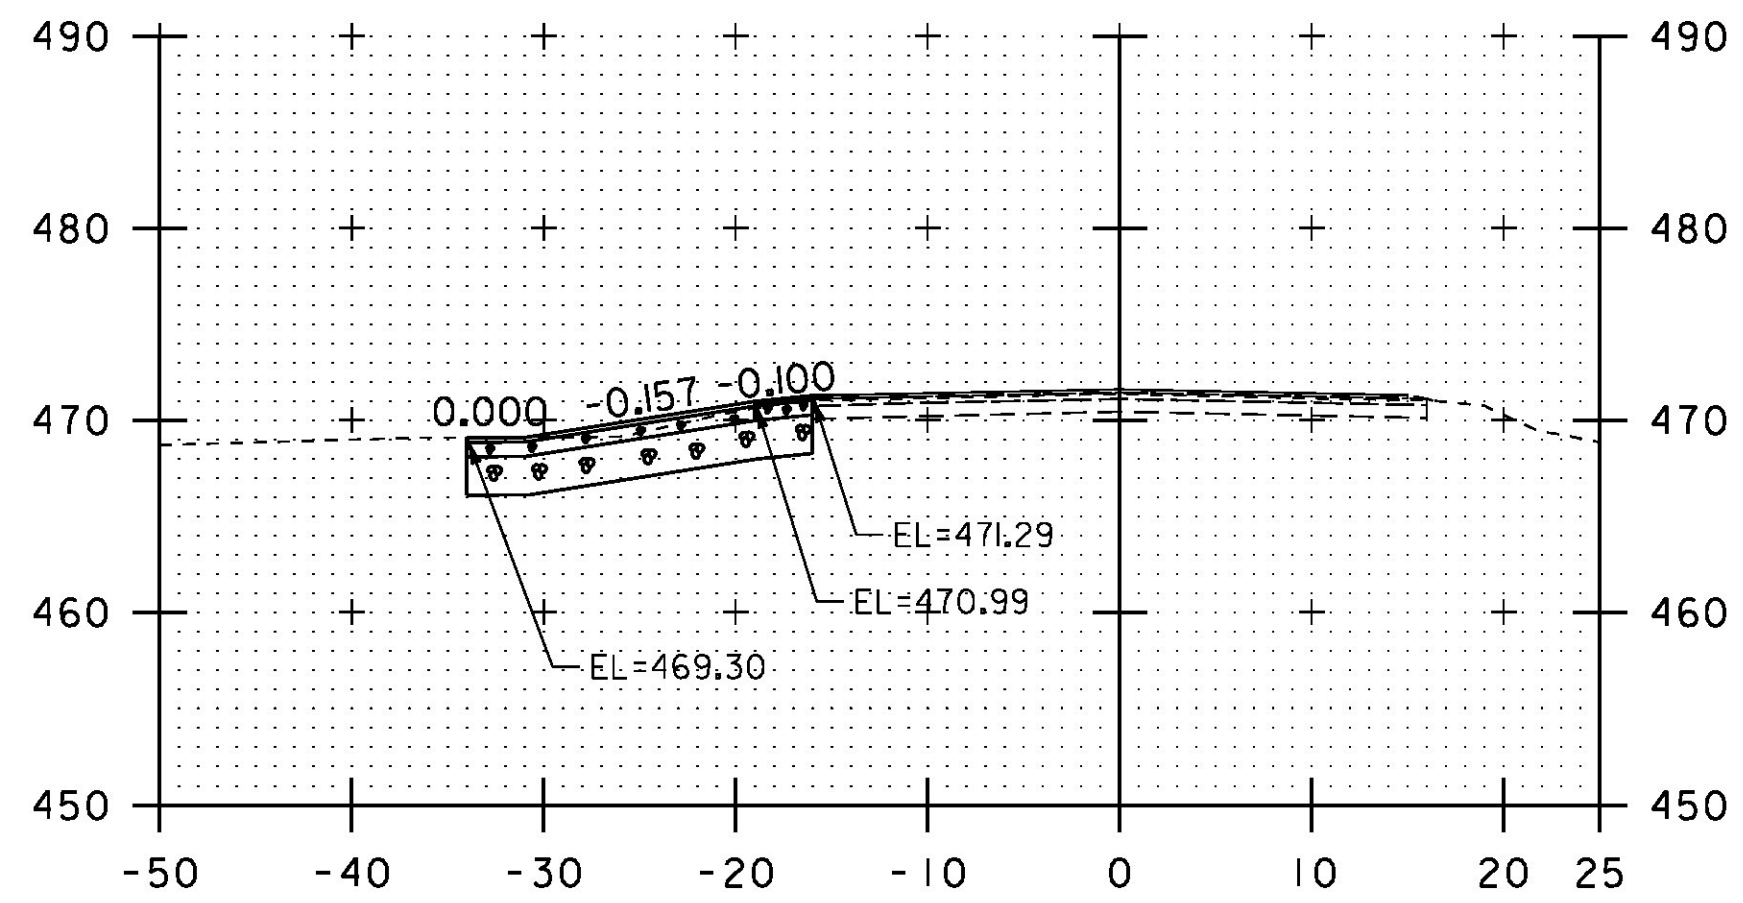


45+50

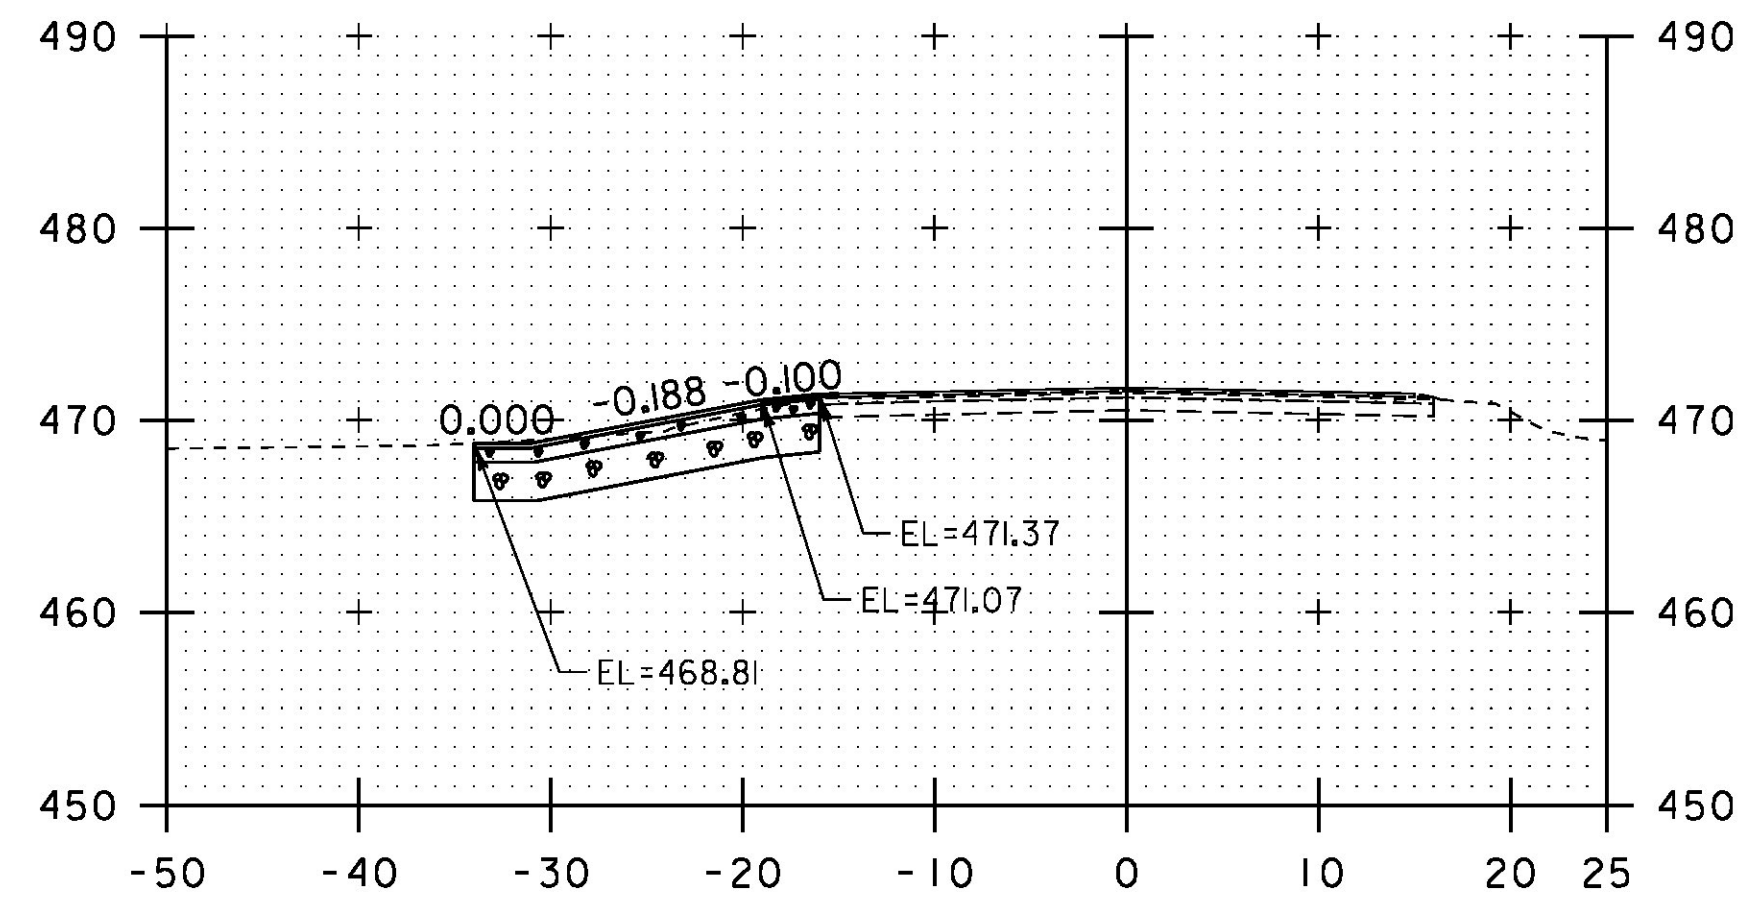


46+25

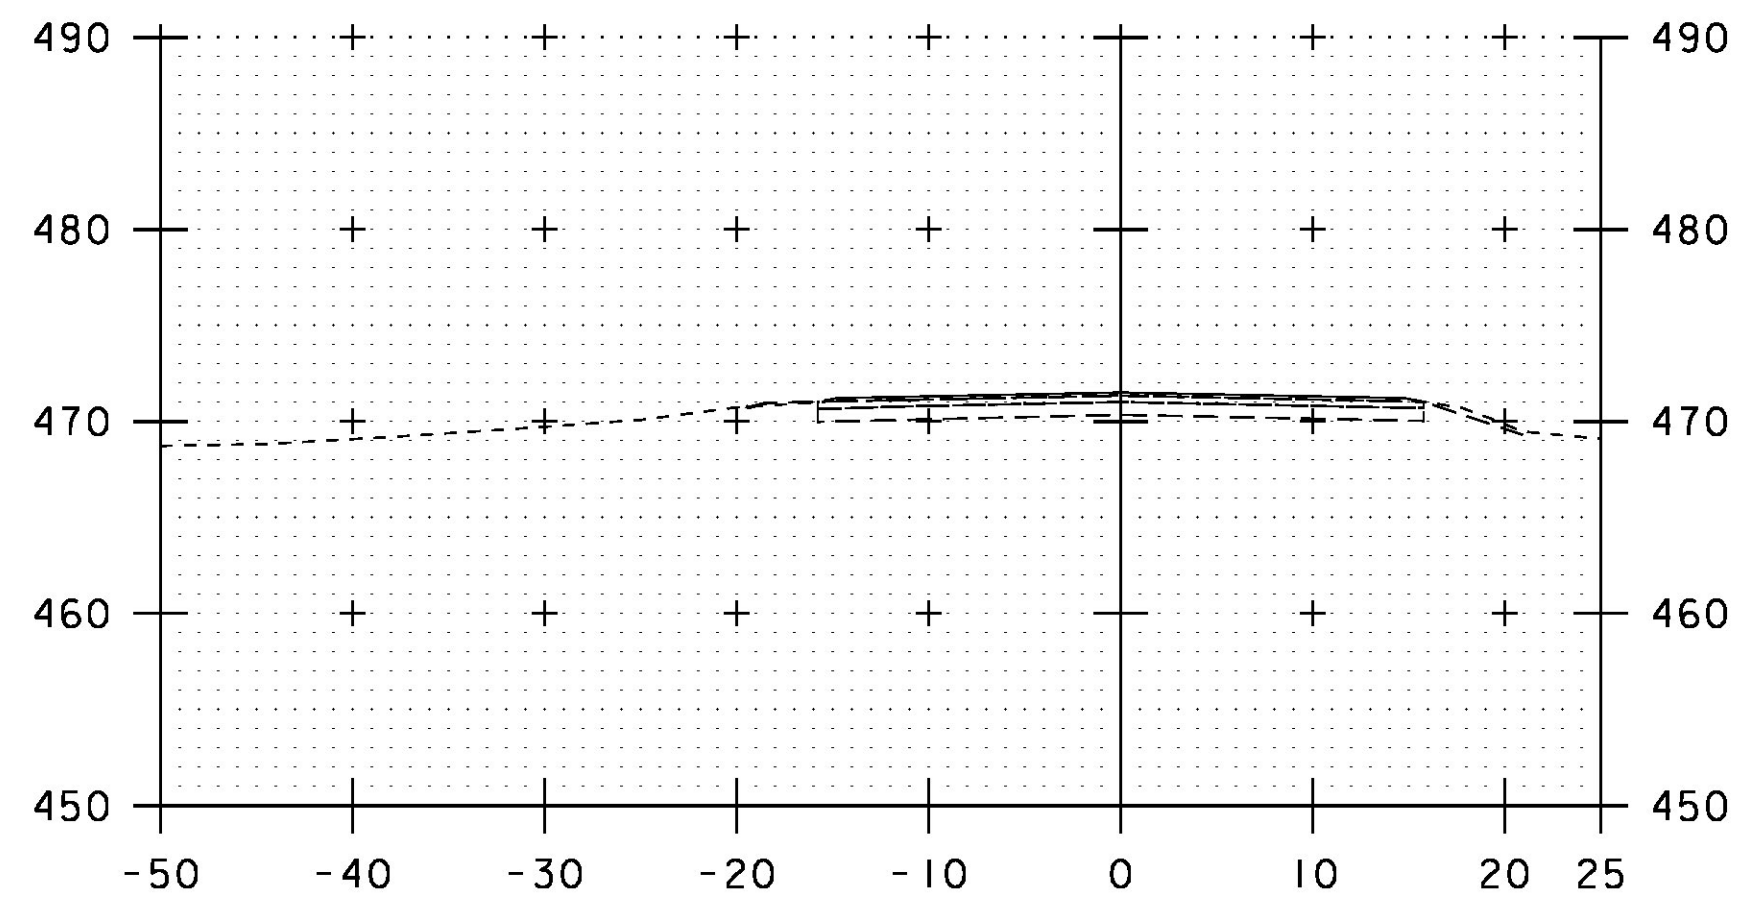

44+50

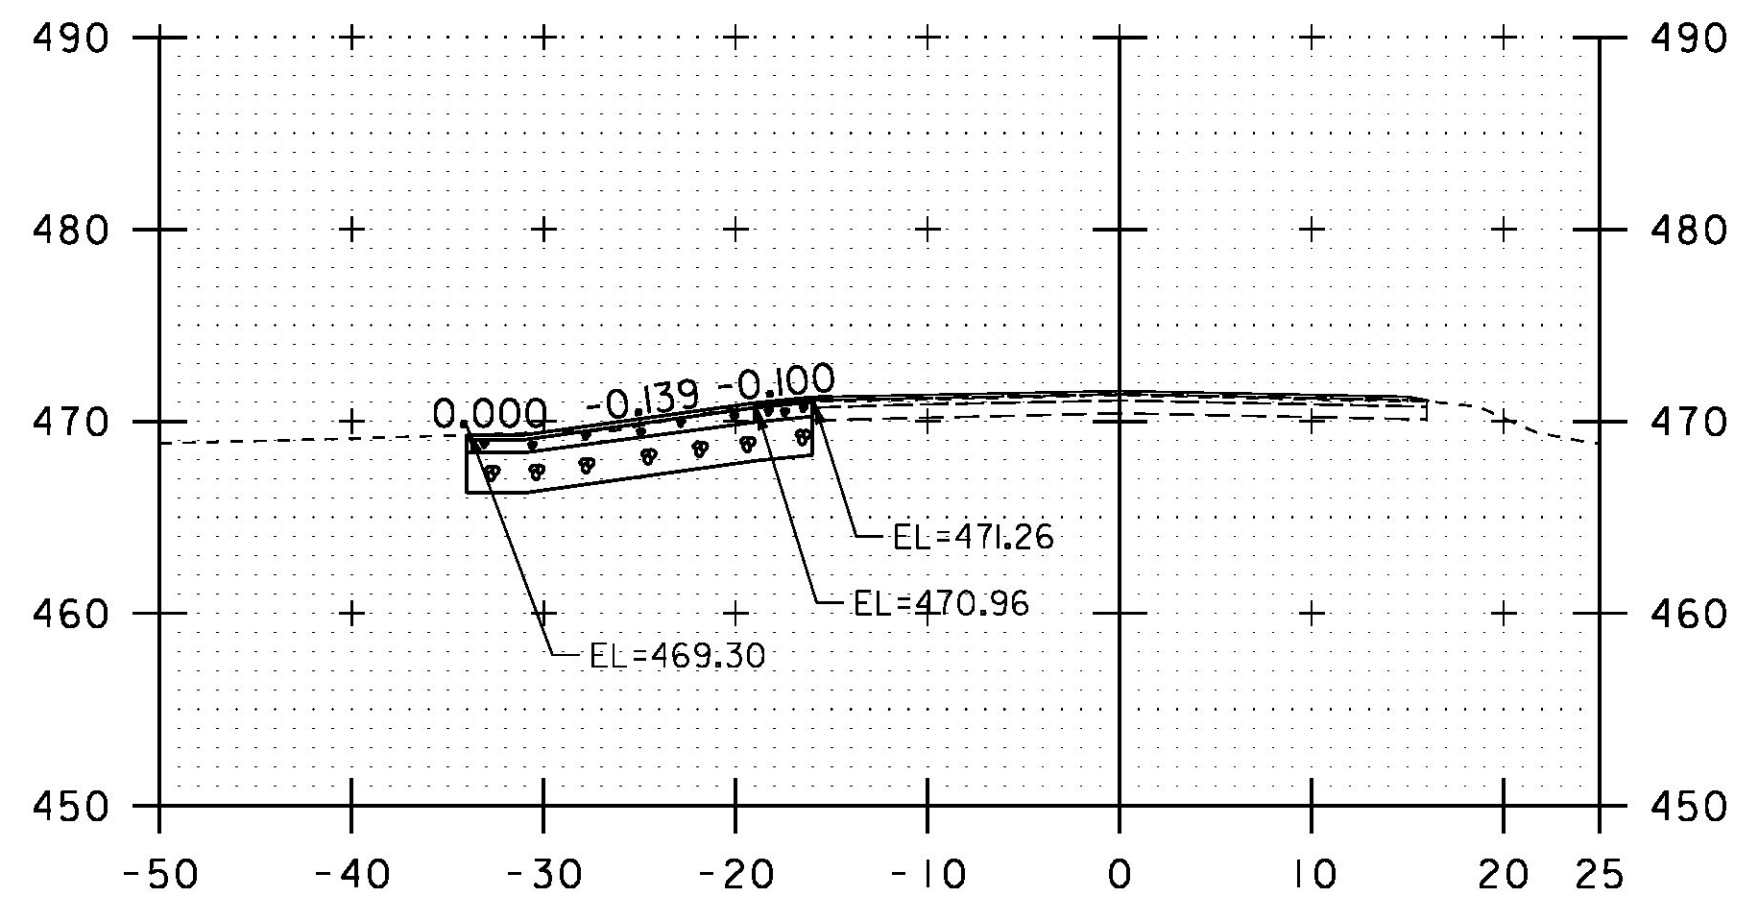

45+25

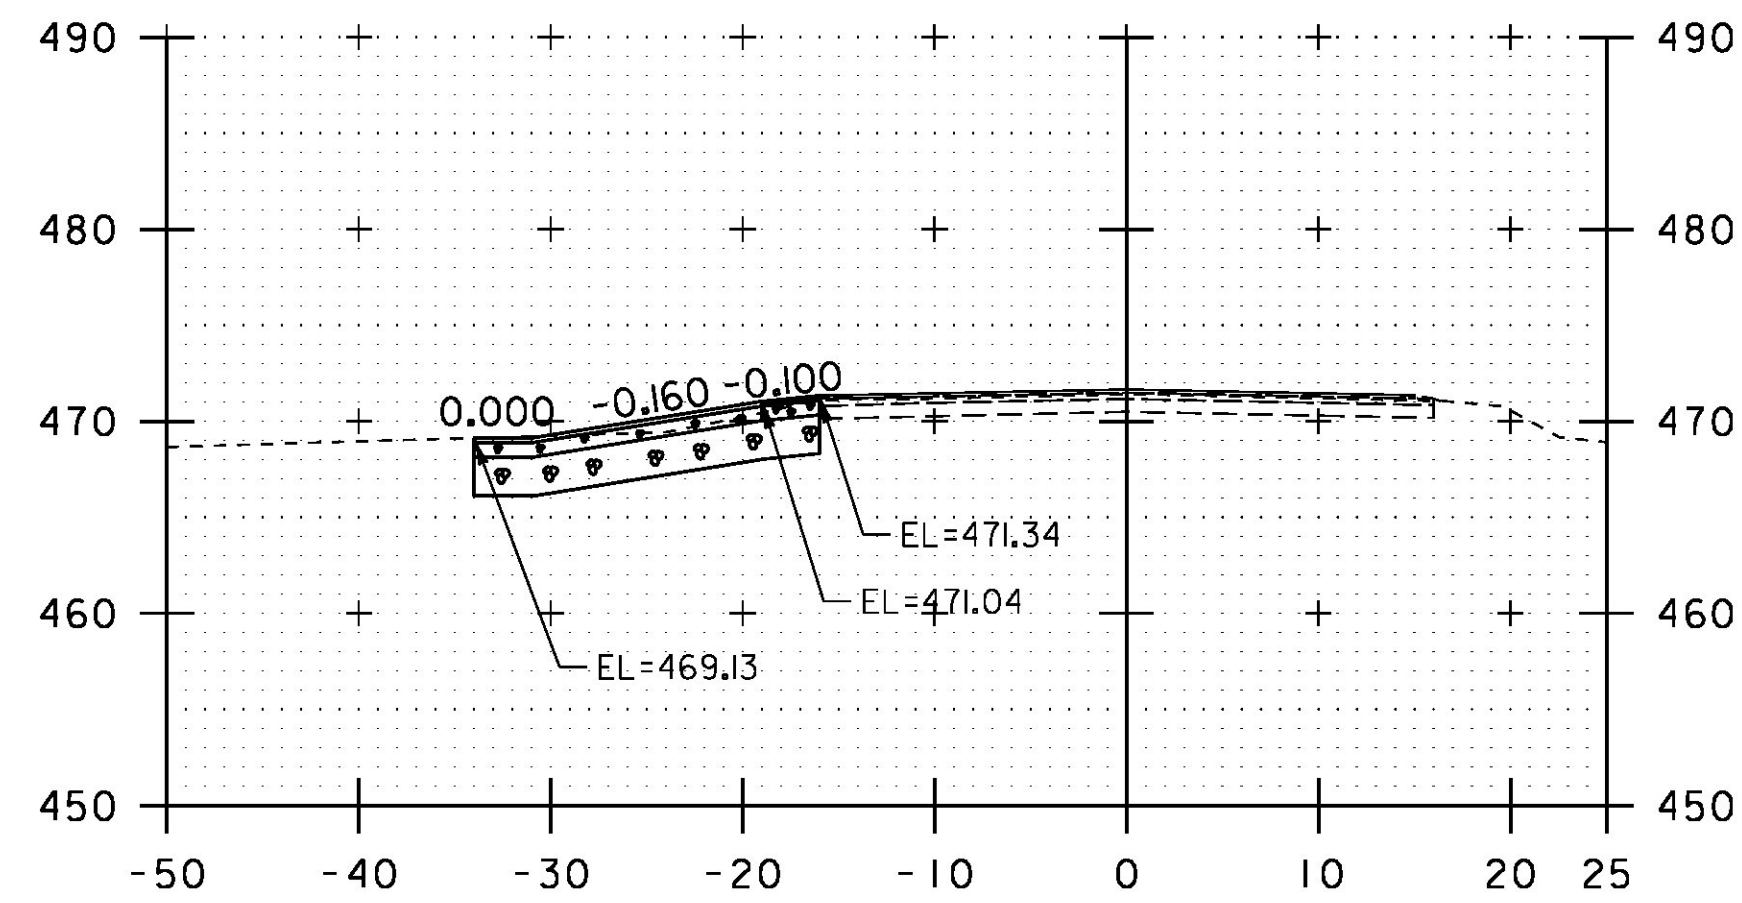

46+00

STA. 44+50 TO STA. 46+50

PROJECT NAME:	ESSEX	PLOT DATE:	08-JUN-2015
PROJECT NUMBER:	STP 2912(2)	DRAWN BY:	N. PAPPAS
FILE NAME:	p14v256_wrk.dgn	CHECKED BY:	M. FOWLER
PROJECT LEADER:	M. FOWLER	GABION MATTRESS CROSS SECTION 1	SHEET 12 OF 17
DESIGNED BY:	N. PAPPAS		