




47+25

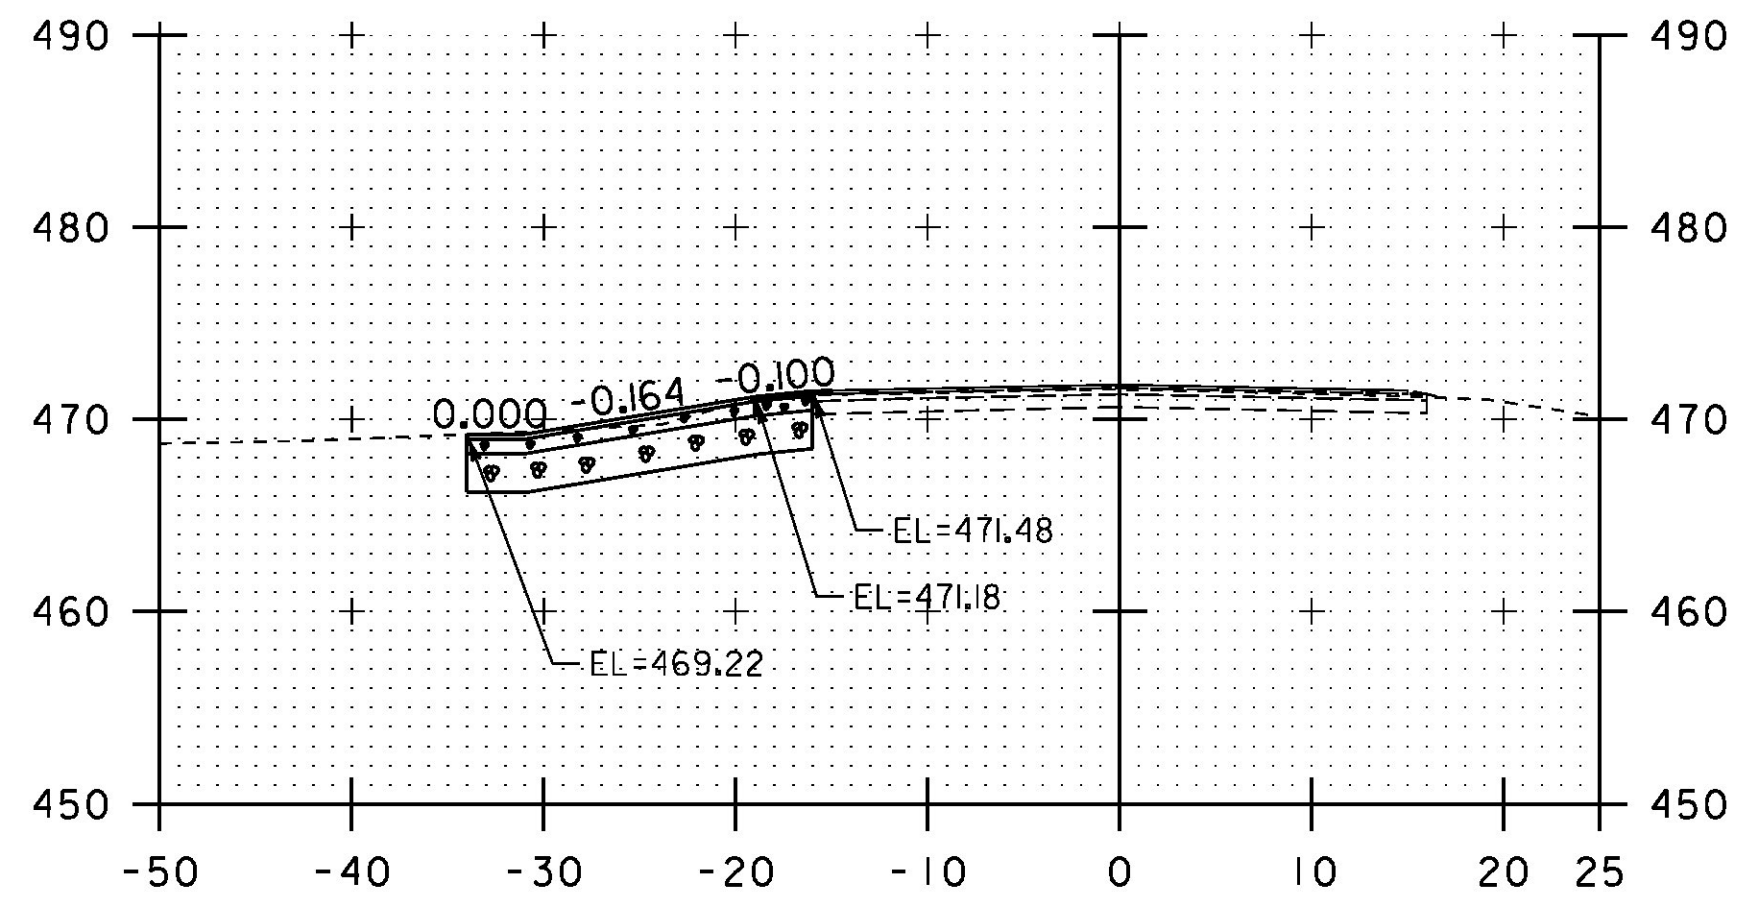


48+00

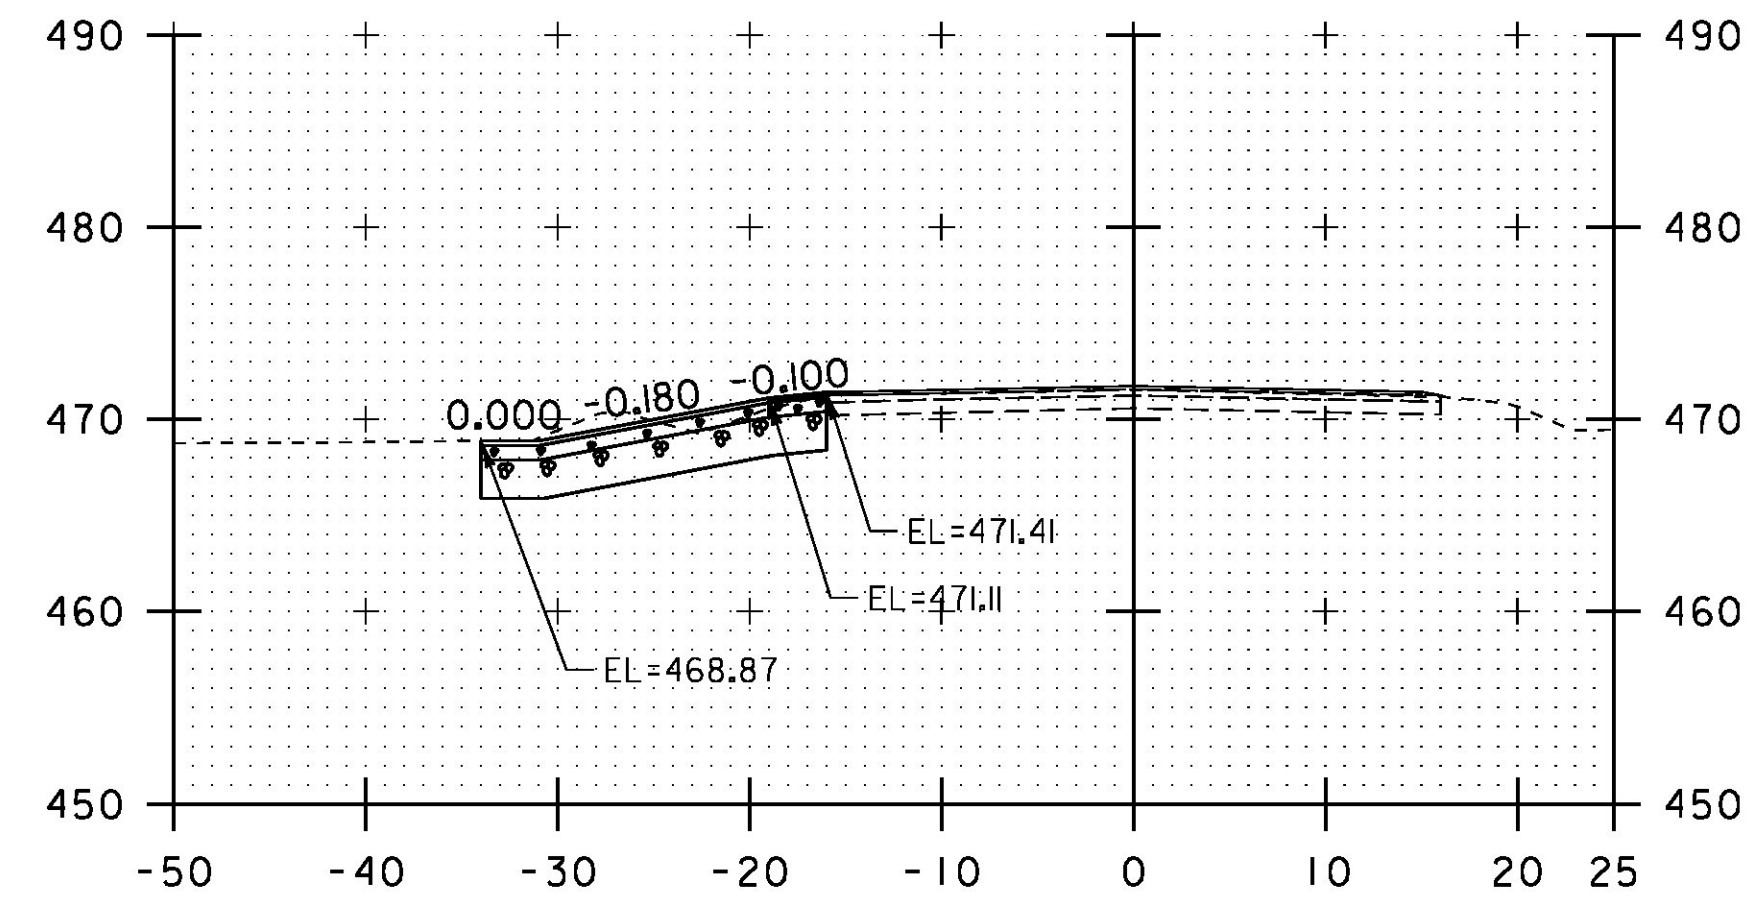


48+75

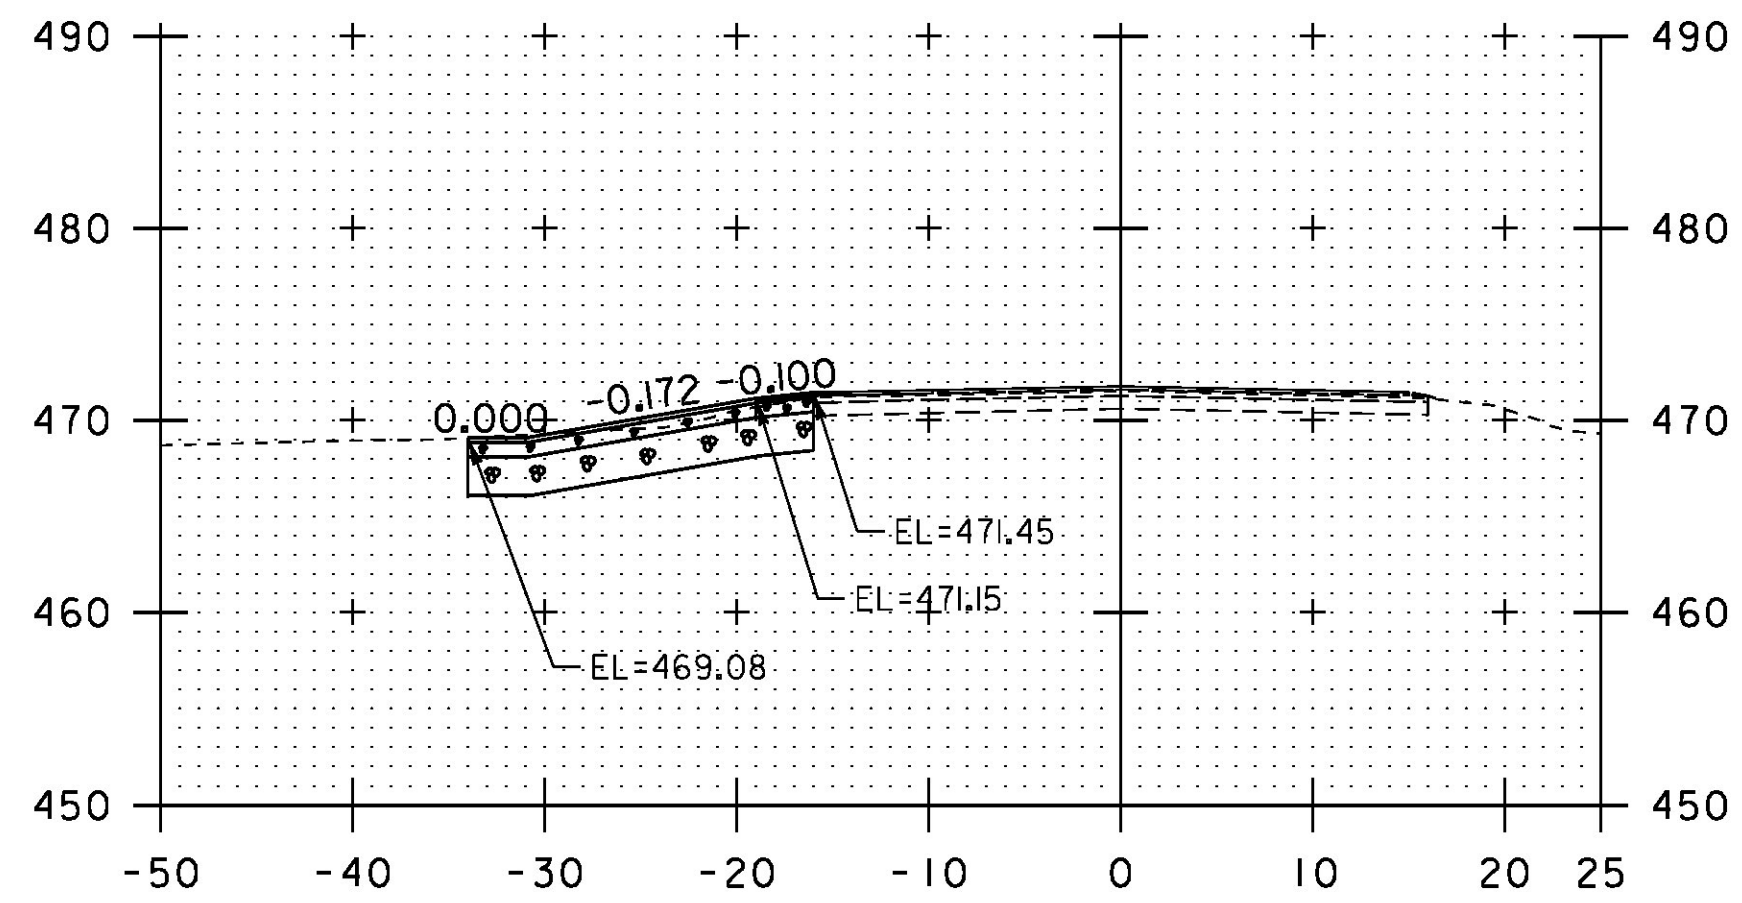


47+00

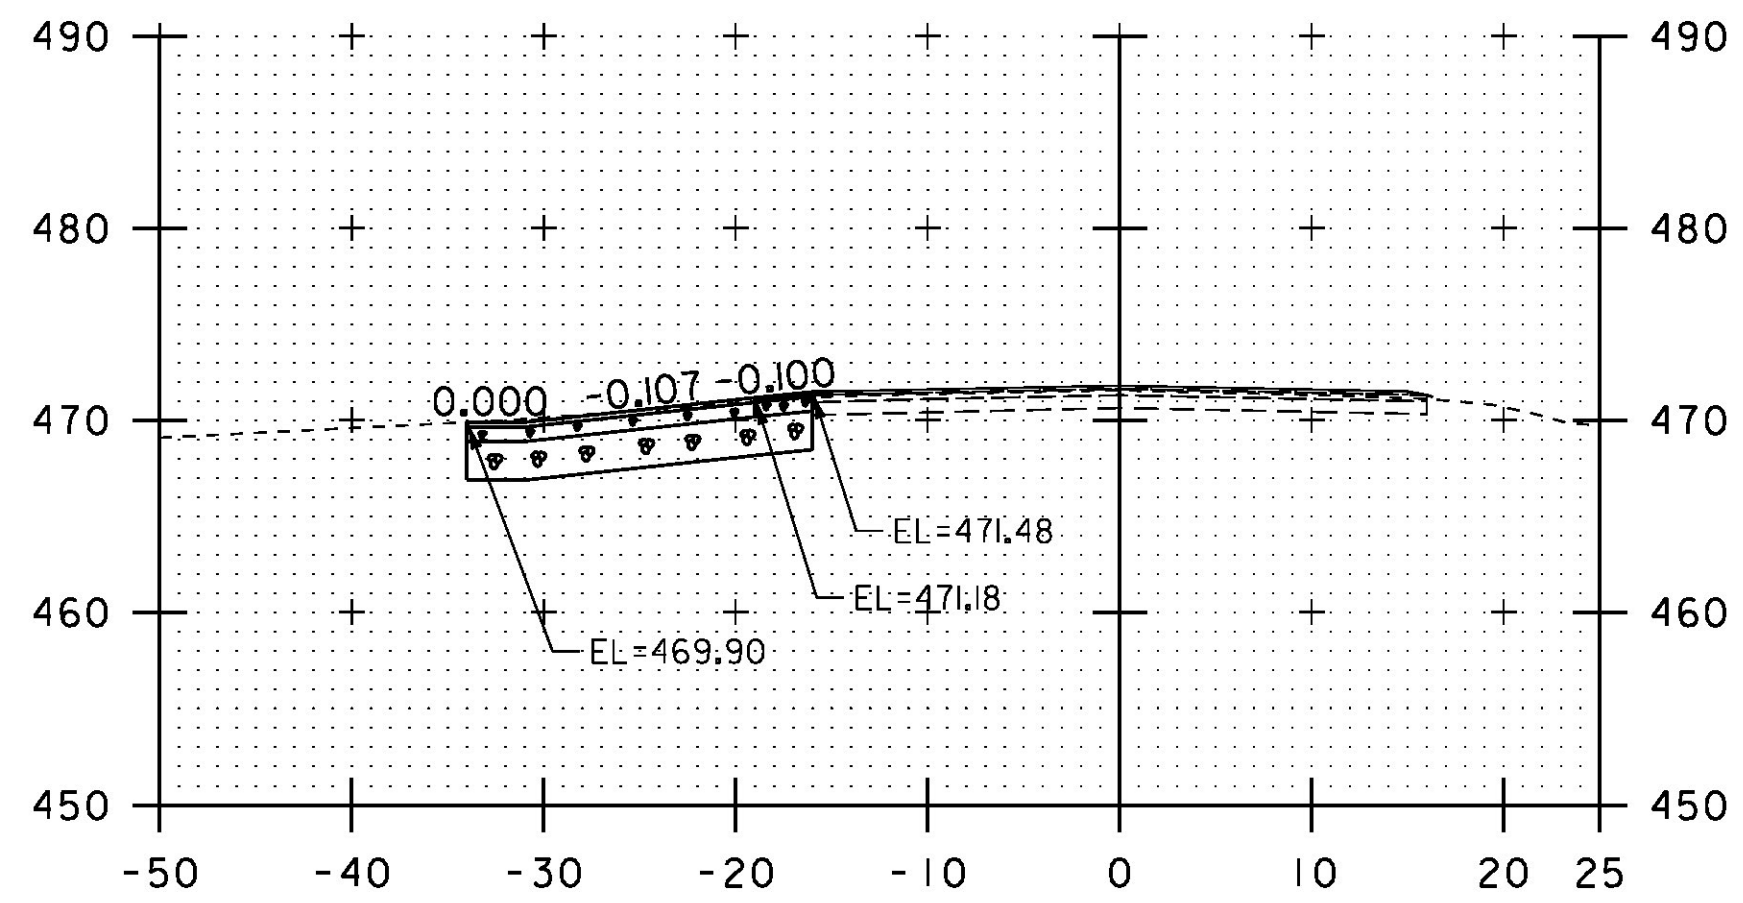


47+75

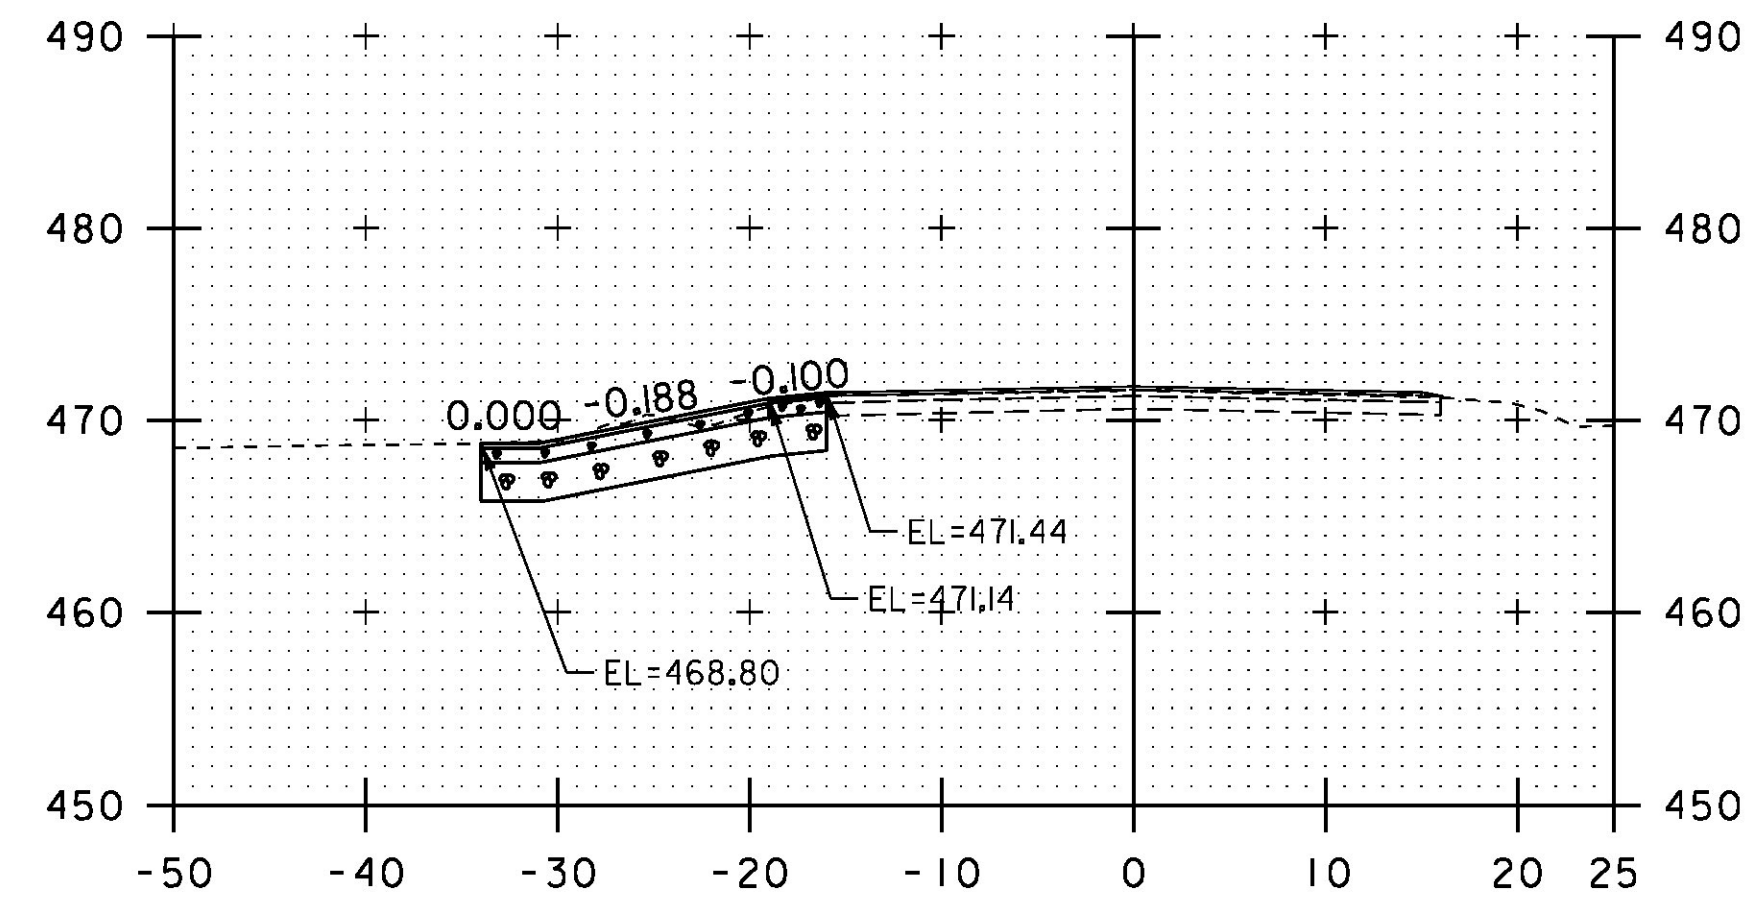


48+50

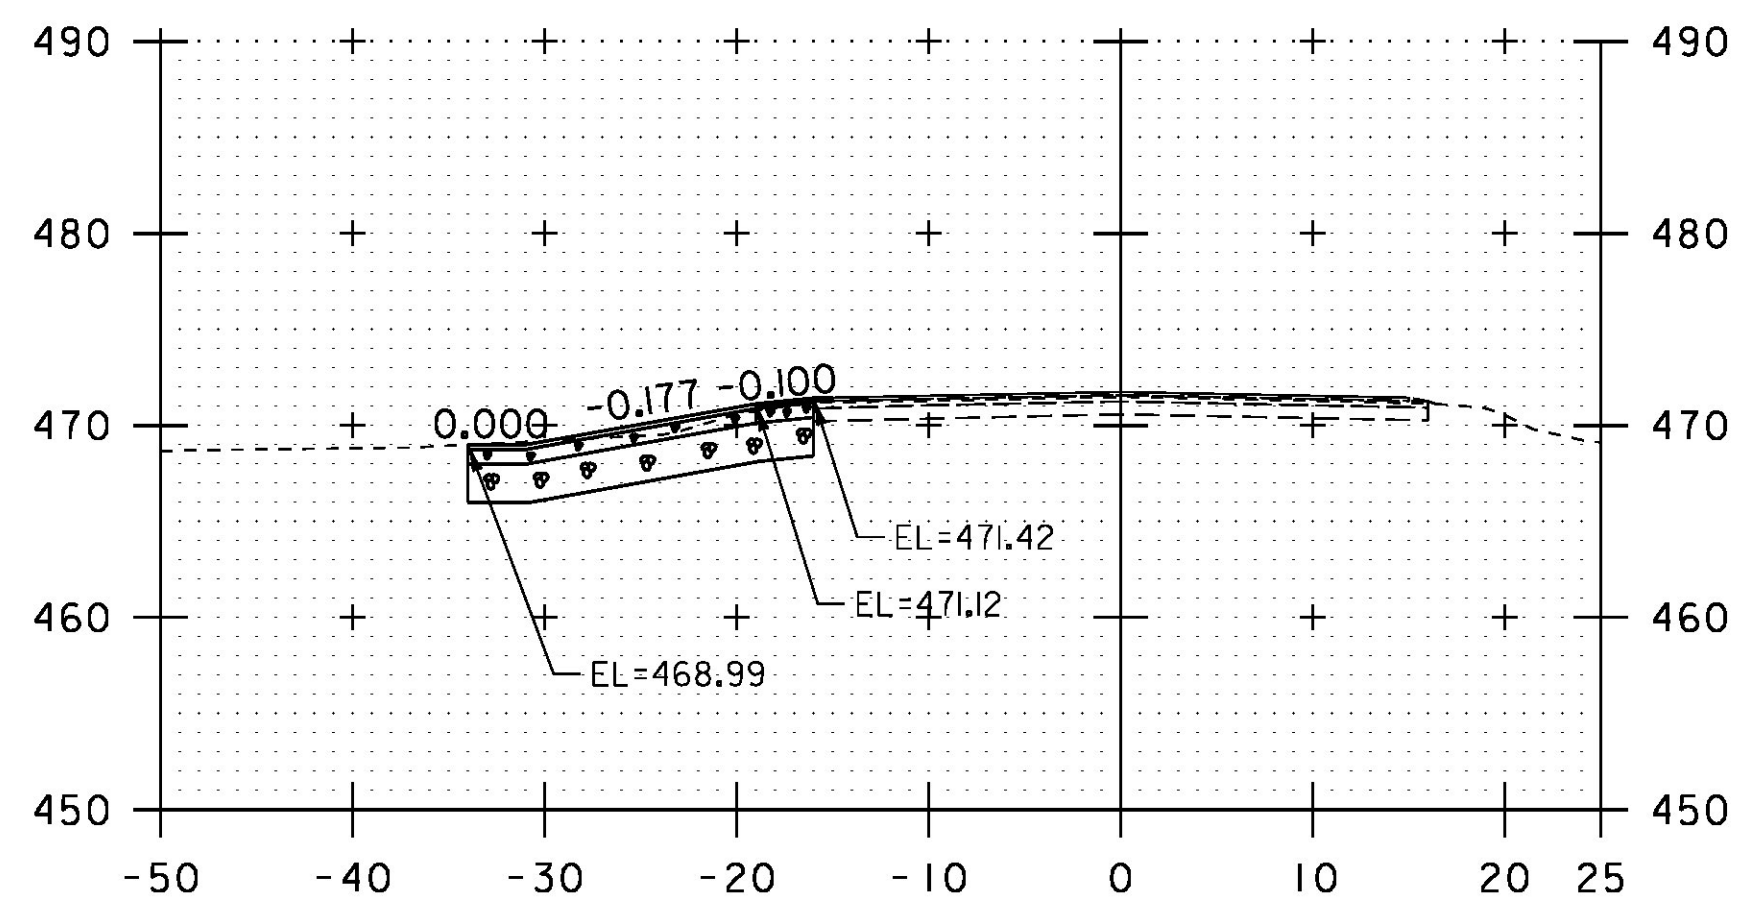

46+75

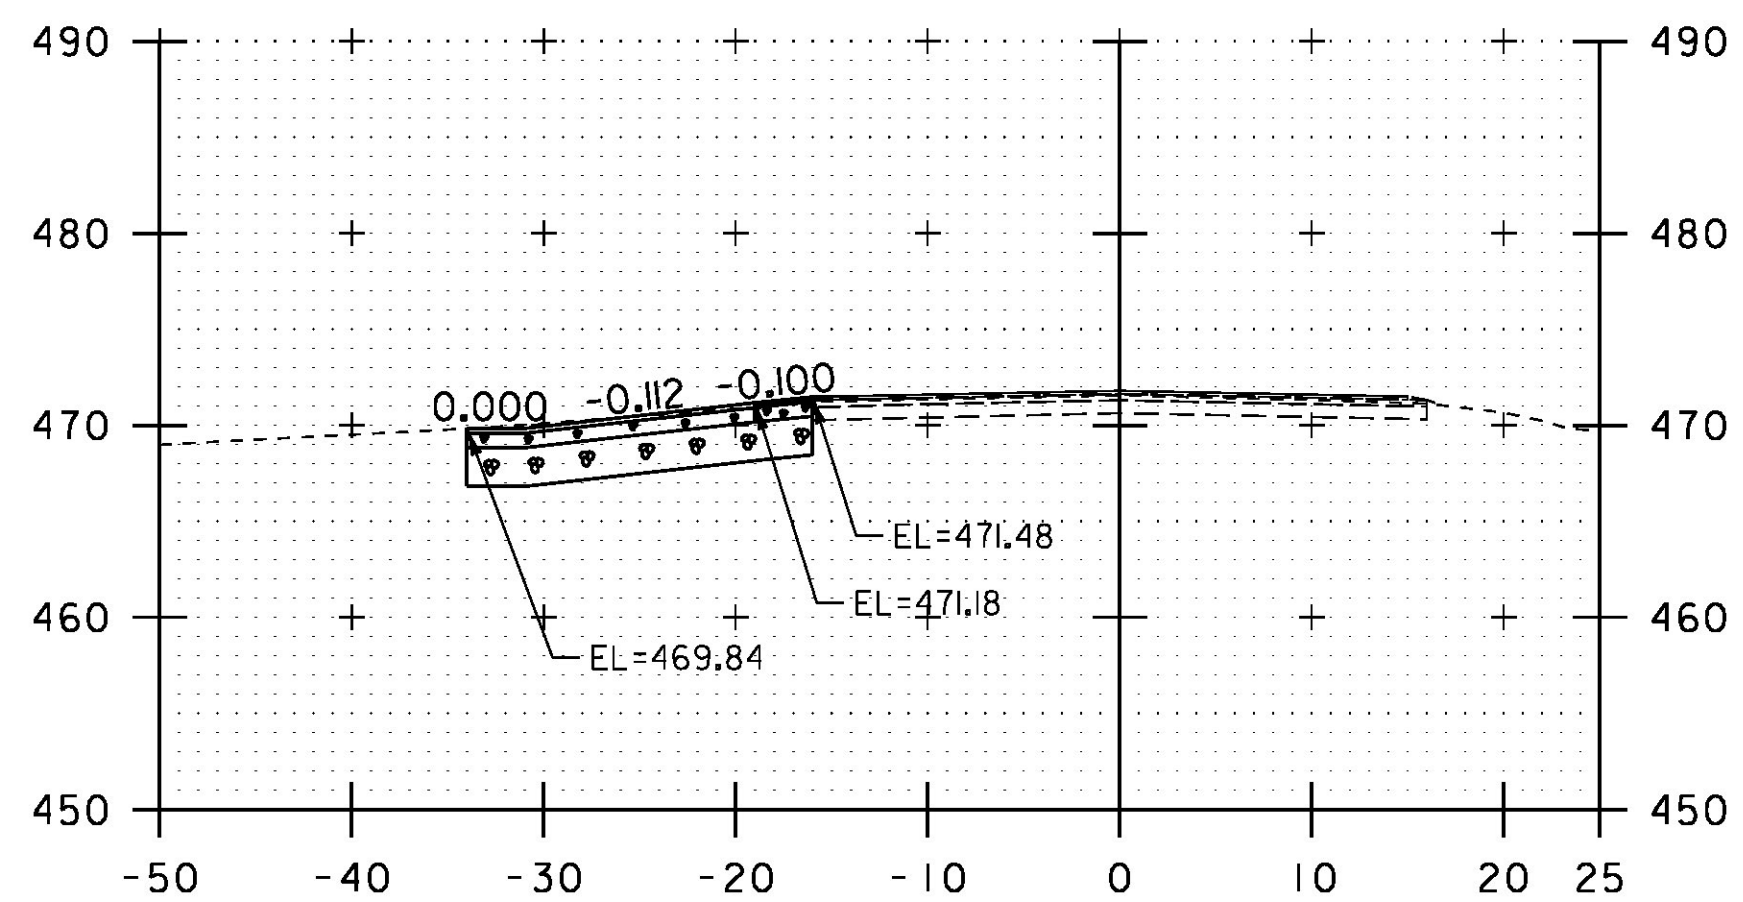

47+50

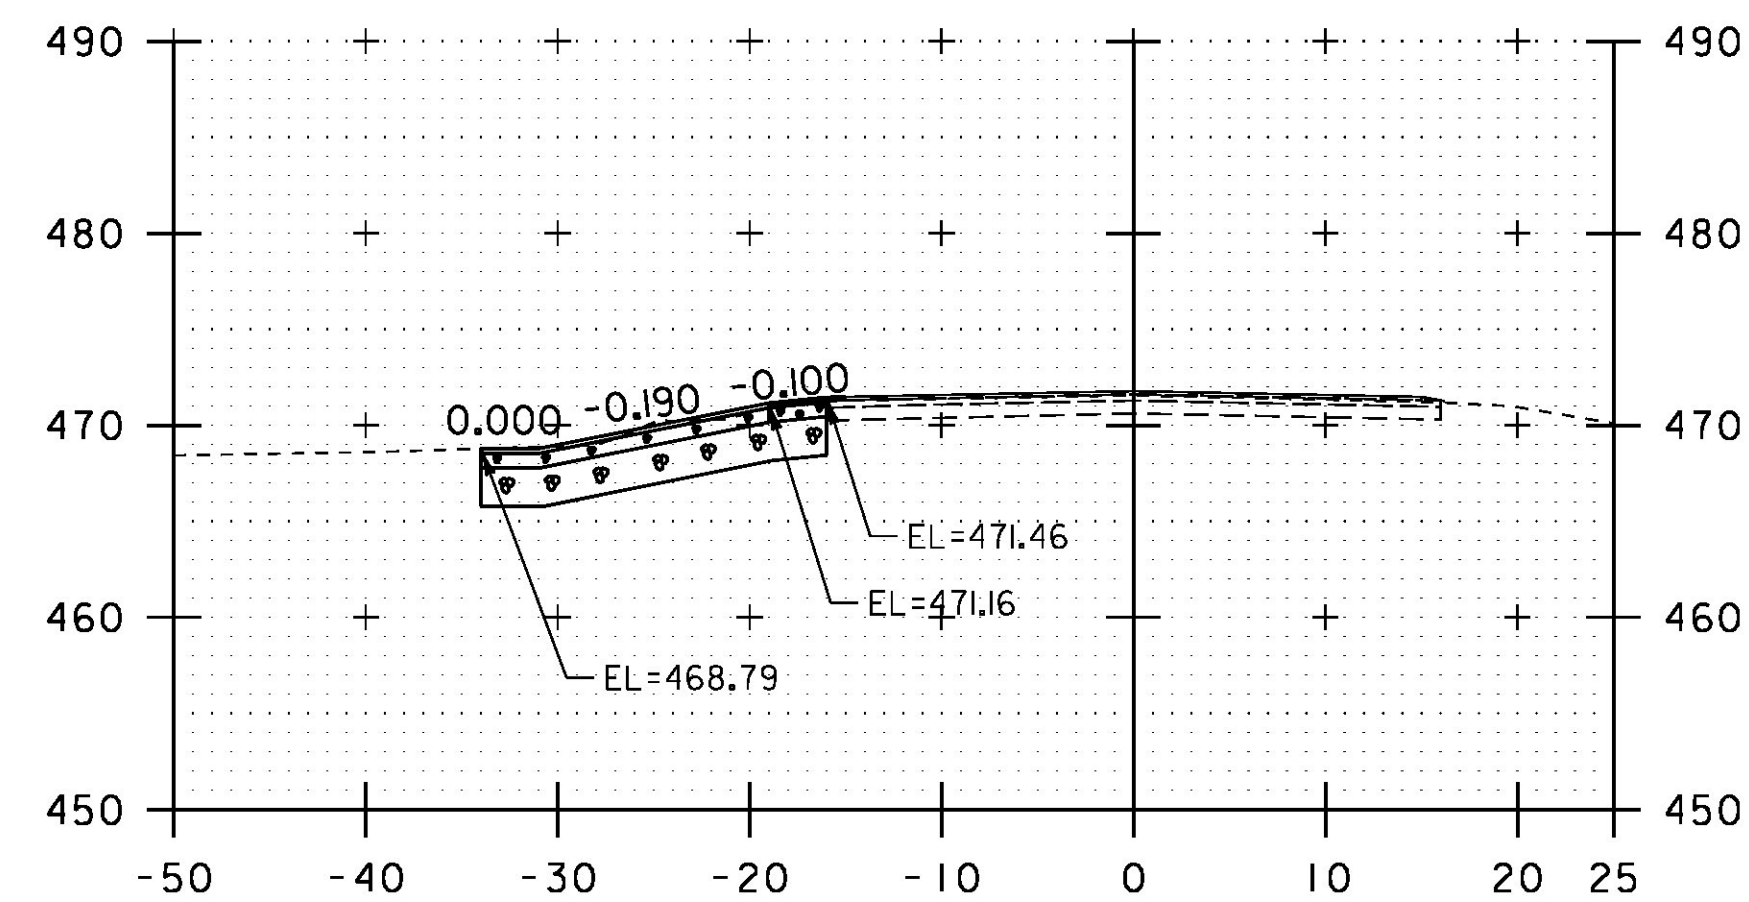

48+25

STA. 46+75 TO STA. 48+75

PROJECT NAME:	ESSEX	PLOT DATE:	08-JUN-2015
PROJECT NUMBER:	STP 2912(2)	DRAWN BY:	N. PAPPAS
FILE NAME:	p14v256_wrk.dgn	DESIGNED BY:	N. PAPPAS
PROJECT LEADER:	M. FOWLER	CHECKED BY:	M. FOWLER
GABBION MATTRESS CROSS SECTION 2		SHEET	13 OF 17