




49+50

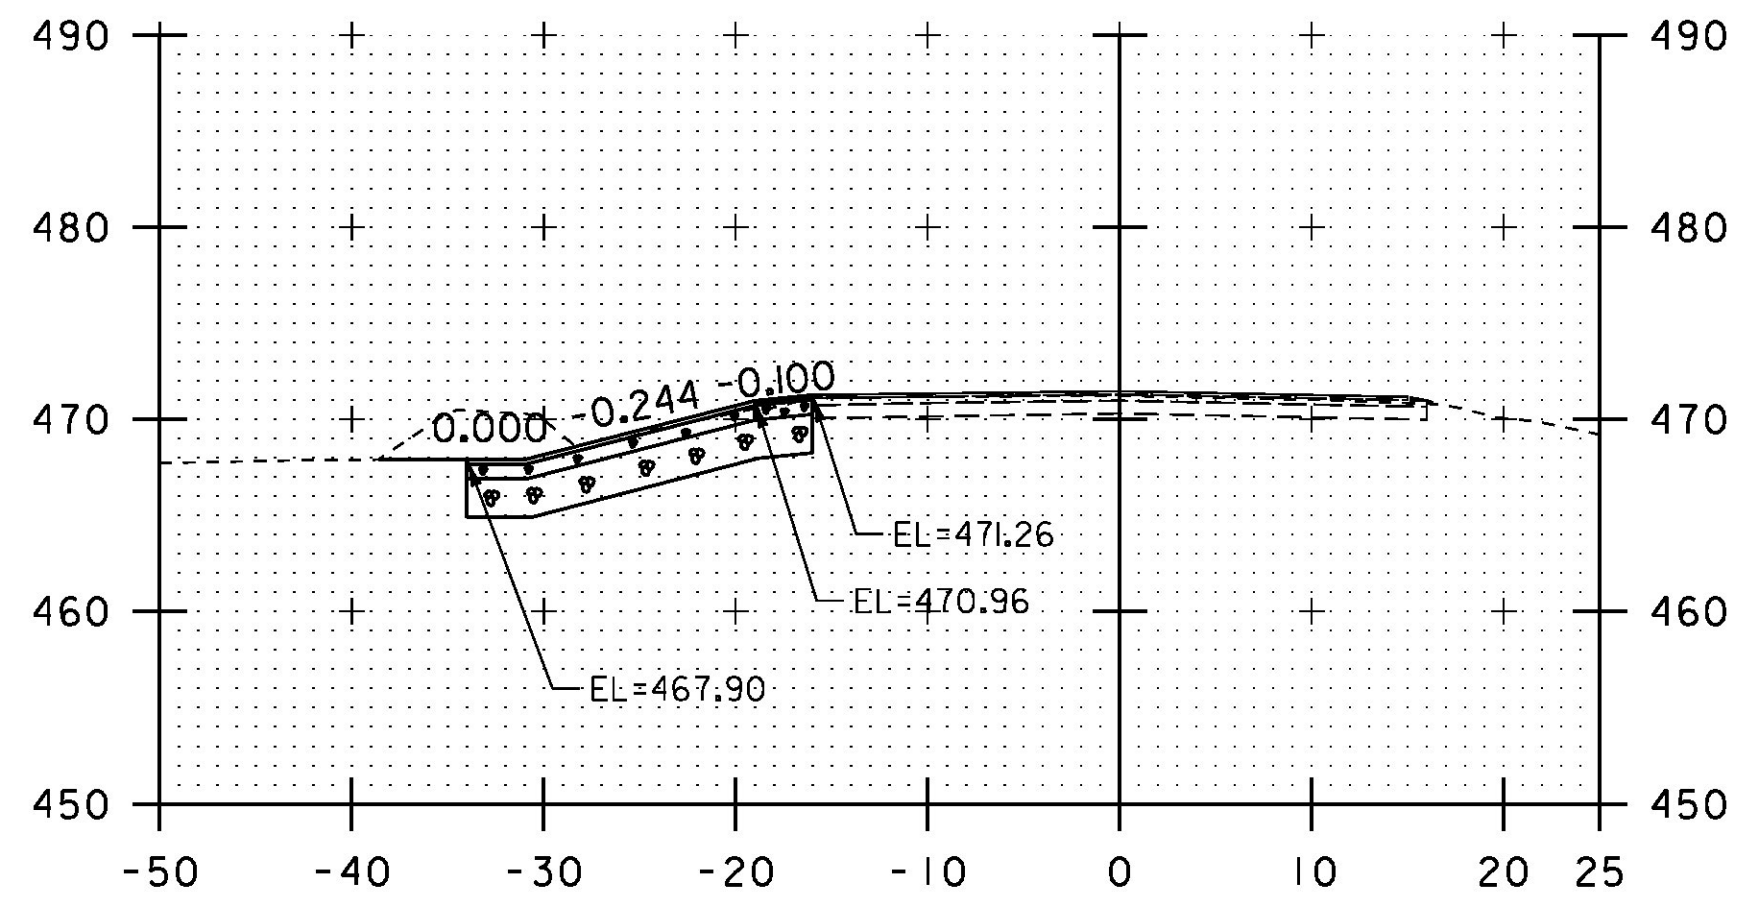


50+25

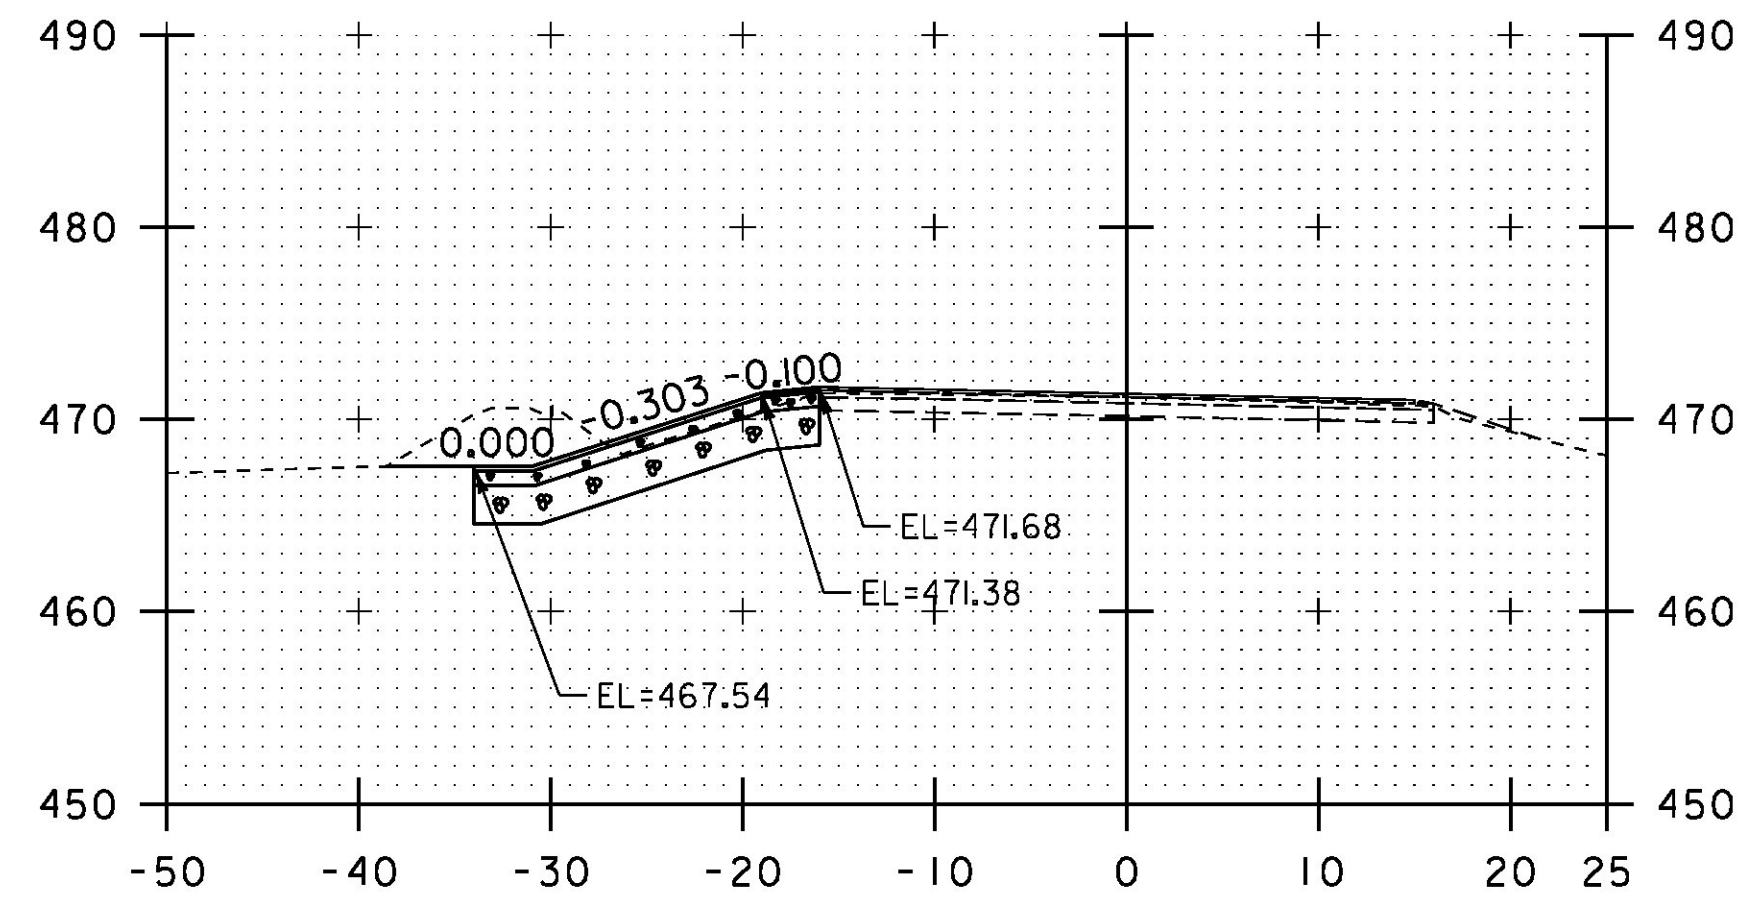


51+00

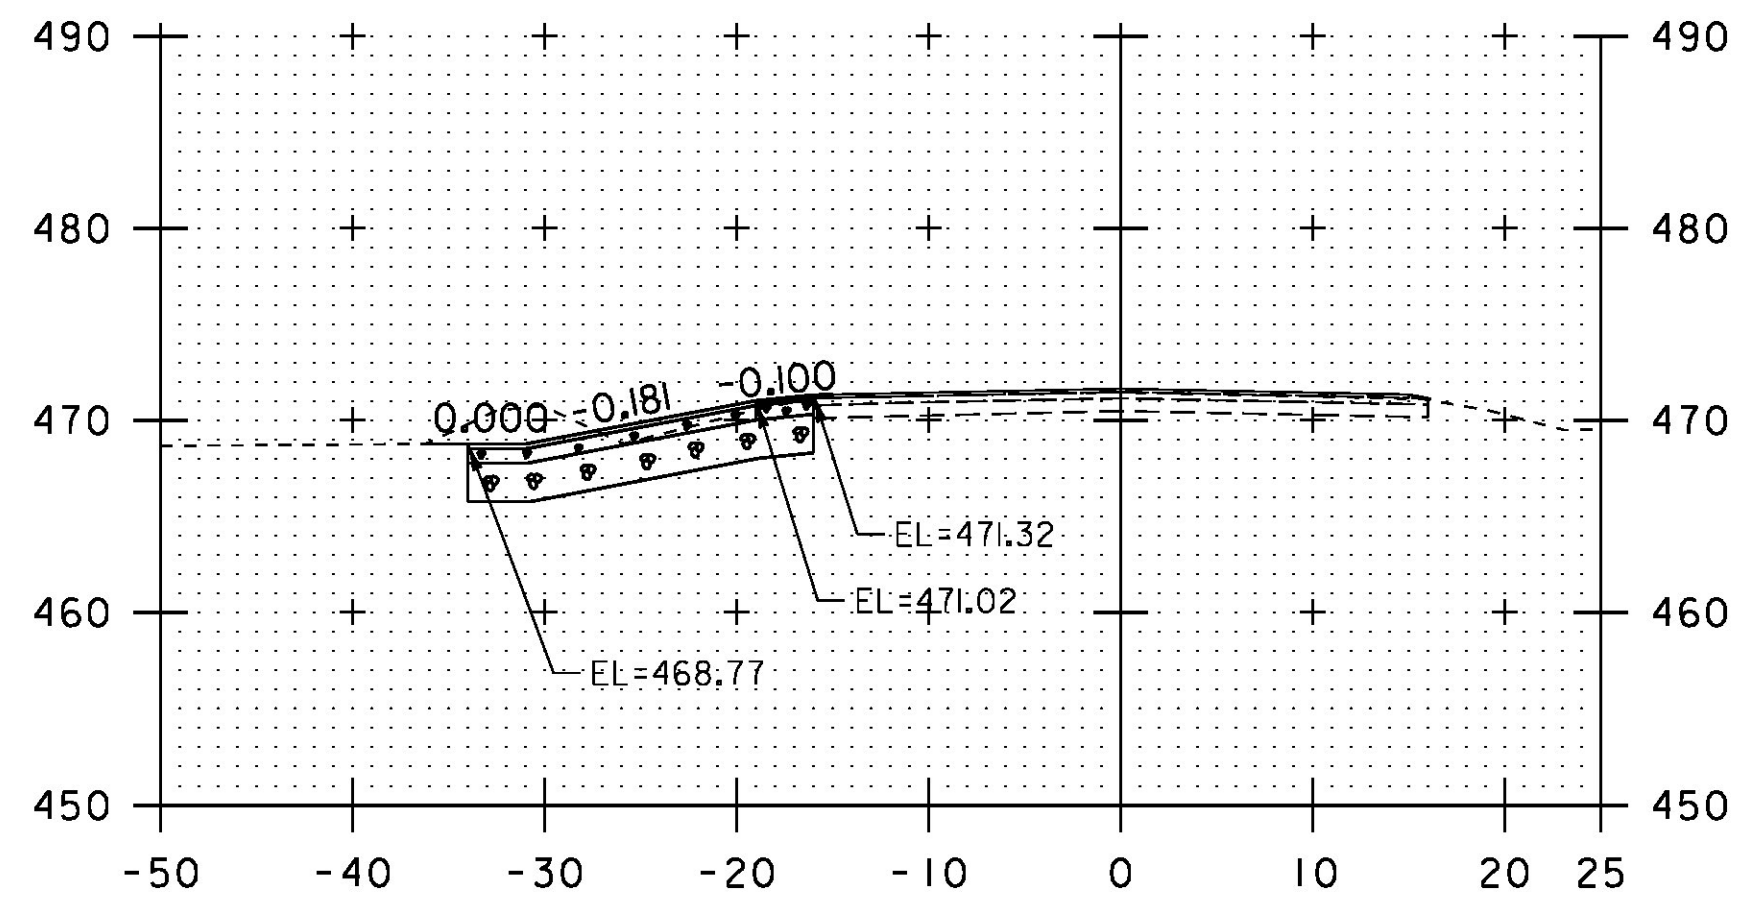


49+25

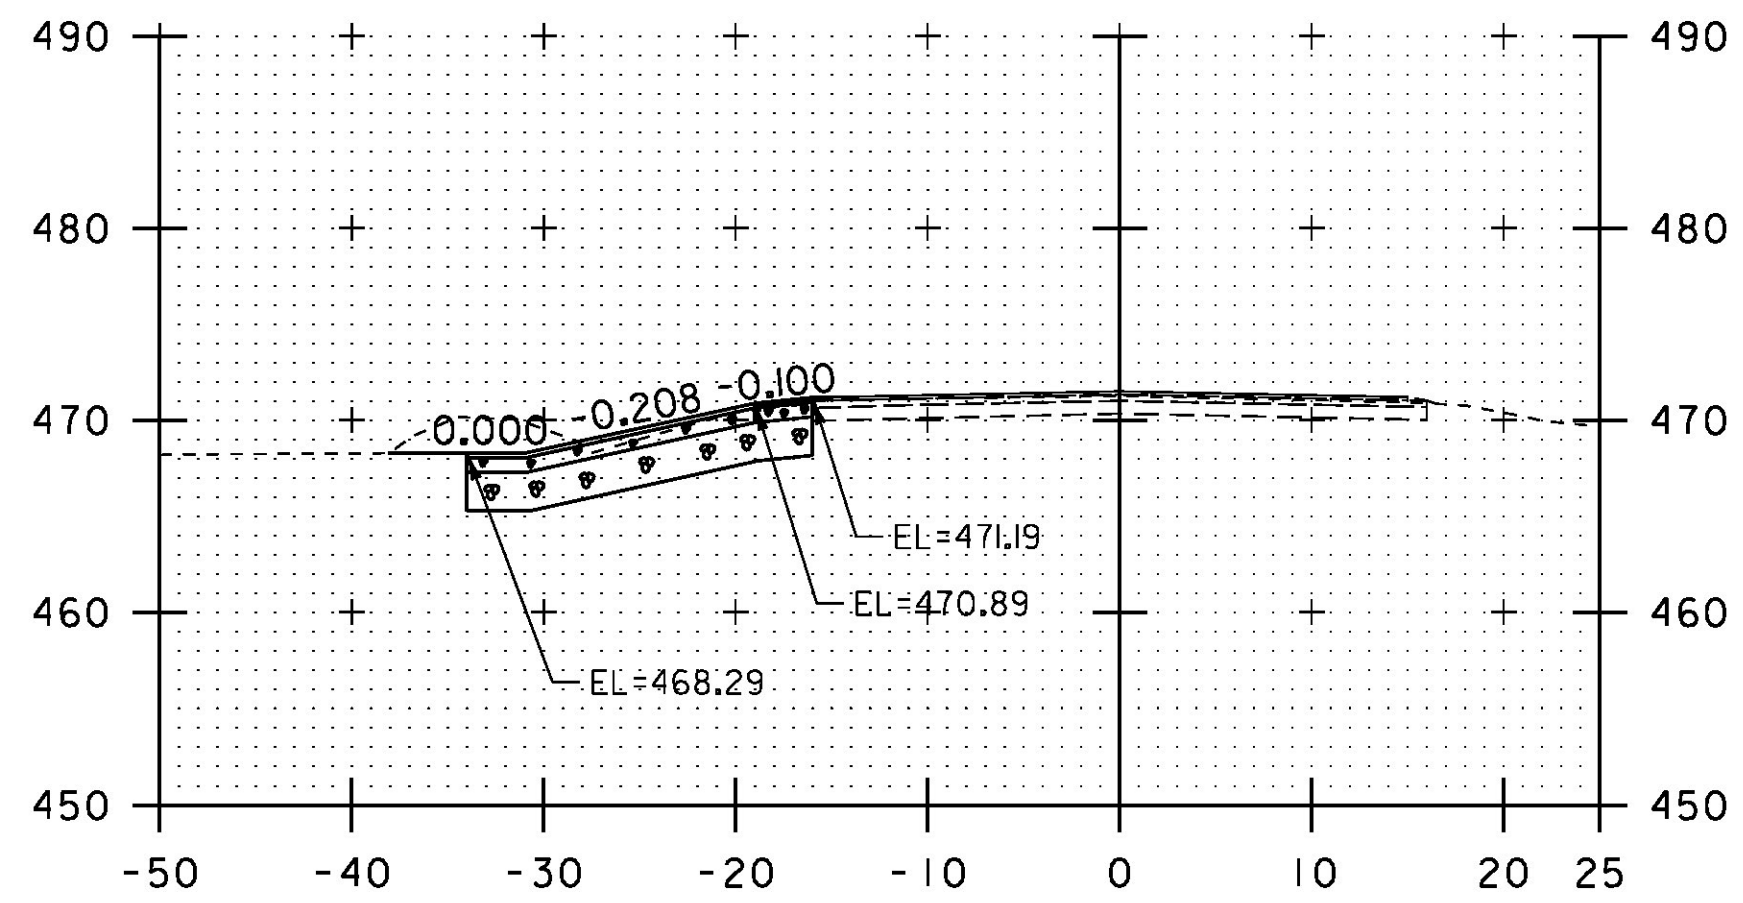


50+00

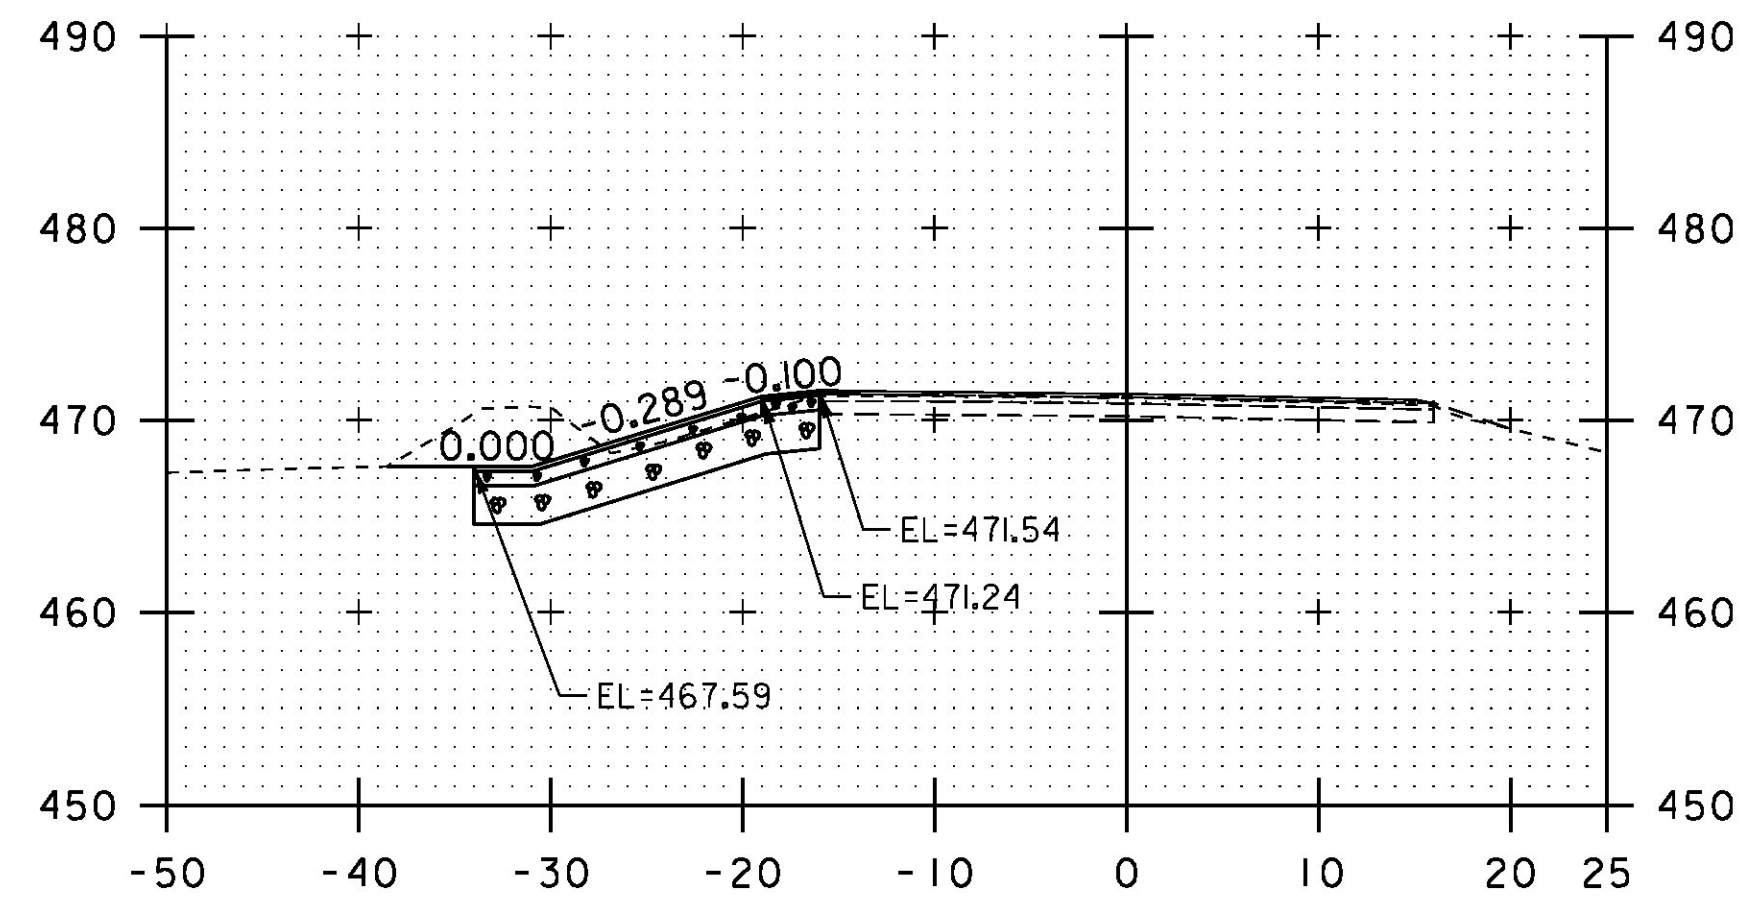


50+75

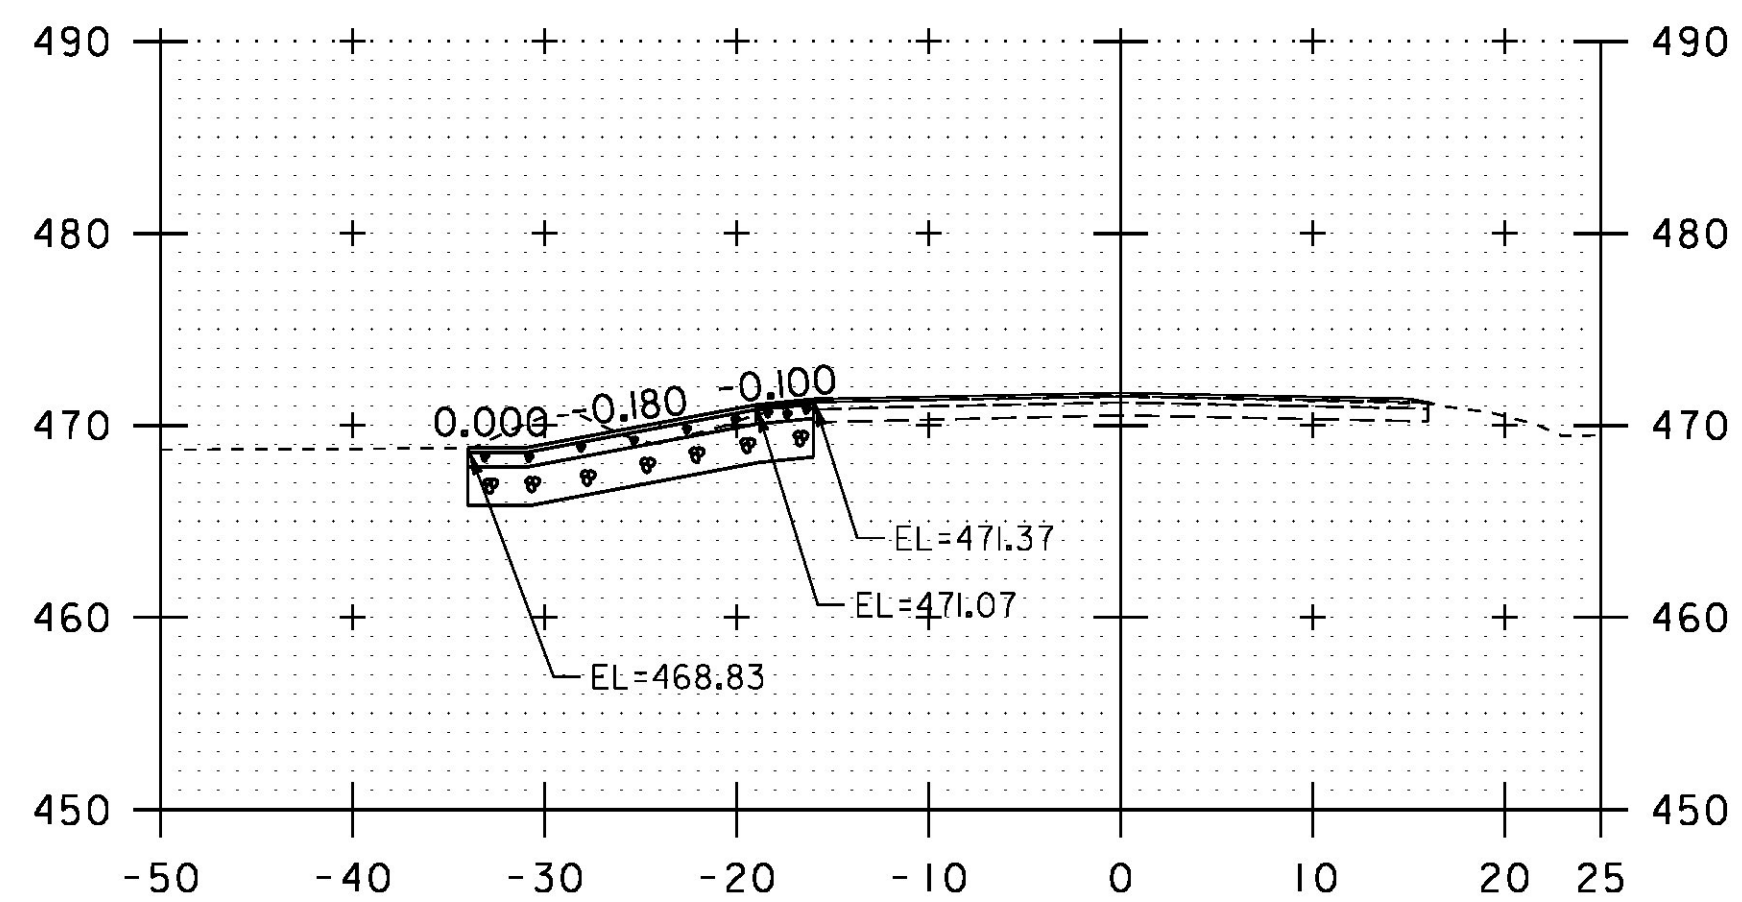

49+00

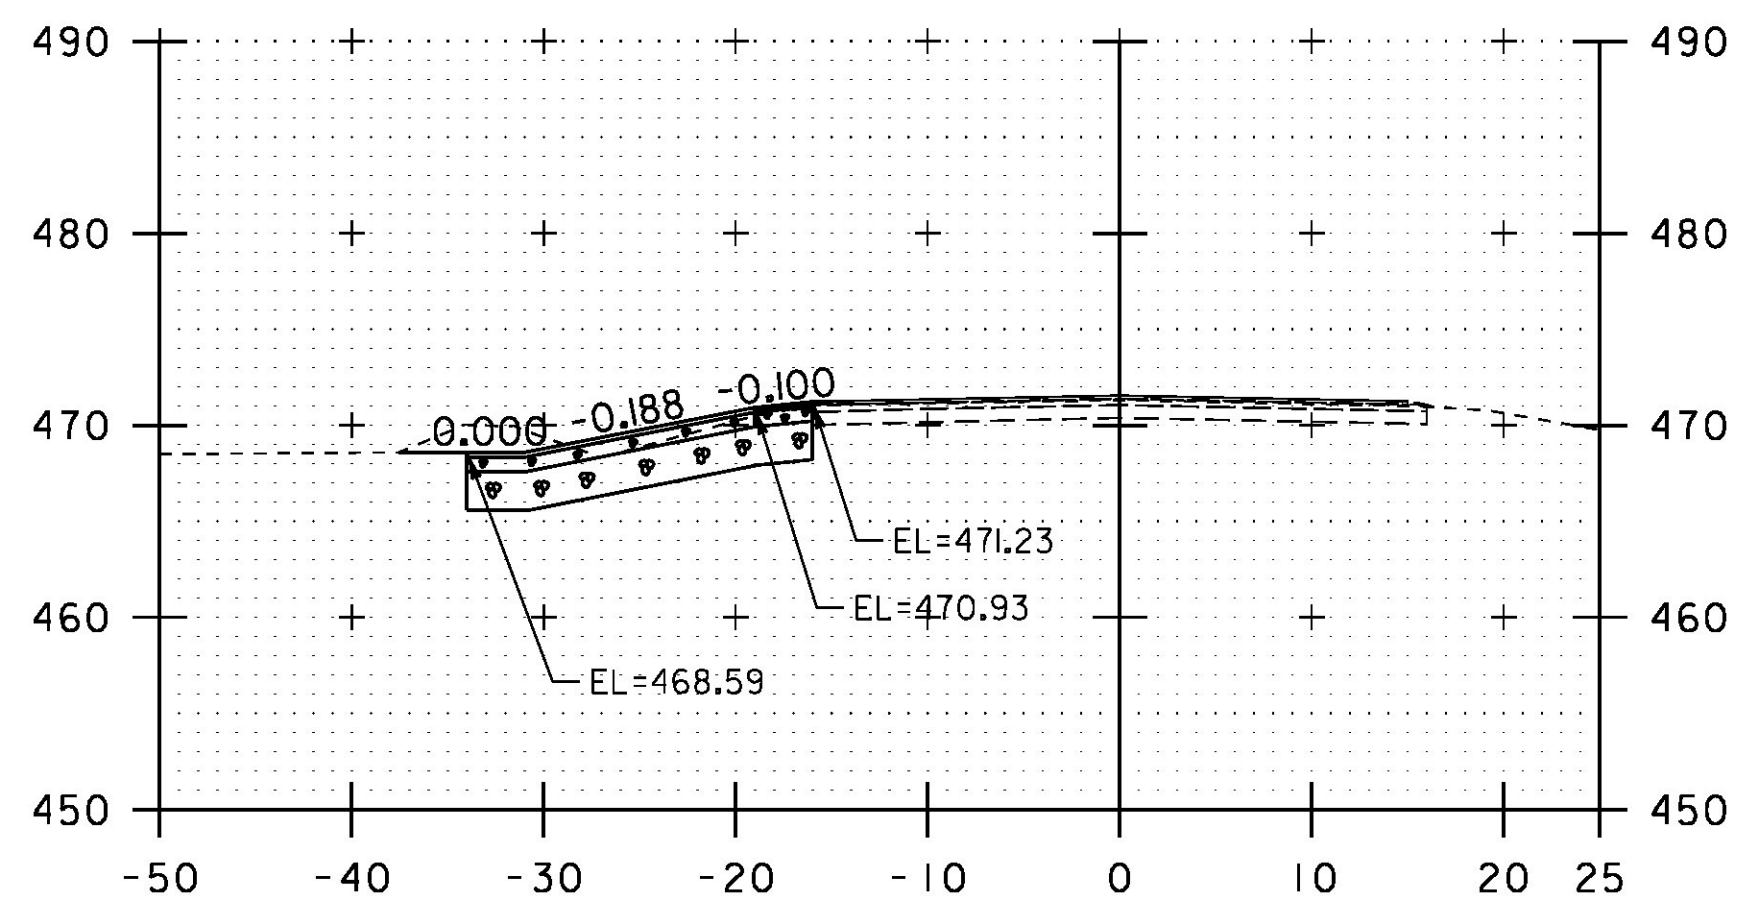

49+75

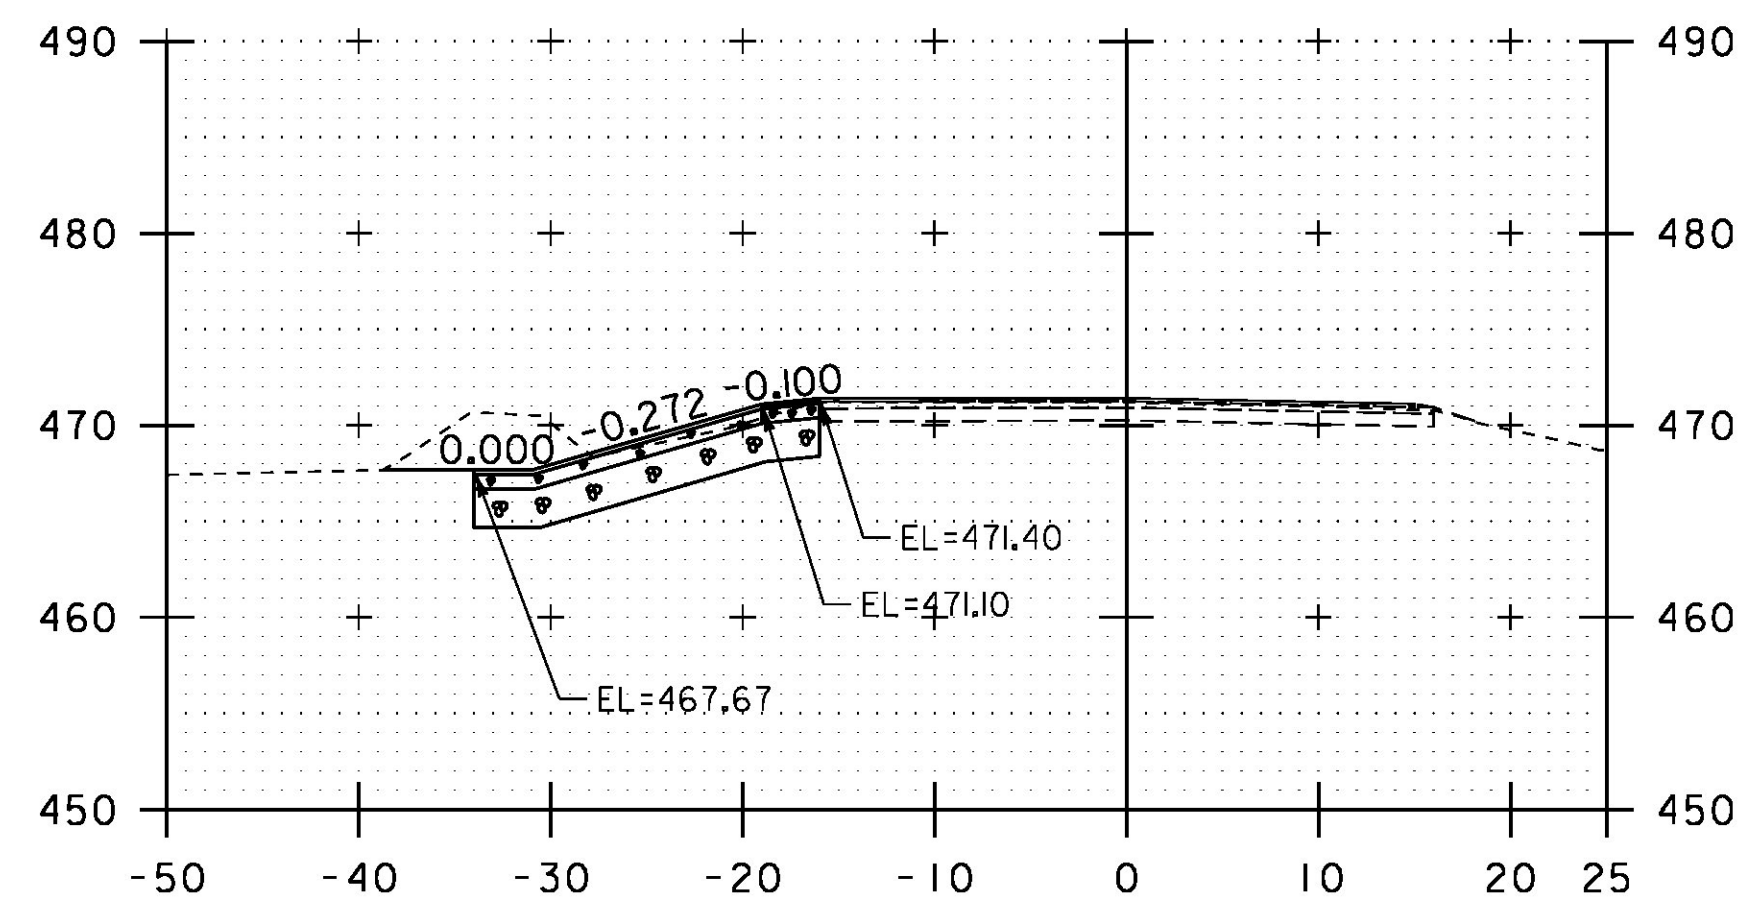

50+50

STA. 49+00 TO STA. 51+00

PROJECT NAME:	ESSEX	PLOT DATE:	08-JUN-2015
PROJECT NUMBER:	STP 2912(2)	DRAWN BY:	N. PAPPAS
FILE NAME:	p14v256_wrk.dgn	DESIGNED BY:	N. PAPPAS
PROJECT LEADER:	M. FOWLER	CHECKED BY:	M. FOWLER
GABION MATTRESS CROSS SECTION 3		SHEET 14 OF 17	