

STATE OF VERMONT  
AGENCY OF TRANSPORTATION






PROPOSED IMPROVEMENT  
BRIDGE PROJECT  
TOWN OF LUDLOW  
COUNTY OF WINDSOR

VT ROUTE 100 (MINOR ARTERIAL) BRIDGE NO. 99

PROJECT LOCATION: LOCATED IN THE TOWN OF LUDLOW, ON VT 100, APPROXIMATELY 0.028 MILES EASTERLY FROM THE INTERSECTION WITH VT 103.

PROJECT DESCRIPTION: WORK TO BE PERFORMED UNDER THIS PROJECT INCLUDES THE REPLACEMENT OF THE EXISTING BRIDGE DECK INCLUDING RELATED APPROACH WORK.

LENGTH OF STRUCTURE: 84.00 FEET  
LENGTH OF ROADWAY: 139.00 FEET  
LENGTH OF PROJECT: 223.00 FEET

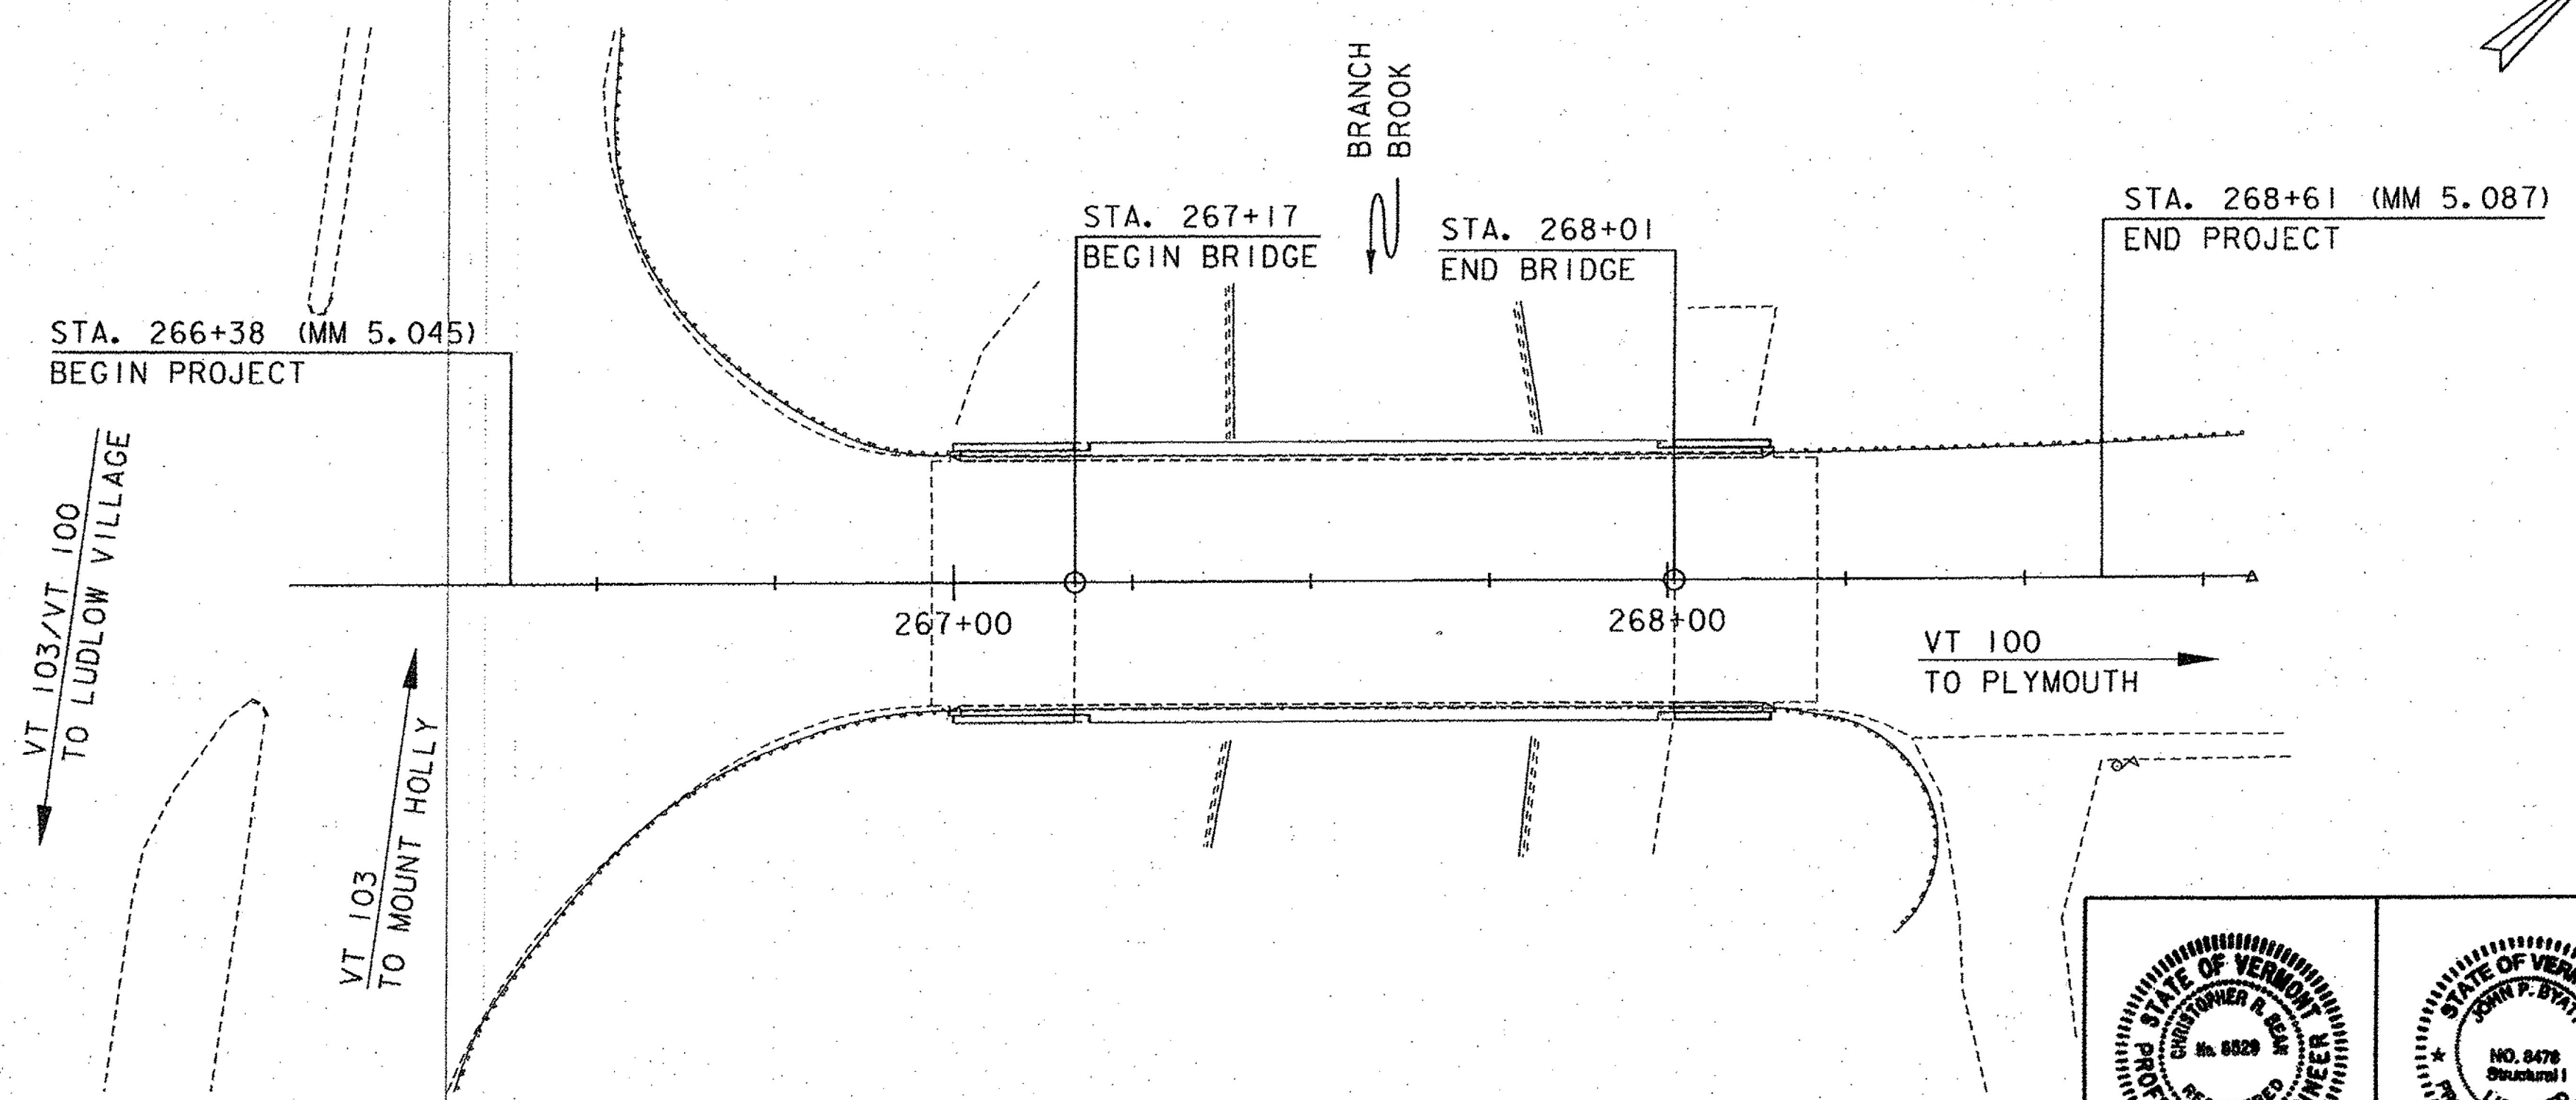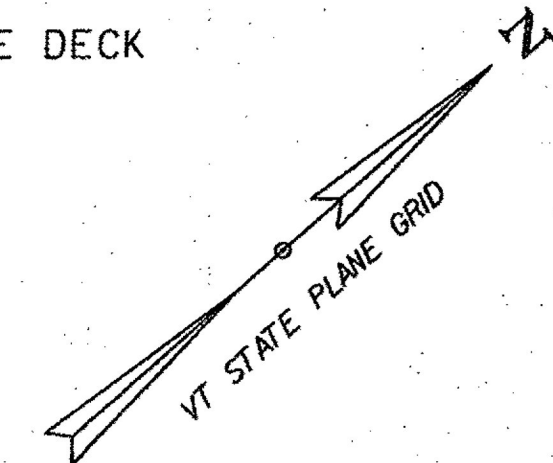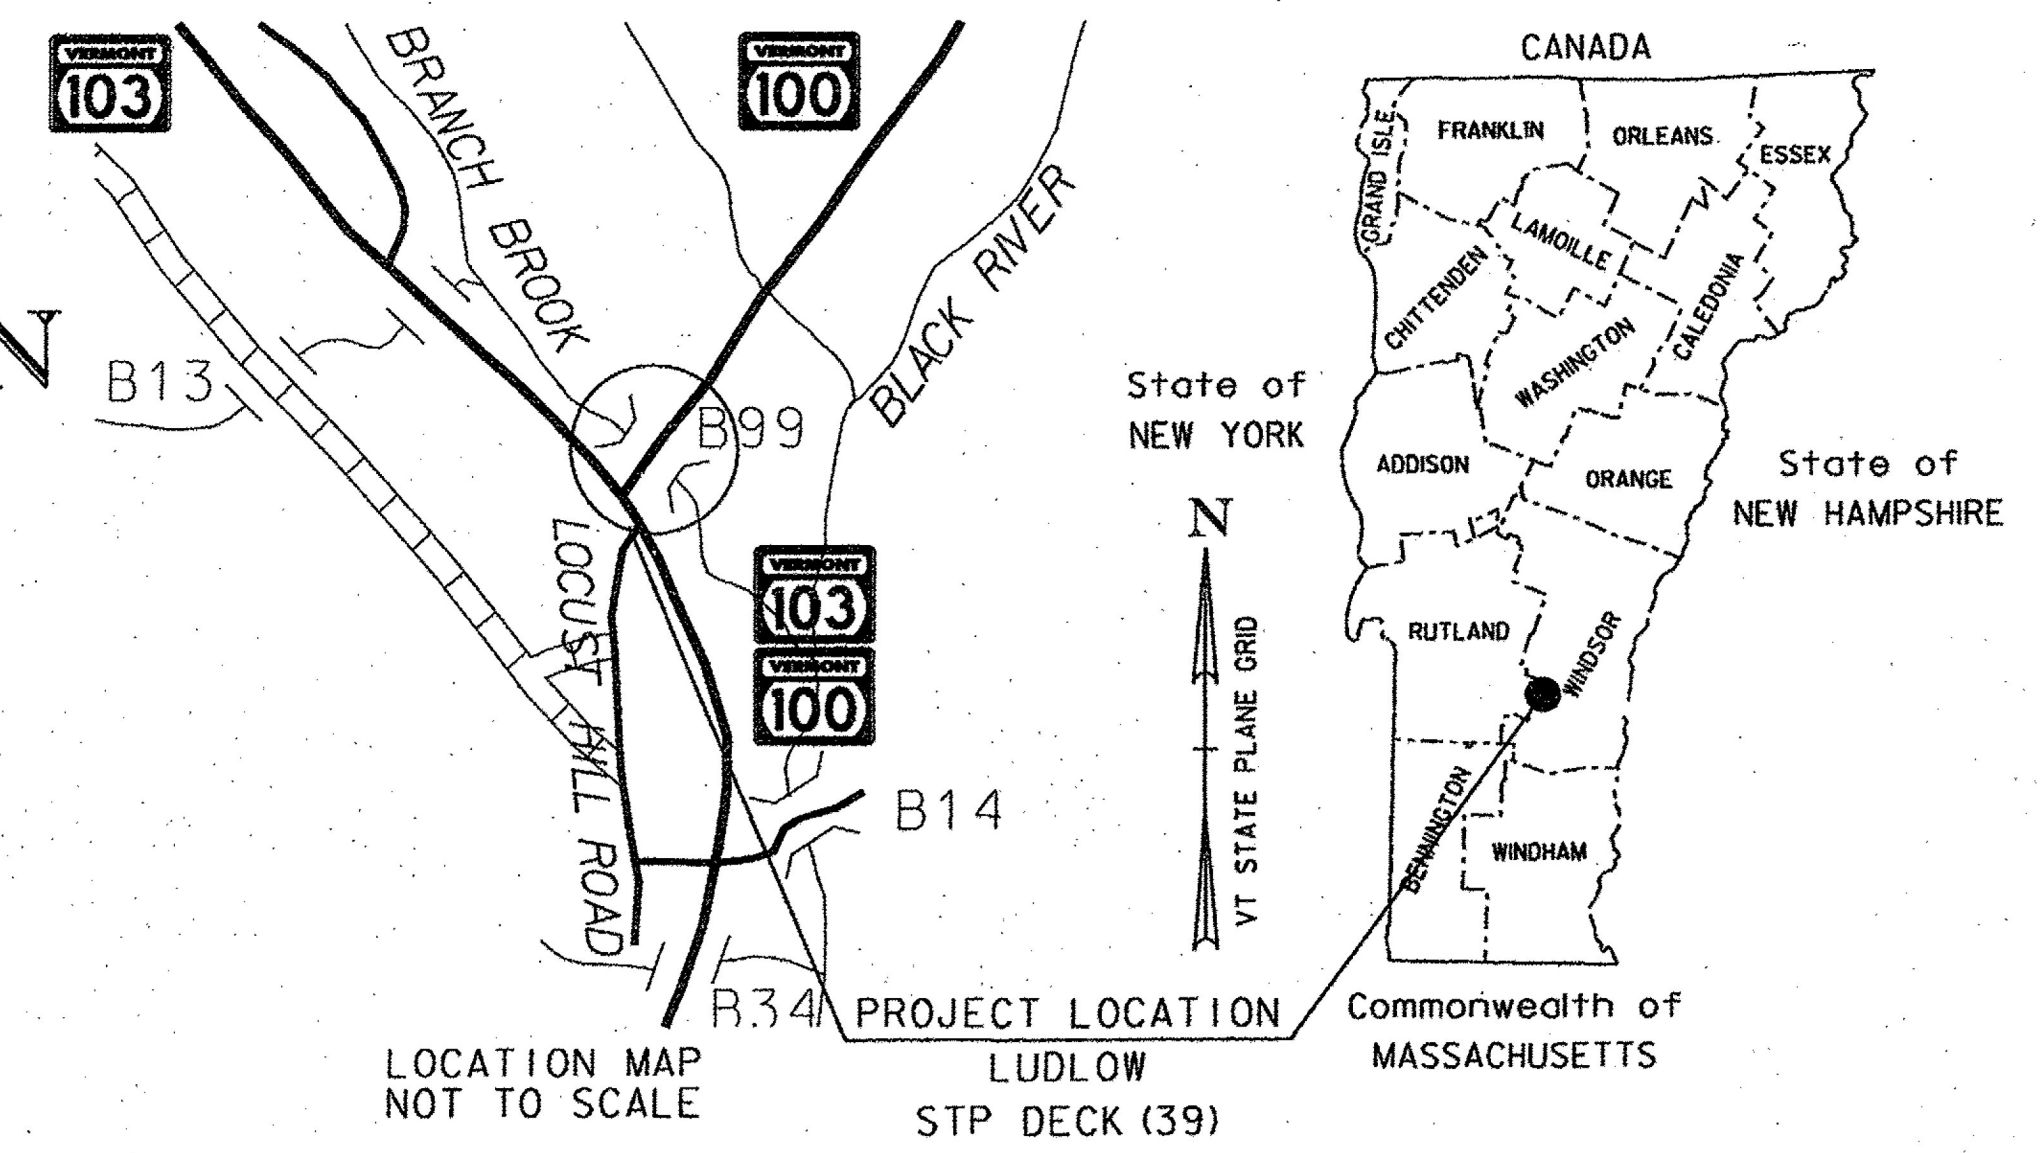

CONSTRUCTION IS TO BE CARRIED ON IN ACCORDANCE WITH THESE PLANS AND THE STANDARD SPECIFICATIONS FOR CONSTRUCTION DATED 2011, AS APPROVED BY THE FEDERAL HIGHWAY ADMINISTRATION ON JULY 20, 2011 FOR USE ON THIS PROJECT, INCLUDING ALL SUBSEQUENT REVISIONS AND SUCH REVISED SPECIFICATIONS AND SPECIAL PROVISIONS AS ARE INCORPORATED IN THESE PLANS.

QUALITY ASSURANCE PROGRAM : LEVEL 2	
SURVEYED BY :	CLD
SURVEYED DATE :	09/21/2015
DATUM	
VERTICAL	NAVD 88
HORIZONTAL	NAD 83

SCALE 1" = 20'-0"  
20 0 20

<p>HIGHWAY</p>	<p>BRIDGE</p>	<p>540 Commercial Street Manchester, NH 03101 (603) 668-8223 www.cldengineers.com</p>	DIRECTOR OF PROJECT DELIVERY
			APPROVED: <i>T.S.</i> DATE: 8/8/2016
			PROJECT MANAGER : TODD SUMNER, P.E.
			PROJECT NAME : LUDLOW
			PROJECT NUMBER : STP DECK (39)
			SHEET 1 OF 42 SHEETS

RECORD PLANS	
CONTRACTOR:	THE BELDEN COMPANY, INC. - RUTLAND, VT
RESIDENT ENGINEER:	CHRIS D. WILLIAMS
CONSTRUCTION BEGAN:	APRIL 27, 2017
CONSTRUCTION COMPLETE:	SEPTEMBER 08, 2017
RECORD PLANS BY:	CHRIS D. WILLIAMS & AARON WEAVER
I HEREBY CERTIFY THAT ALL THE CONSTRUCTION REQUIRED BY THIS SET OF DRAWINGS HAS BEEN ACCOMPLISHED AS INDICATED HEREIN.	
BY: <i>Chris Williams</i>	RESIDENT ENGINEER
DATE: Jun 18, 2018	
NOTE: Any further information concerning final quantities, amounts or other details relative to this project may be found at Central Files in the electronic archives.	