

DURABLE 4 INCH WHITE LINE  
 266+28 TO 268+61 SOLID RT  
 266+45 TO 268+61 SOLID LT  
 DURABLE 4 INCH YELLOW LINE  
 266+48 TO 268+61 SOLID LT & RT  
 DURABLE 24 INCH STOP BAR  
 266+48 TO 266+52 LT  
 DURABLE LETTER OR SYMBOL  
 266+58 LT - "STOP"  
 REMOVING SIGNS  
 266+93 RT  
 268+28 LT



STONE FILL, TYPE I  
 GEOTEXTILE UNDER STONE FILL  
 268+30 TO 268+40 RT  
 268+54 TO 268+58 LT  
 STONE FILL, TYPE II  
 GEOTEXTILE UNDER STONE FILL  
 266+88 TO 267+17 LT  
 268+01 TO 268+25 LT

REMOVAL AND DISPOSAL OF GUARDRAIL  
 266+21 TO 266+98 RT  
 266+53 TO 266+98 LT  
 268+17 TO 268+38 RT  
 268+17 TO ~~268+62~~ 269+31 LT  
 STEEL BEAM GUARDRAIL, GALVANIZED  
 266+22 TO 266+72 RT  
 266+53 TO 266+66 LT  
 268+37 TO 268+40 RT  
 268+43 TO ~~268+55~~ 269+43 LT

ANCHOR FOR STEEL BEAM RAIL  
 268+36 RT 269+30 LT  
 DELINEATOR WITH STEEL POST  
 268+37 RT 269+43 LT  
 CAST-IN-PLACE CONCRETE CURB, TYPE B  
 266+62 TO 267+00 RT  
 266+62 TO 267+00 LT  
 268+15 TO 268+39 RT  
 268+15 TO 268+53 LT  
 CONSTRUCT DRIVES ~~PAVED~~  
 268+49 RT (27 FT WIDE, GRAVEL, RES.)

HVCTRL 266+62.8	
NORTH =	335389.02
EAST =	1585420.95
ELEV. =	<del>1034.00</del> 1034.14


HVCTRL 268+34.7	
NORTH =	335482.64
EAST =	1585575.30
ELEV. =	1030.82

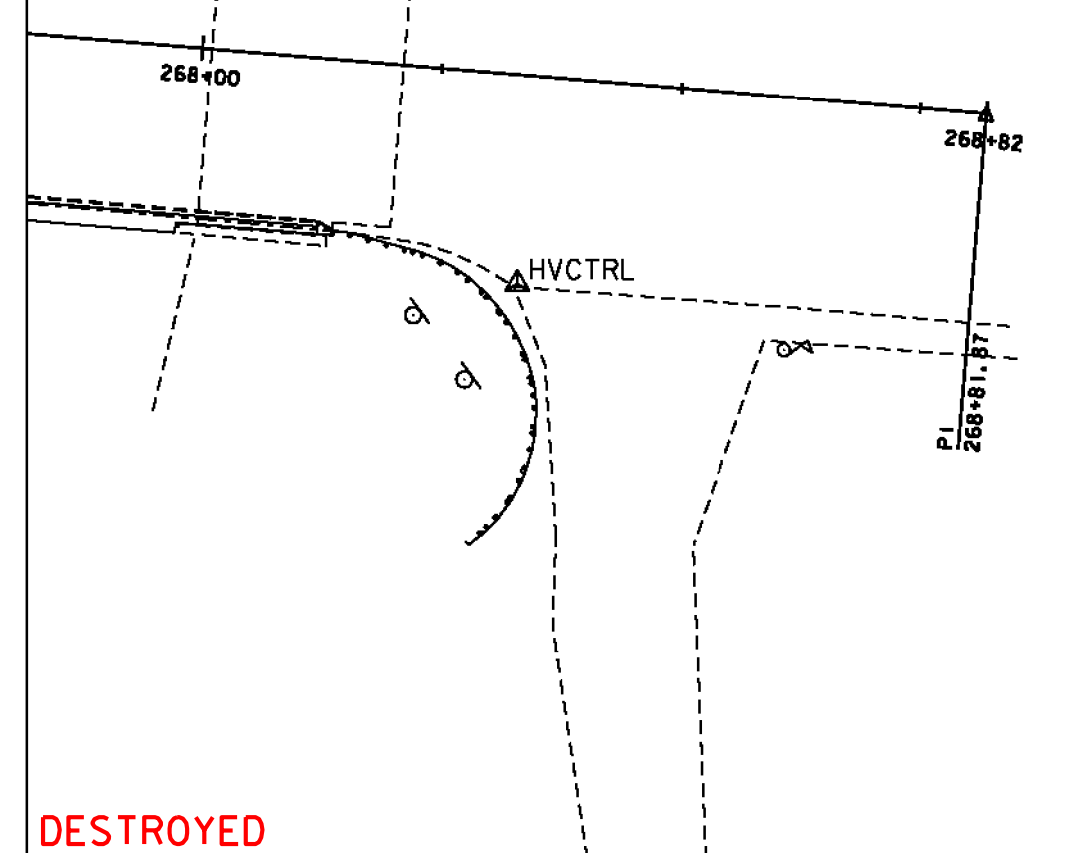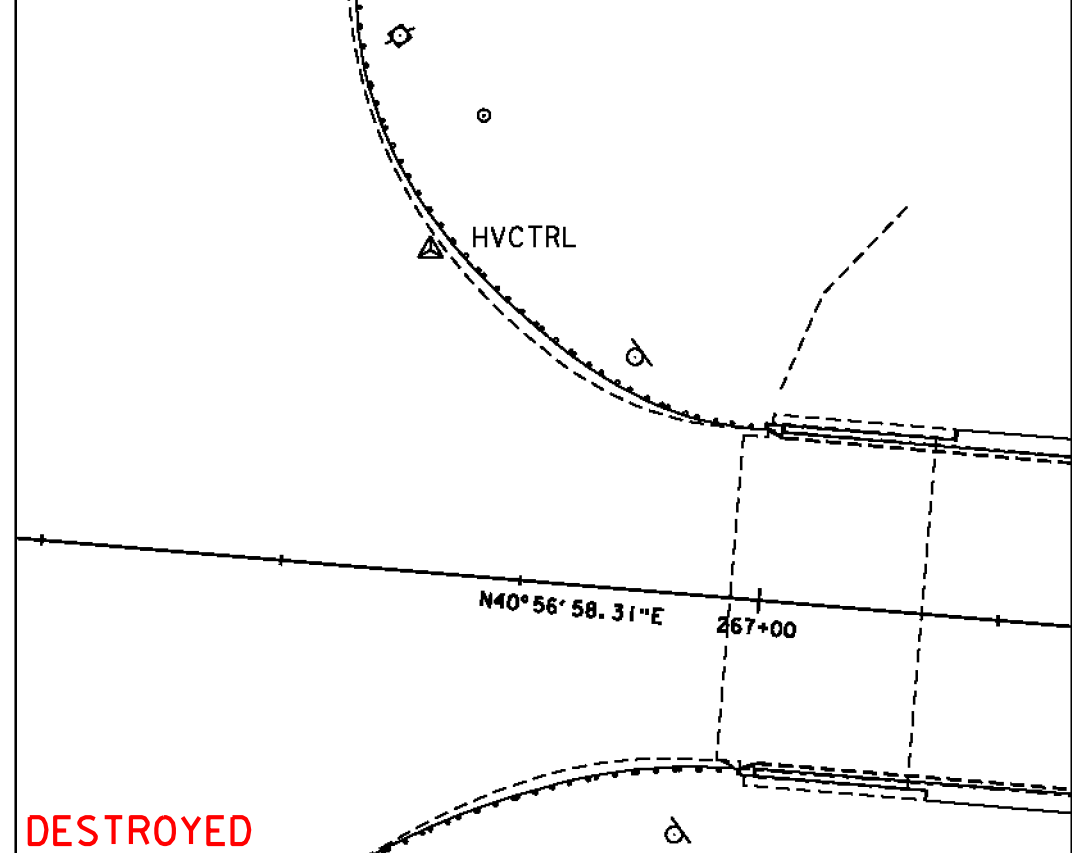

EXISTING BRIDGE DATA:  
 ROLLED BEAMS, CONCRETE DECK  
 SPAN = 82'-0"  
 WIDTH = 38'-10" OUT-TO-OUT  
 BUILT IN 1966.

- LEGEND
- [N] NEW SIGN
  - [RET] RETAIN SIGN
  - [S] SALVAGE SIGN
  - [R] REMOVE SIGN

KEY TO PAVEMENT MARKINGS  
 WL = SOLID WHITE LINE  
 YL = SOLID YELLOW LINE

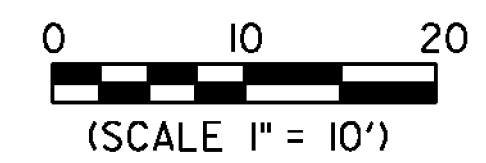

PROJECT NAME: LUDLOW  
 PROJECT NUMBER: STP DECK(39)  
 FILE NAME: z15b109bdr-99.dgn  
 PROJECT LEADER: J. BYATT  
 DESIGNED BY: S. FORTIER  
 LAYOUT SHEET  
 PLOT DATE: 8/3/2016  
 DRAWN BY: S. FORTIER  
 CHECKED BY: L. GREER  
 SHEET II OF 42

CLD 15-0223 MODEL: Layout1