


New Curtain Wall, Abut 1

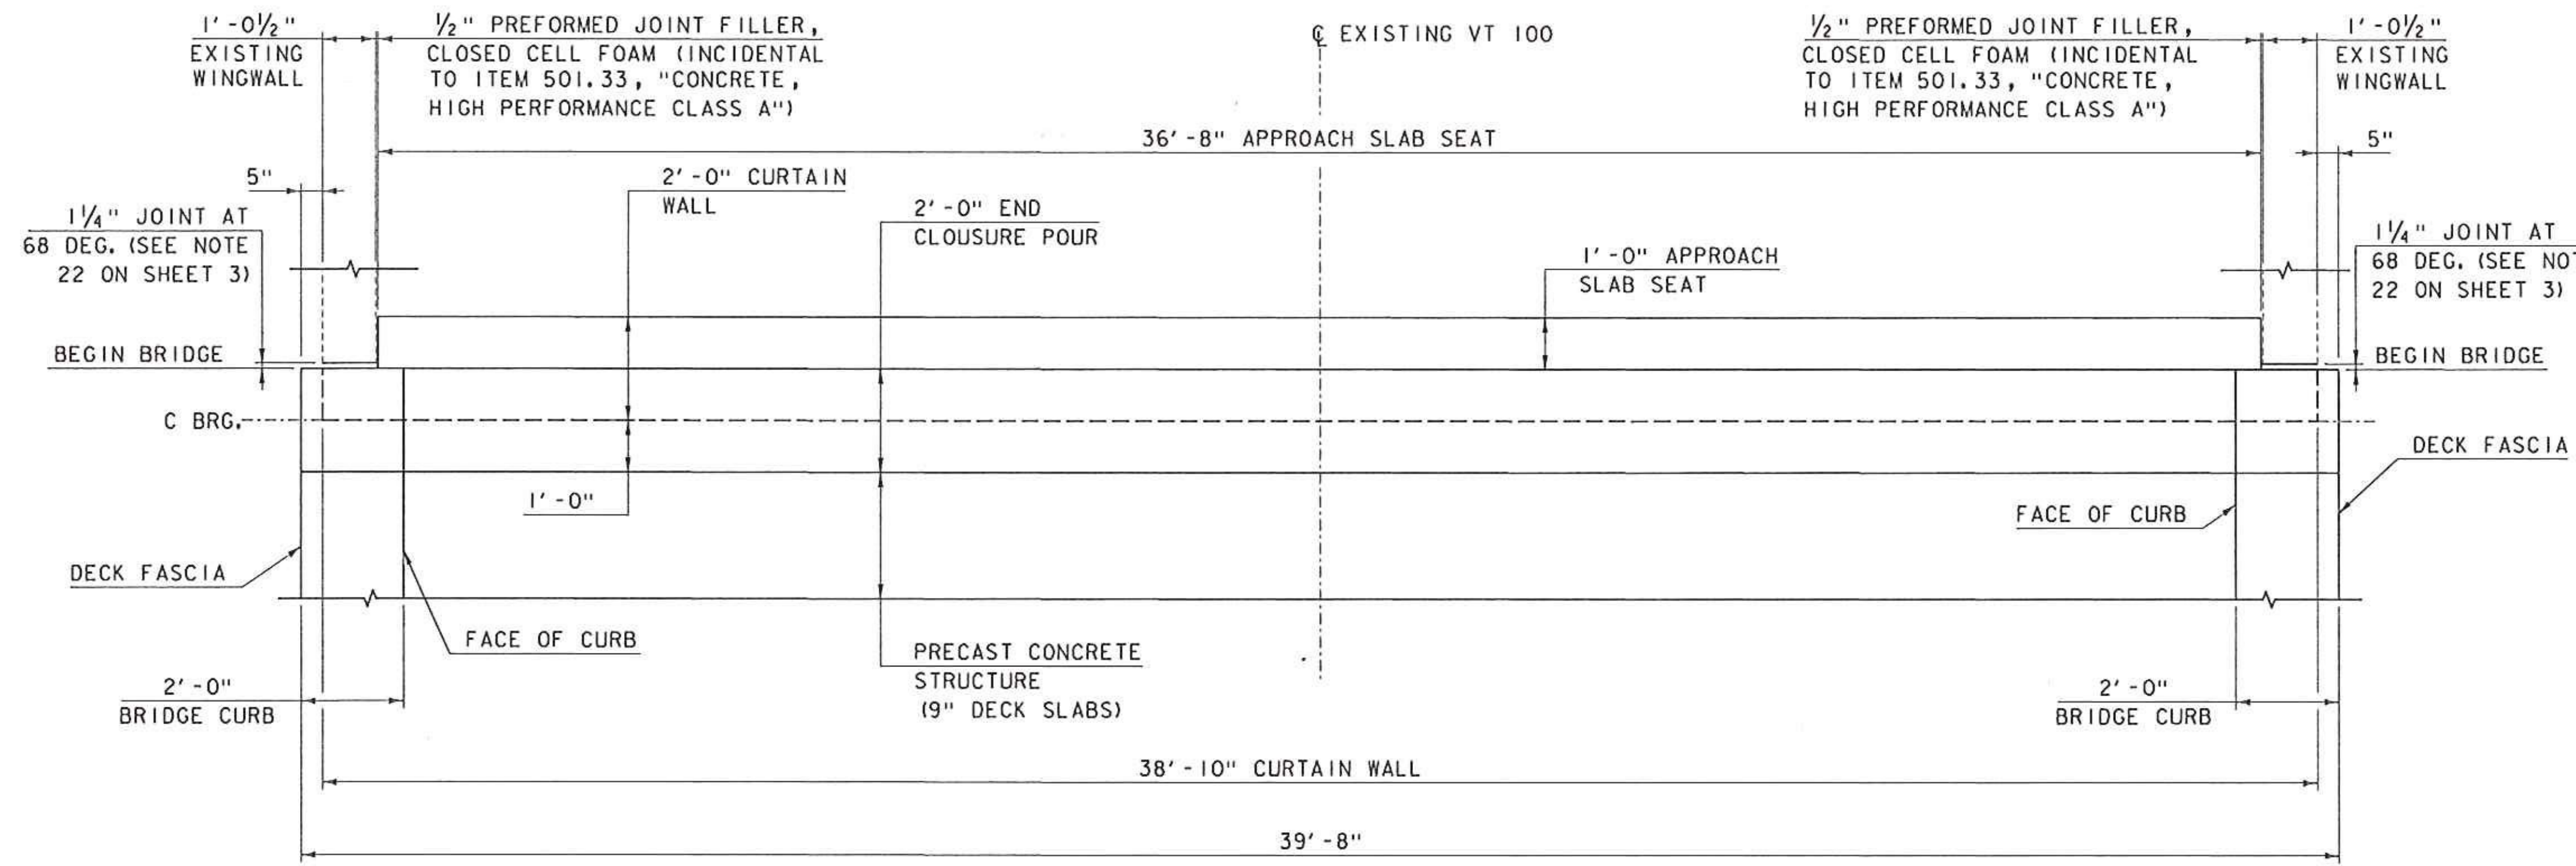


CURTAIN WALL MASONRY PLAN

SCALE: 1/2" = 1'-0"

NOTES:

1. 3" CLEAR, UNLESS OTHERWISE SPECIFIED ON THE PLANS.
2. 2'-2" SPLICE UNLESS OTHERWISE SPECIFIED ON THE PLANS.
3. 10" HOOK UNLESS OTHERWISE SPECIFIED ON THE PLANS.
4. FF= FAR FACE
NF= NEAR FACE

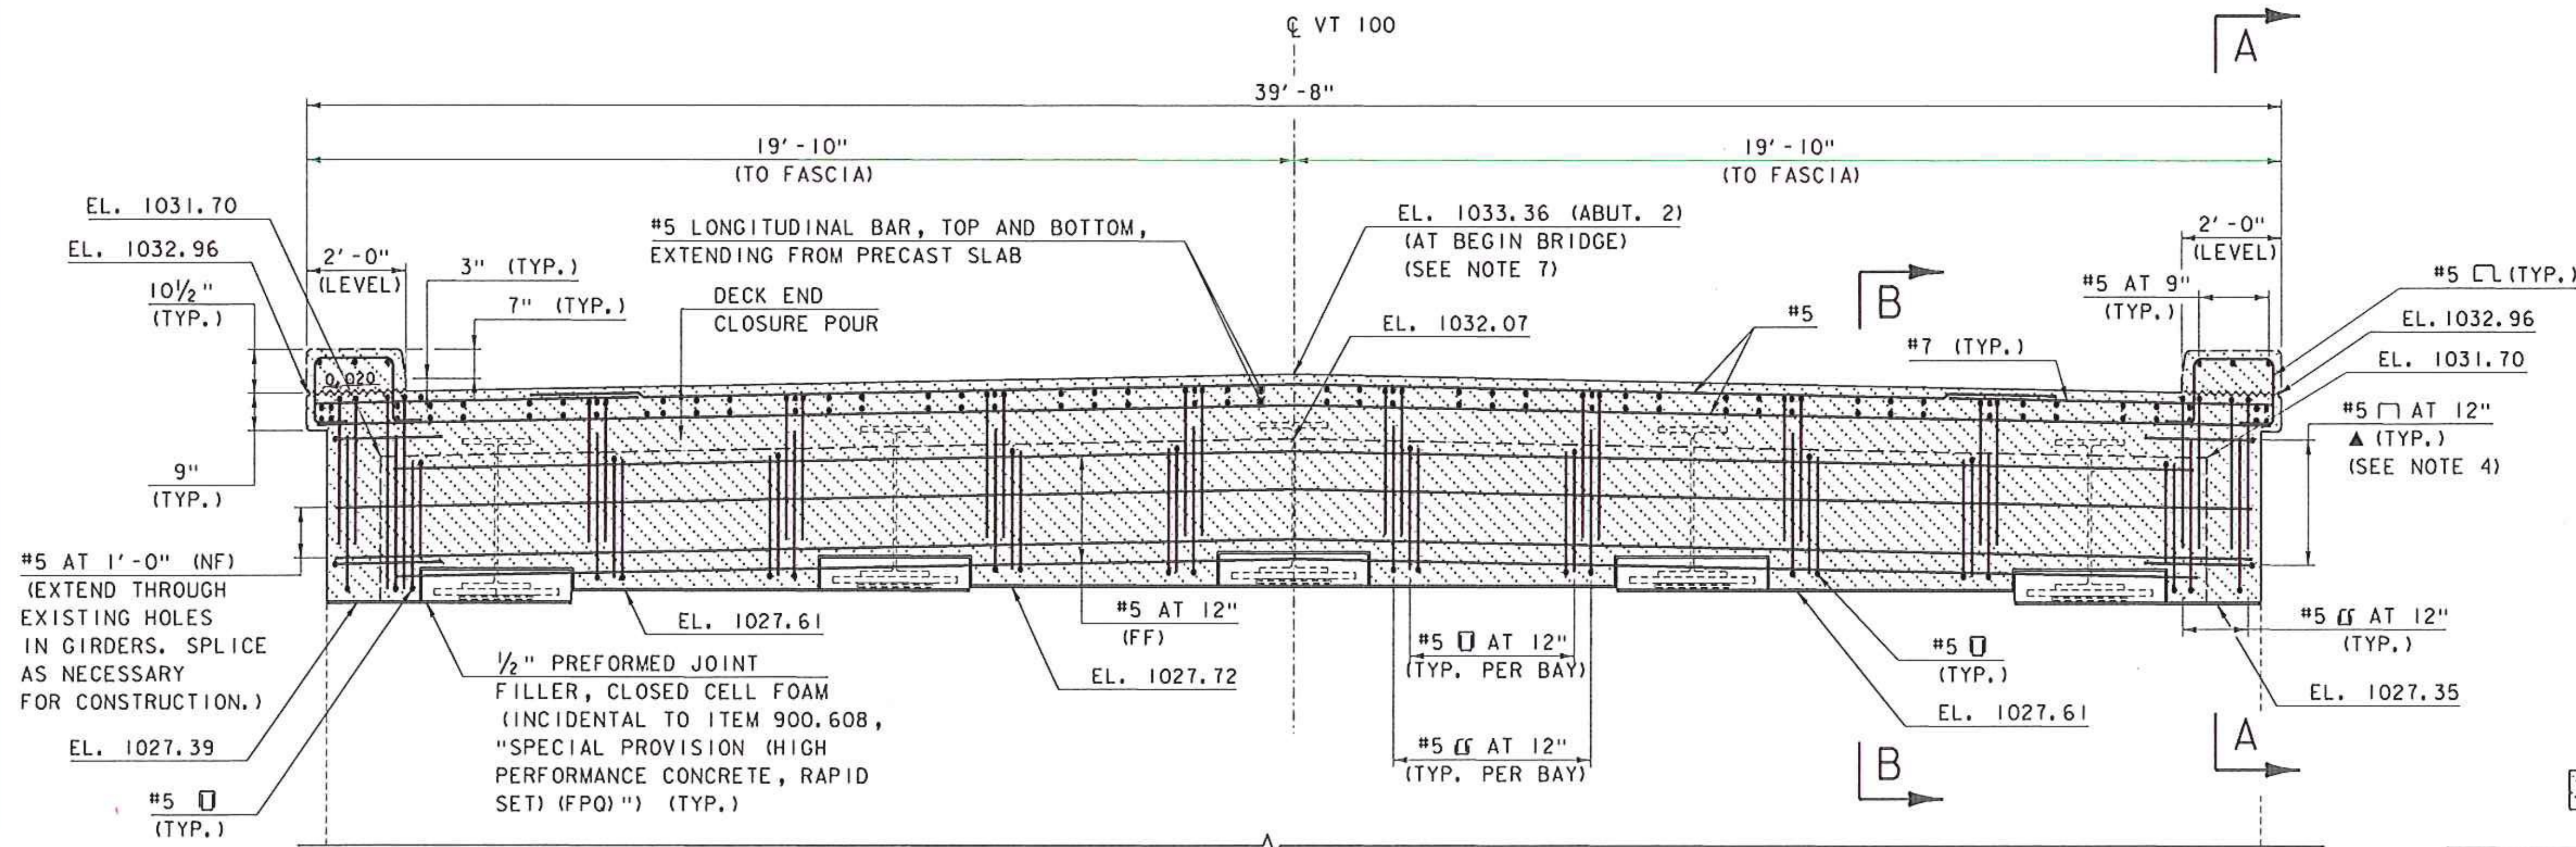

END CLOSURE POUR AND CURTAIN WALL MASONRY AND REINFORCING ELEVATION

SCALE: 1/2" = 1'-0"

SPECIAL PROVISION (HIGH PERFORMANCE CONCRETE, RAPID SET) (FPO)

PROJECT NAME: LUDLOW
PROJECT NUMBER: STP DECK(39)

FILE NAME: z15bi09+yp-99.dgn
PROJECT LEADER: J. BYATT
DESIGNED BY: S. BEAMONT
CURTAIN WALL DETAILS SHEET I

PLOT DATE: 5/17/2017
DRAWN BY: M. SMITH
CHECKED BY: A. GIRALDI
SHEET 254 OF 1



CLD 15-0223 MODEL: Default