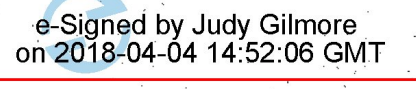


Record Plans

Contractor: Cold River Bridges
 Resident Engineer: Judy Gilmore
 Construction Began: May 3, 2017
 Construction Complete: September 12, 2017
 Record Plans By: Judy Gilmore

I hereby certify that all construction required by this set of drawings has been accomplished as indicated herein.

BY:  e-Signed by Judy Gilmore on 2018-04-04 14:52:06 GMT Resident Engineer


Date: April 04, 2018

NOTE: Any further information concerning final quantities, amounts or other details relative to this project may be found at Central Files in the electronic archives.

STATE OF VERMONT AGENCY OF TRANSPORTATION



PROPOSED IMPROVEMENT BRIDGE PROJECT TOWN OF ORWELL COUNTY OF ADDISON

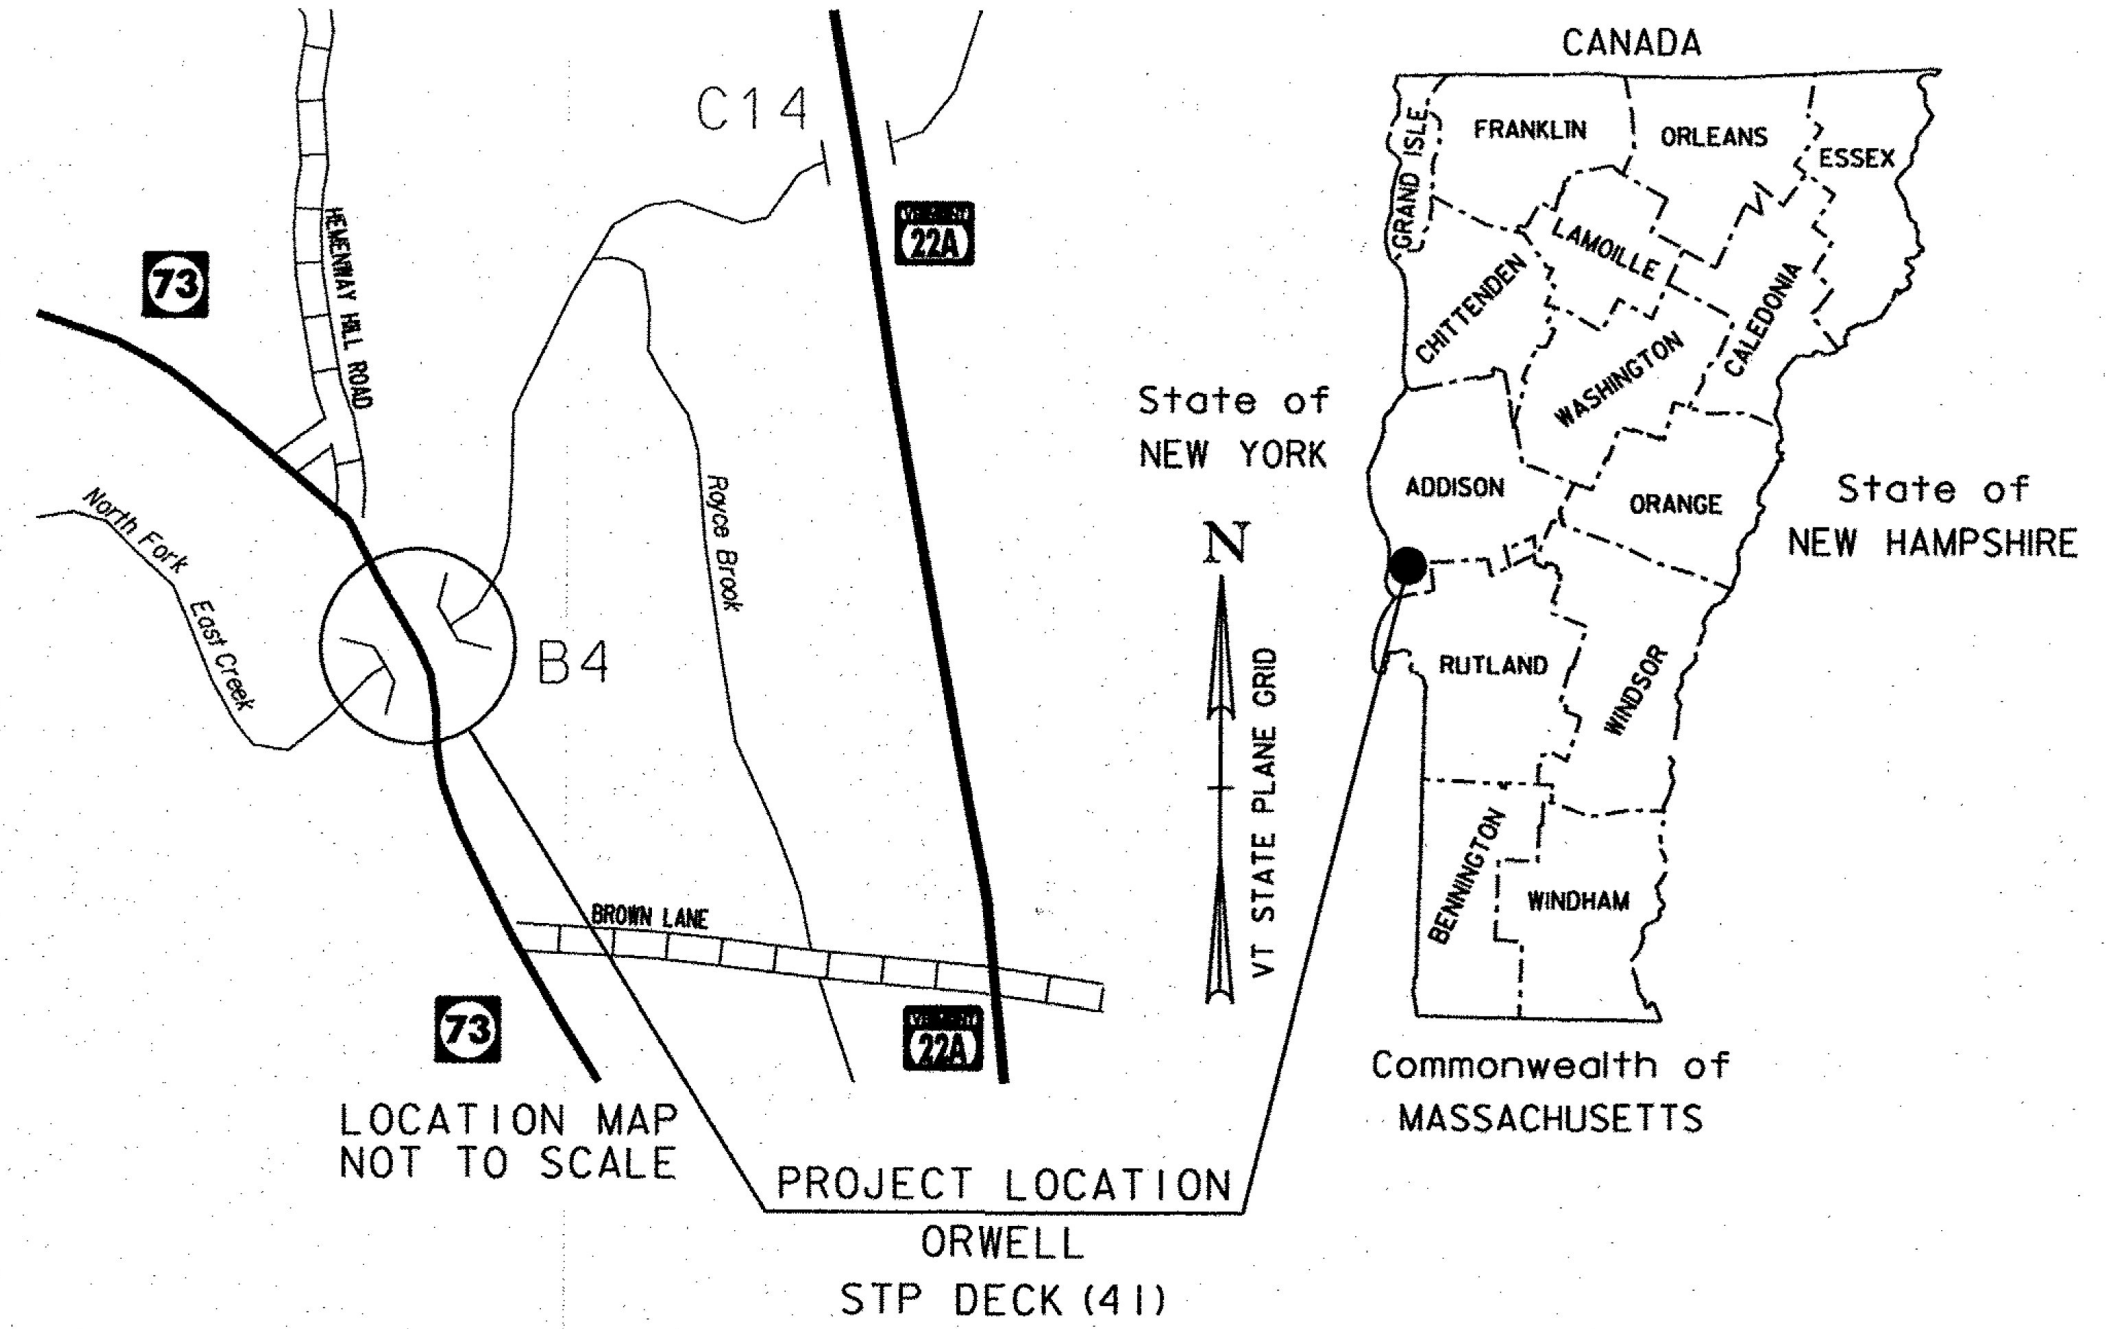


STATE NUMBERED ROUTE 73 (TH #3) (MAJOR COLLECTOR) BRIDGE NO. 4

PROJECT LOCATION: LOCATED IN THE TOWN OF ORWELL, ON SNR 73 (TH #3), APPROXIMATELY 2.940 MILES EASTERLY OF THE SHOREHAM/ORWELL TOWN LINE.

PROJECT DESCRIPTION: WORK TO BE PERFORMED UNDER THIS PROJECT INCLUDES THE REPLACEMENT OF THE EXISTING BRIDGE DECK INCLUDING RELATED APPROACH WORK.

LENGTH OF STRUCTURE: 74.00 FEET
LENGTH OF ROADWAY: 196.00 FEET
LENGTH OF PROJECT: 270.00 FEET

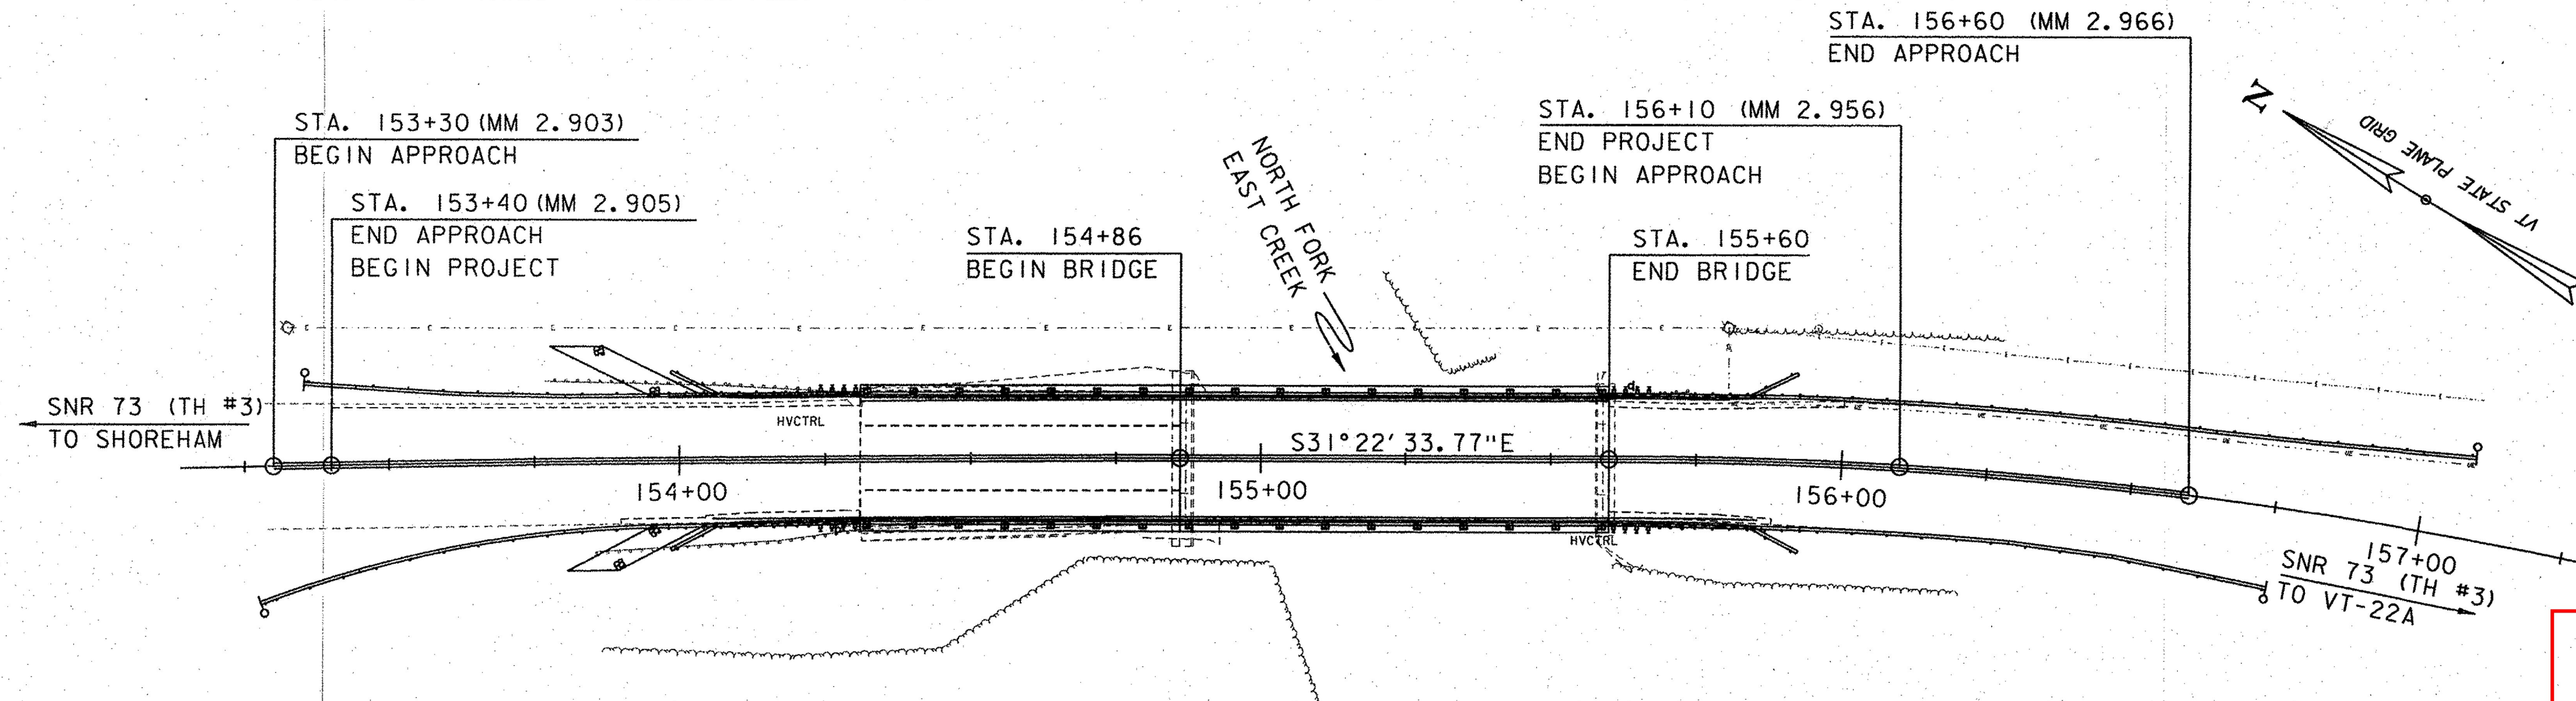

CONSTRUCTION IS TO BE CARRIED ON IN ACCORDANCE WITH THESE PLANS AND THE STANDARD SPECIFICATIONS FOR CONSTRUCTION DATED 2011, AS APPROVED BY THE FEDERAL HIGHWAY ADMINISTRATION ON JULY 20, 2011 FOR USE ON THIS PROJECT, INCLUDING ALL SUBSEQUENT REVISIONS AND SUCH REVISED SPECIFICATIONS AND SPECIAL PROVISIONS AS ARE INCORPORATED IN THESE PLANS.

Record Plans

QUALITY ASSURANCE PROGRAM : LEVEL 2
SURVEYED BY : CLD
SURVEYED DATE : 09/21/2015
DATUM
VERTICAL NAVD 88
HORIZONTAL NAD 83

SCALE 1" = 20'-0"
 20 0 20

 HIGHWAY	 BRIDGE	 540 Commercial Street Manchester, NH 03101 (603) 668-8223 www.cldengineers.com	DIRECTOR OF PROJECT DELIVERY
			APPROVED  DATE 8/30/2016
PROJECT MANAGER : JENNIFER FITCH, P.E.			PROJECT NAME : ORWELL
			PROJECT NUMBER : STP DECK (41)
			SHEET 1 OF 27 SHEETS