


CLD 15-0223 MODEL: PROFILE

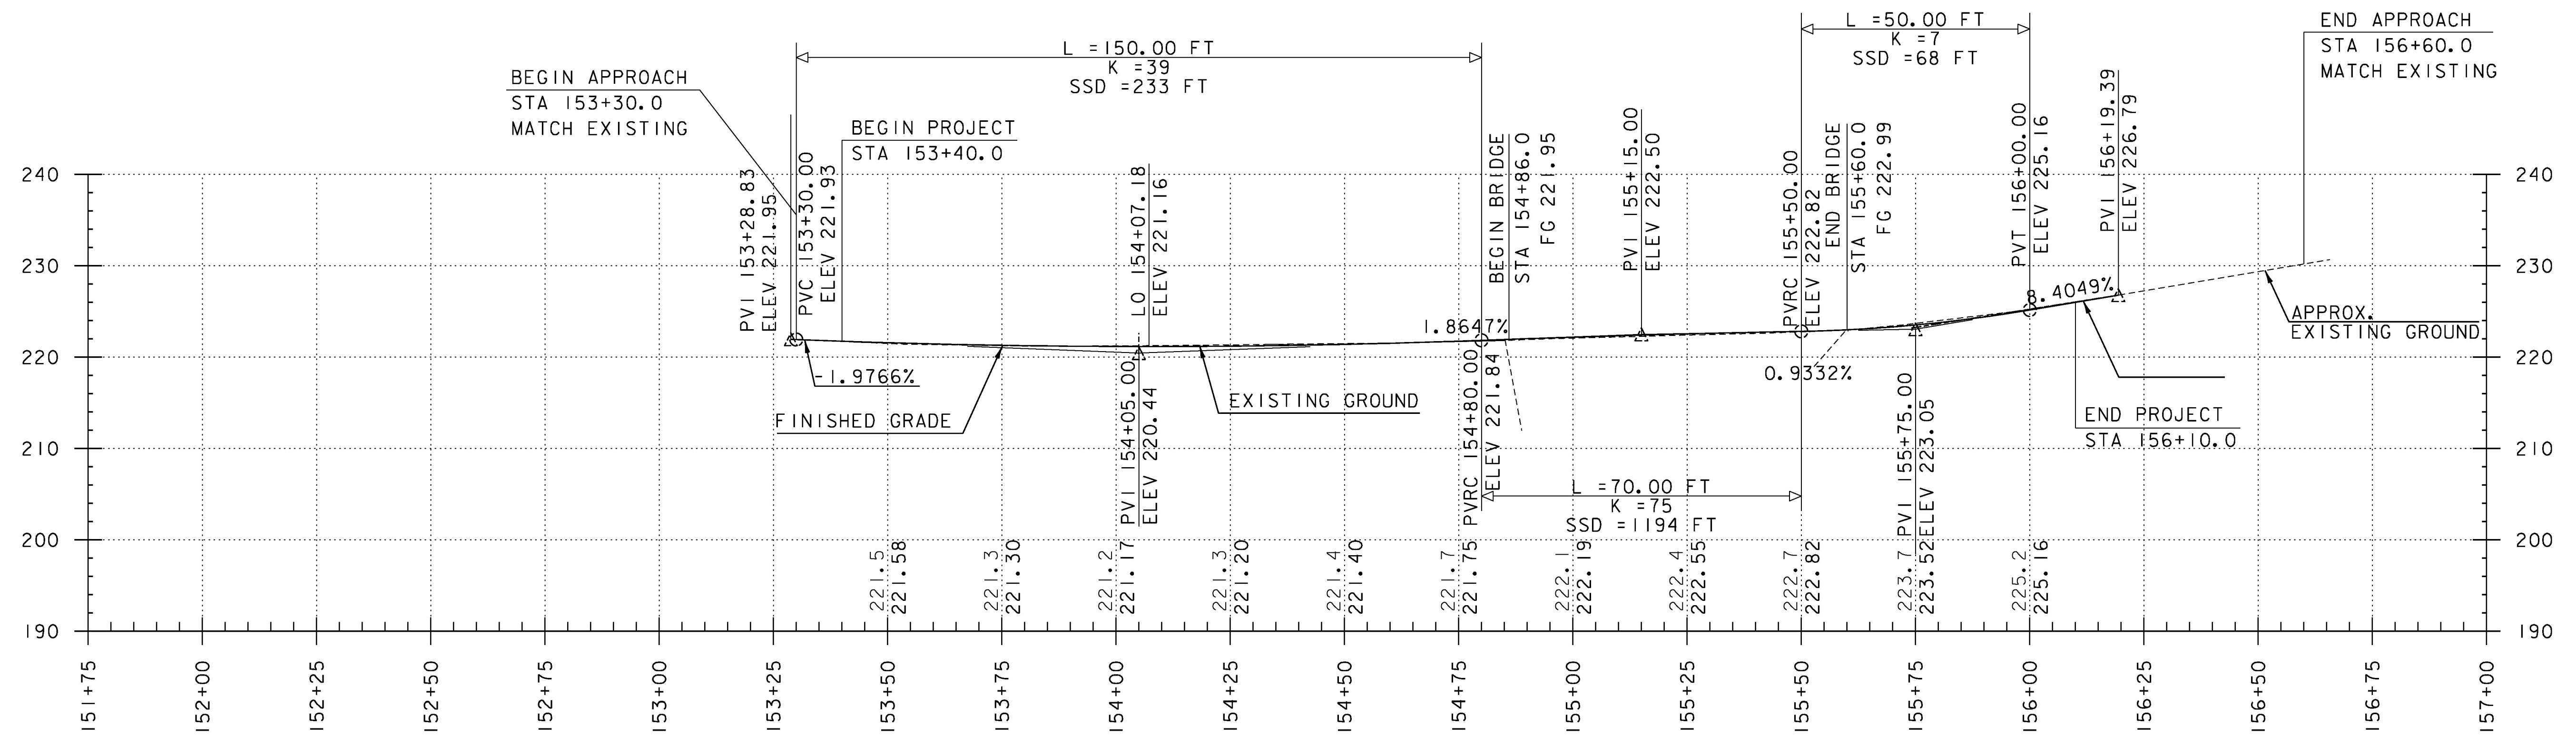

SNR ROUTE 73 REVISED PROFILE-2

NOTES

1. STATIONS AND ELEVATIONS ARE IN FEET.
2. THE ELEVATIONS SHOWN TO THE NEAREST TENTH ARE THE EXISTING GROUND ALONG THE CENTERLINE.
3. THE ELEVATIONS SHOWN TO THE NEAREST HUNDRETH ARE THE FINISHED GRADE ALONG THE CENTERLINE.
4. PROPOSED PROFILE SHOWN IS FOR INFORMATIONAL PURPOSES ONLY. FINAL FINISHED GRADE SHALL BE DETERMINED BY THE PROJECT MANAGER AFTER TOP OF BEAM ELEVATIONS ARE SURVEYED. SEE PROJECT NOTE 23 ON SHEET 3.

HOR. SCALE 1" = 20' -0"
 VER. SCALE 1" = 10' -0"

Updated
26 July 2017

PROJECT NAME: ORWELL	
PROJECT NUMBER: STP DECK (4I)	
FILE NAME: z15j108pro-4.dgn	PLOT DATE: 7/26/2017
PROJECT LEADER: J. BYATT	DRAWN BY: S. FORTIER
DESIGNED BY: S. FORTIER	CHECKED BY: L. GREER
REVISED PROFILE SHEET	SHEET II OF 27

