


DECK REINFORCEMENT PLAN

SCALE: 1/4" = 1'-0"

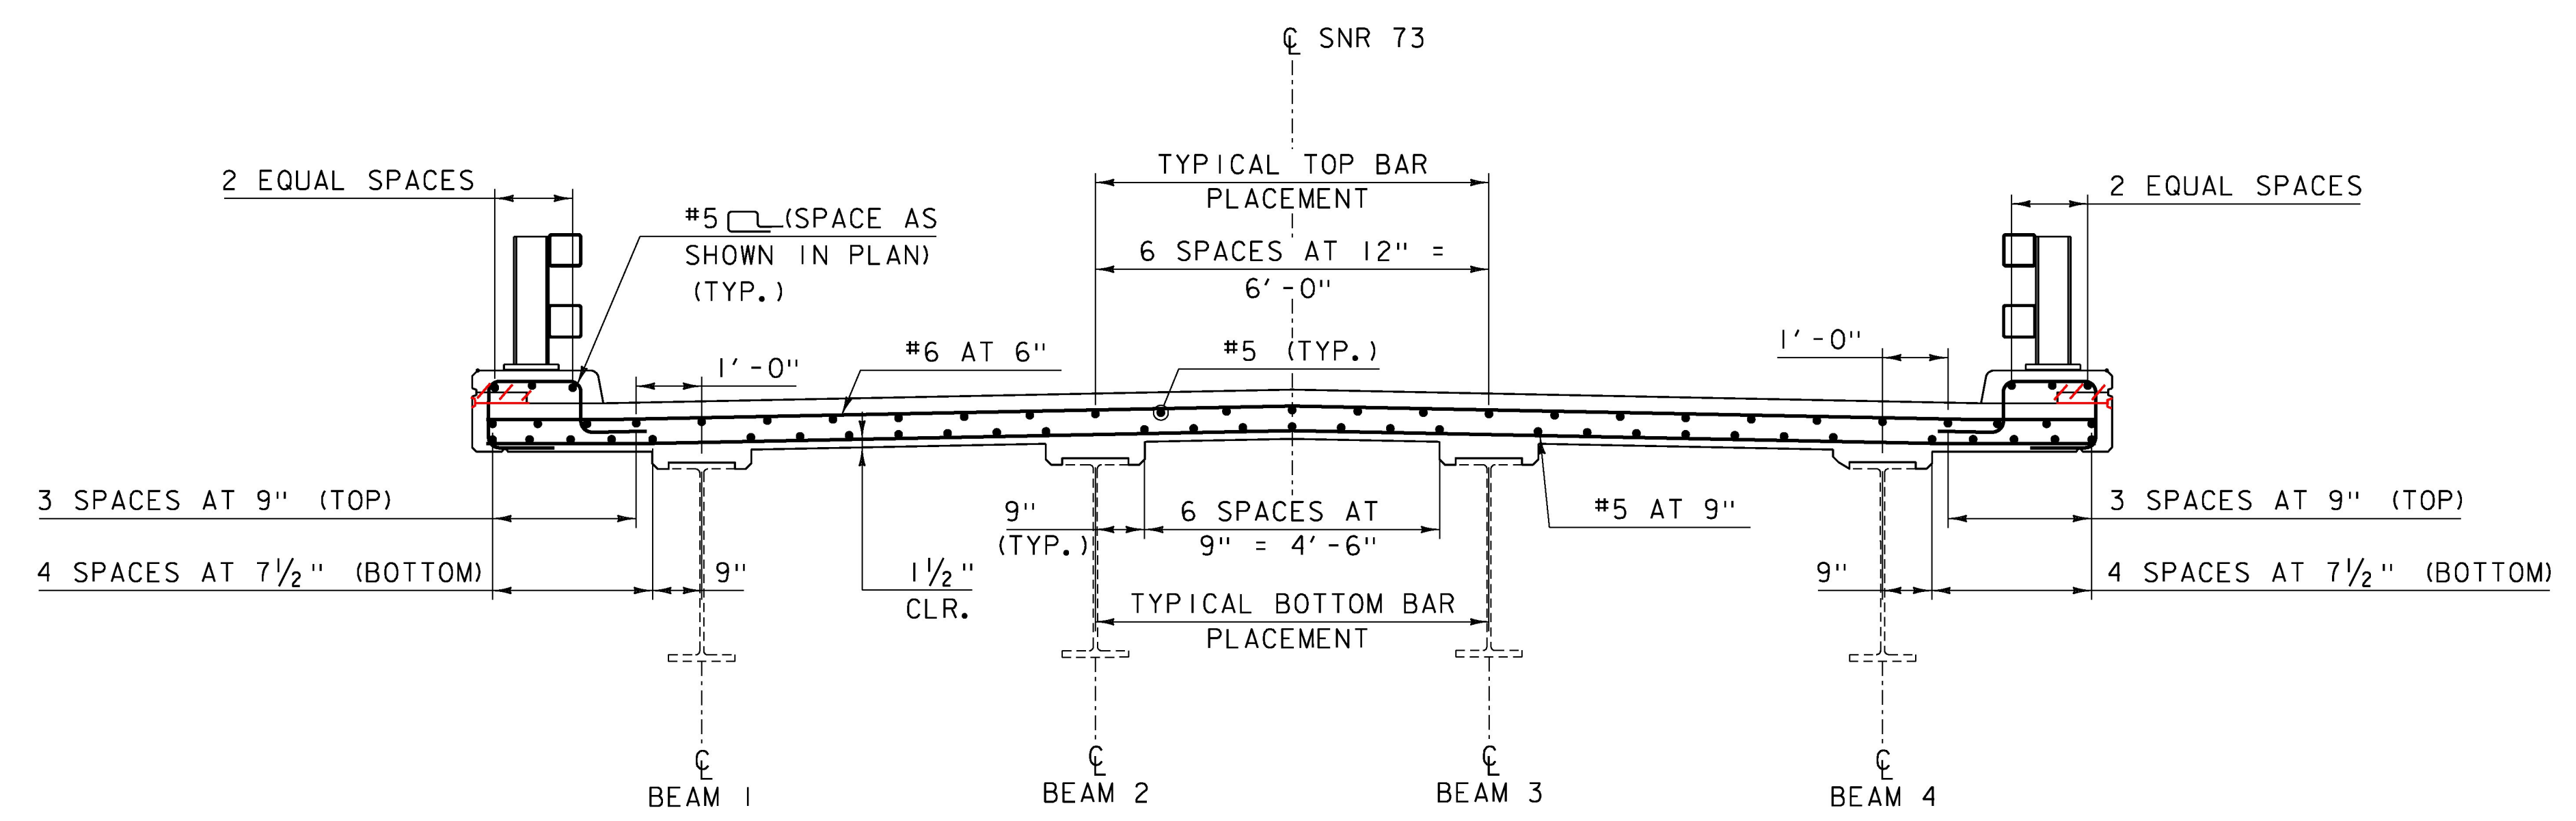


SECTION A-A

SCALE: 1/2" = 1'-0"

NOTES:

1. 3" CLEAR, UNLESS OTHERWISE SPECIFIED ON THE PLANS.
2. 3'-0" BAR LAP UNLESS OTHERWISE SPECIFIED ON THE PLANS.
3. 1'-0" HOOK UNLESS OTHERWISE SPECIFIED ON THE PLANS.
4. SEE SHEET 20 FOR RAIL LAYOUT SHEET.

PROJECT NAME:	ORWELL	PLOT DATE:	8/22/2016
PROJECT NUMBER:	STP DECK(4I)	DRAWN BY:	M. SMITH
FILE NAME:	z15j108+yp-4.dgn	DESIGNED BY:	S. BEAUMONT
PROJECT LEADER:	J. BYATT	CHECKED BY:	J. FRENCH
DECK DETAILS SHEET		SHEET	14 OF 27

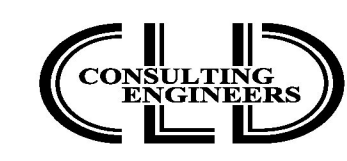

CLD 15-0223 MODEL: TYPO5