



**NOTES:**

1. 3" CLEAR, UNLESS OTHERWISE SPECIFIED ON THE PLANS.
2. 3'-0" BAR LAP UNLESS OTHERWISE SPECIFIED ON THE PLANS.
3. EF = EACH FACE
4. SEE SHEET 15 FOR CURTAIN WALL MASONRY AND REINFORCEMENT ELEVATION.

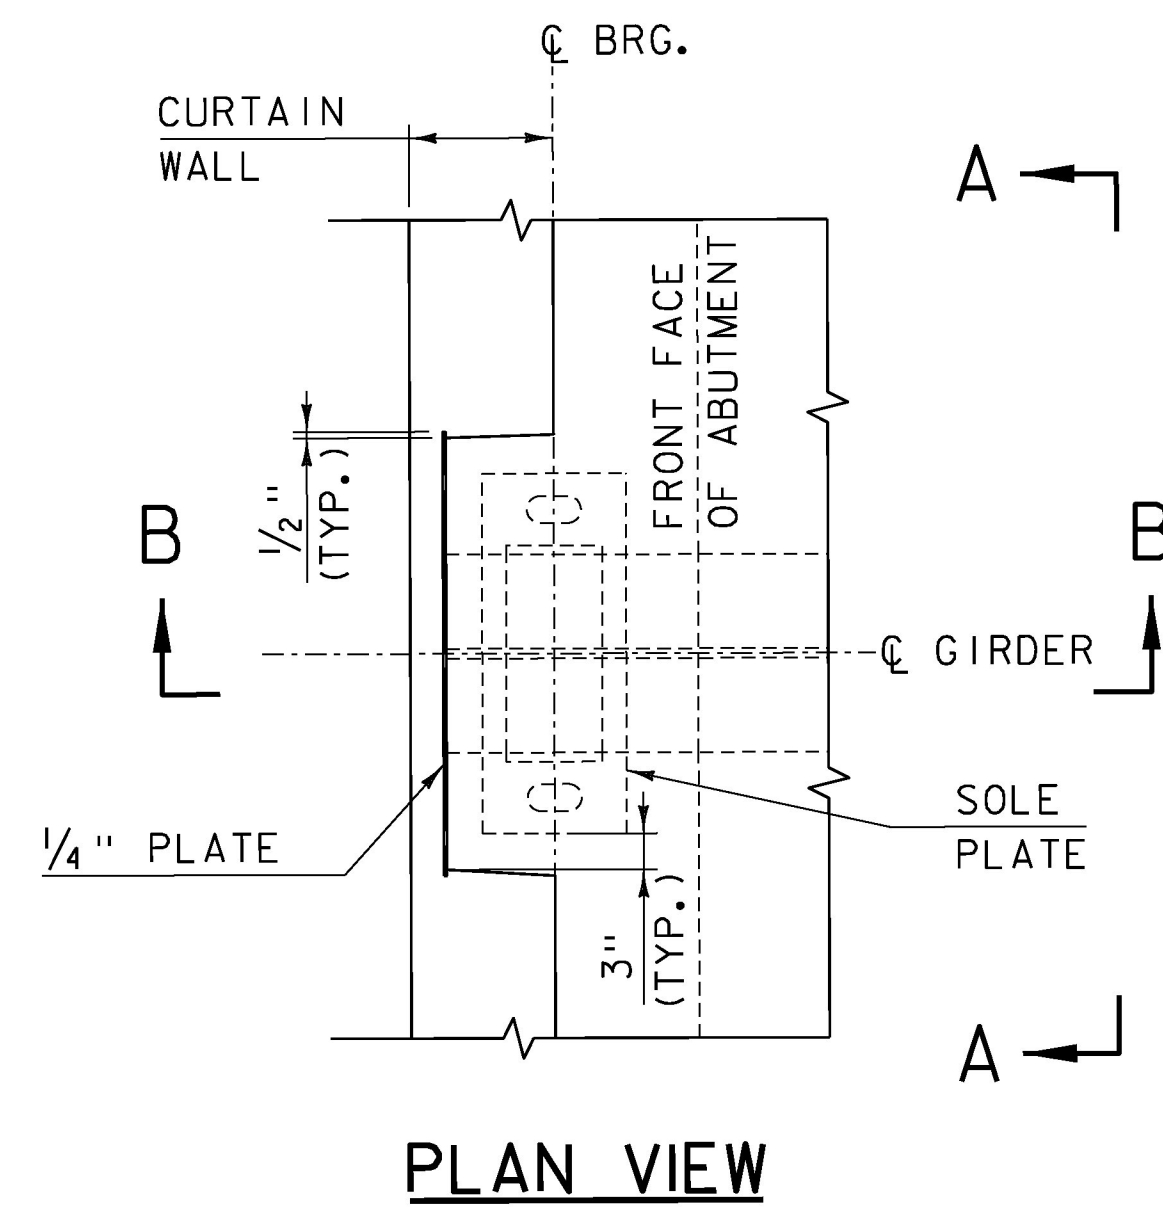

**CONCRETE CURTAIN WALL  
BLOCKOUTS AROUND BEARINGS**  
SCALE: 3/4" = 1'-0"

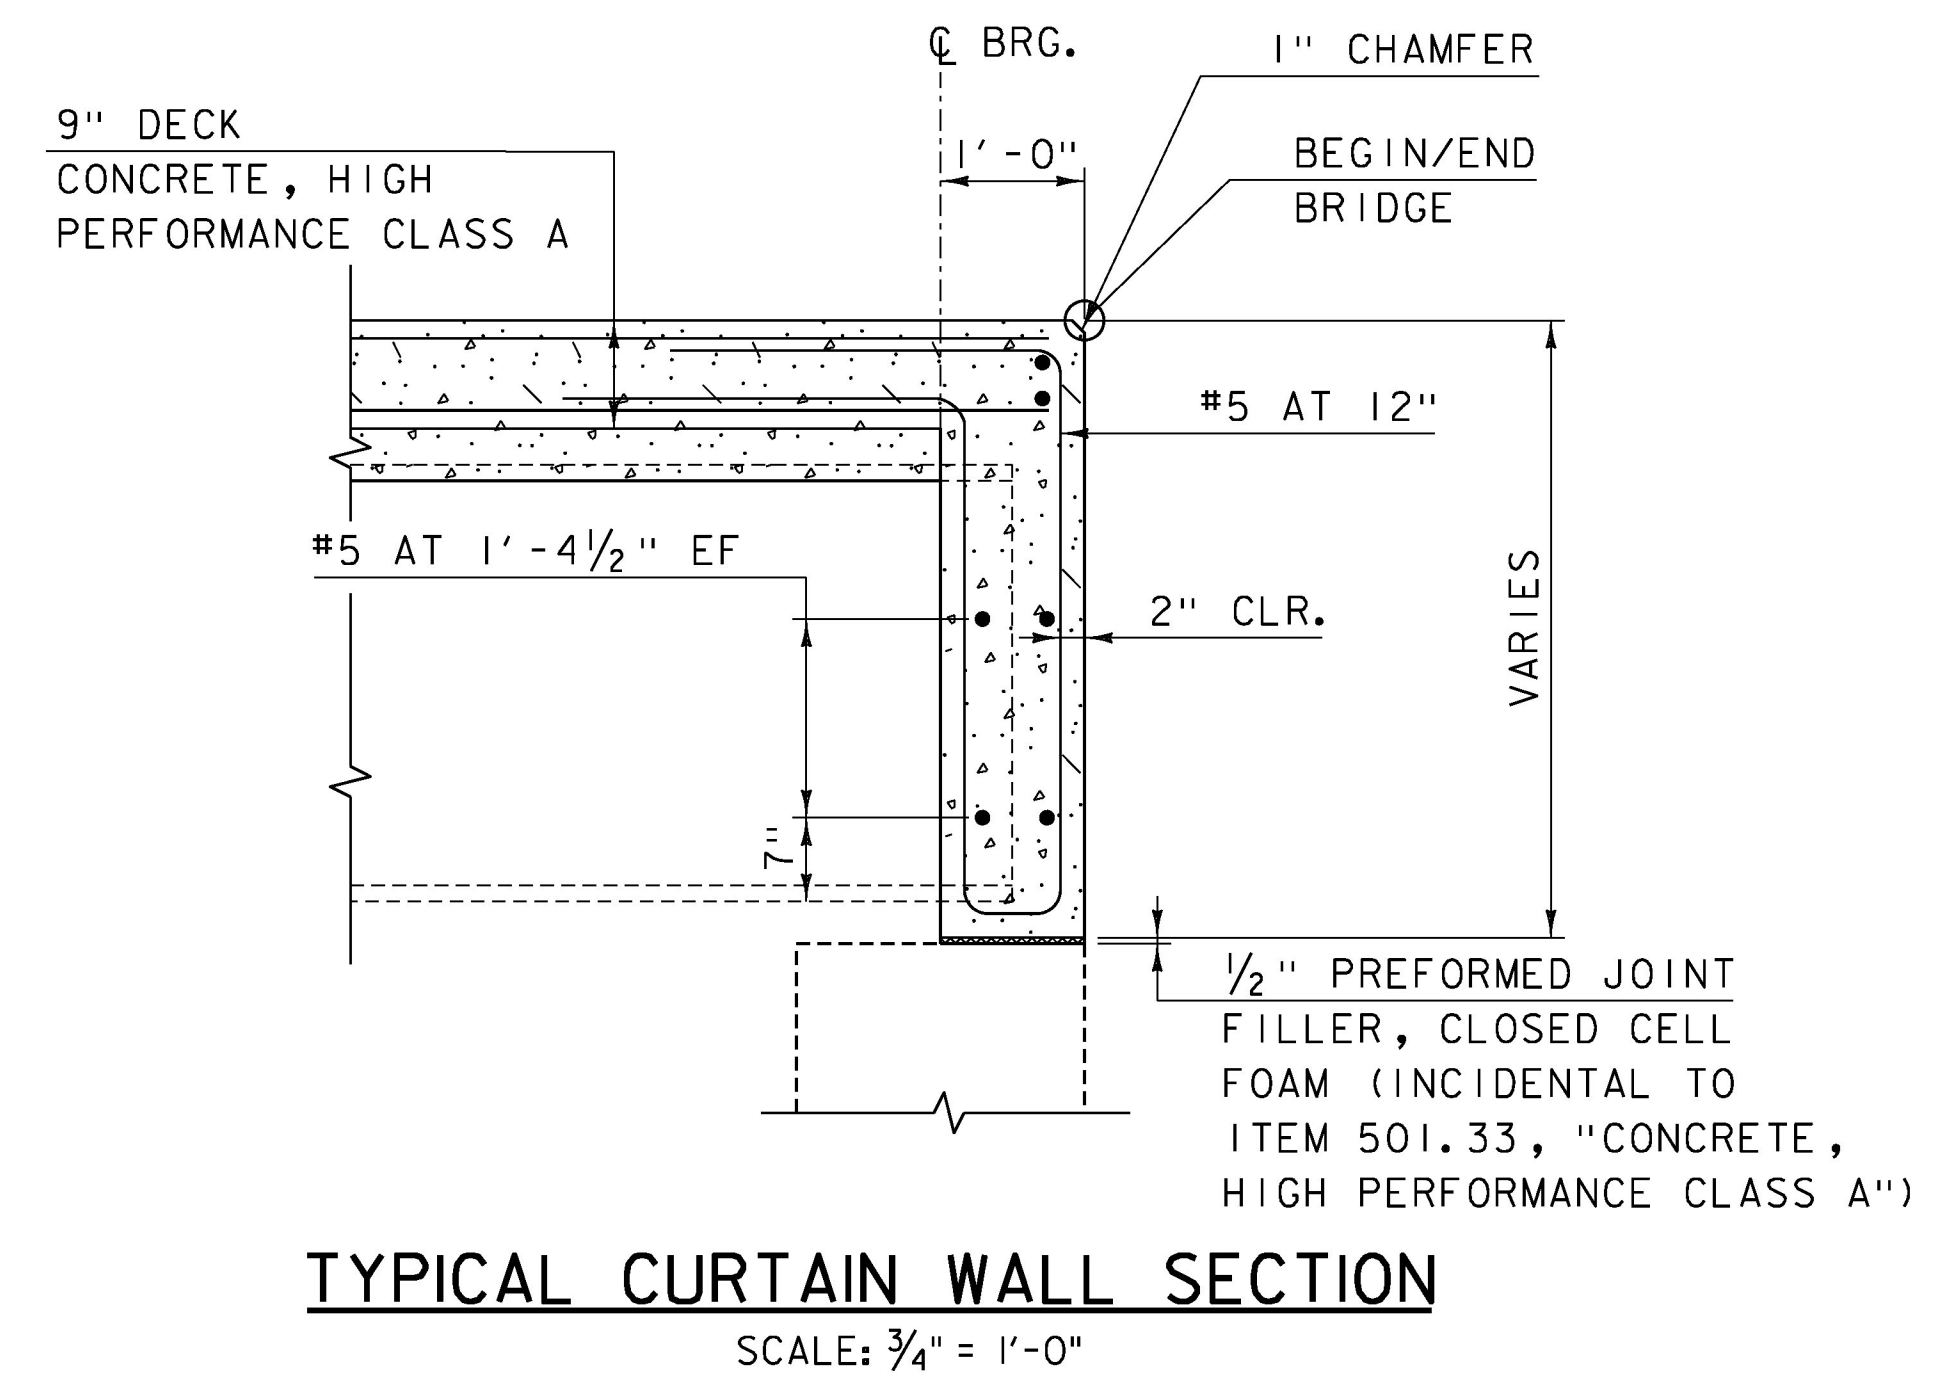

CLD 15-0223 MODEL: TYP07

PROJECT NAME: ORWELL	PLOT DATE: 8/22/2016
PROJECT NUMBER: STP DECK(41)	DRAWN BY: M. SMITH
FILE NAME: z15j108typ-4.dgn	CHECKED BY: S. BEAUMONT
DESIGNED BY: N. CARON	REMOVAL & CURTAIN WALL DETAILS SHEET 2
	SHEET 16 OF 27