


Orwell 46

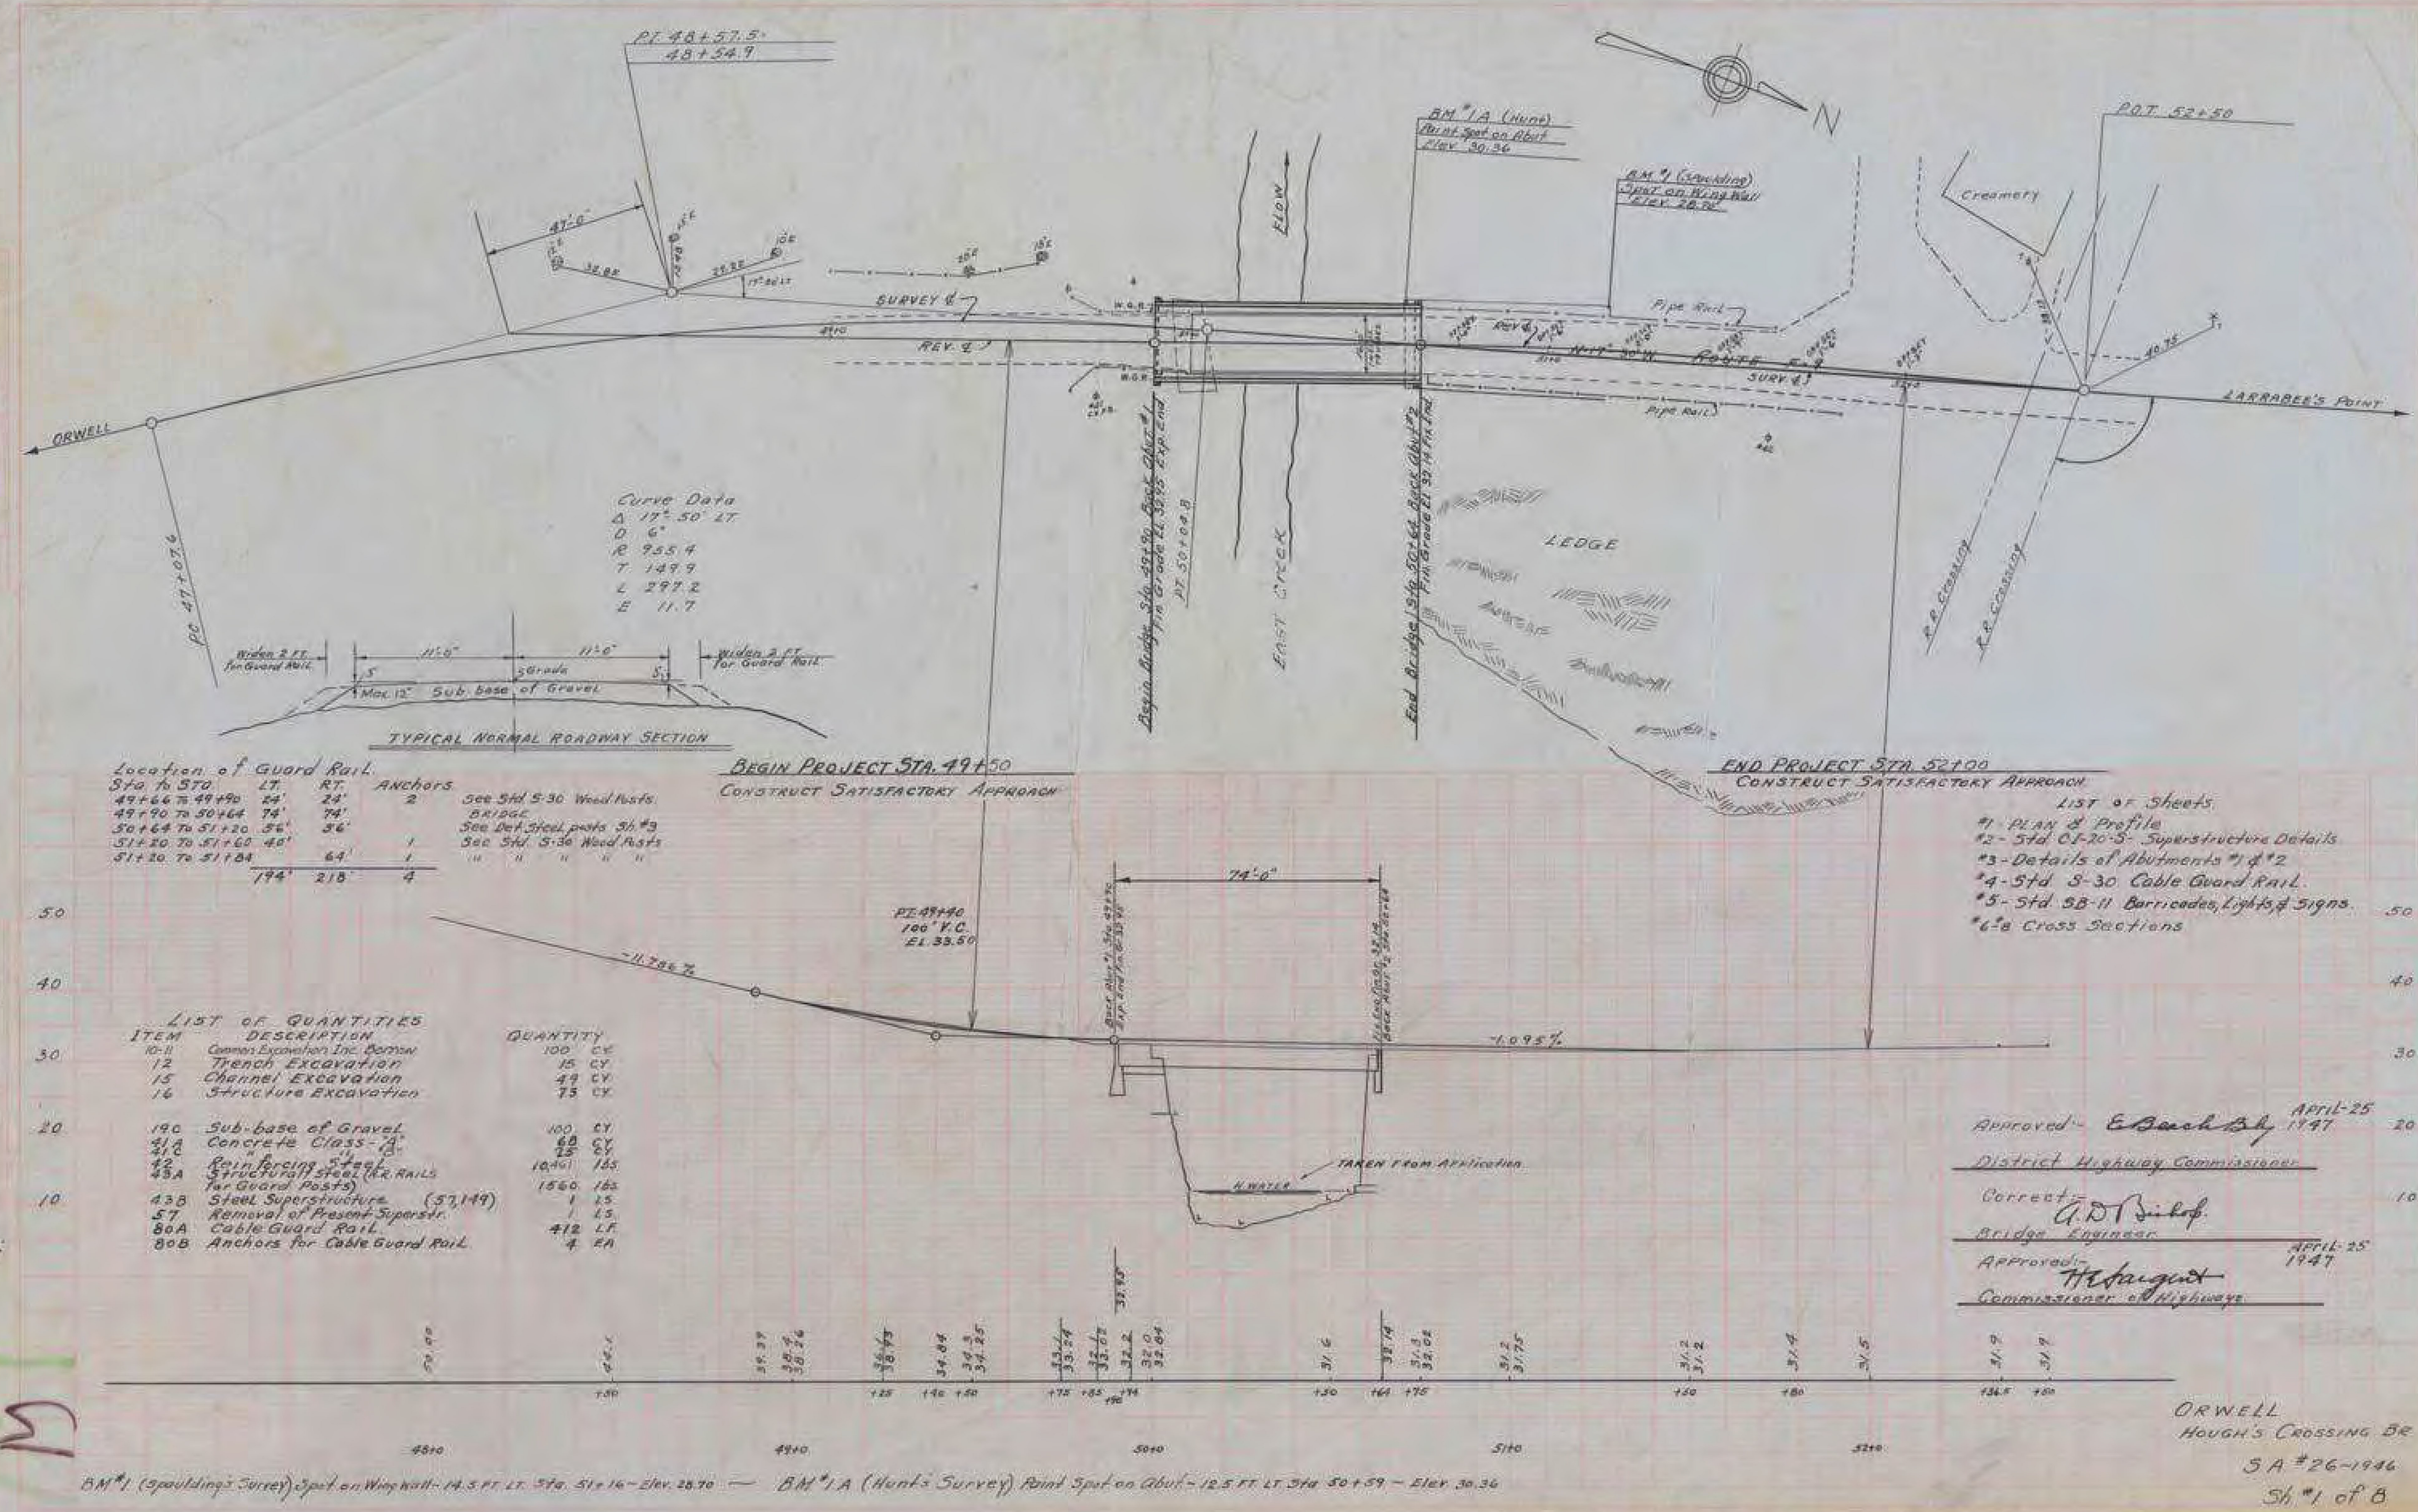

ORWELL
 STP DECK(41)
 BRIDGE NO. 4
 SHEET 23 OF 27
 FOR REFERENCE ONLY