
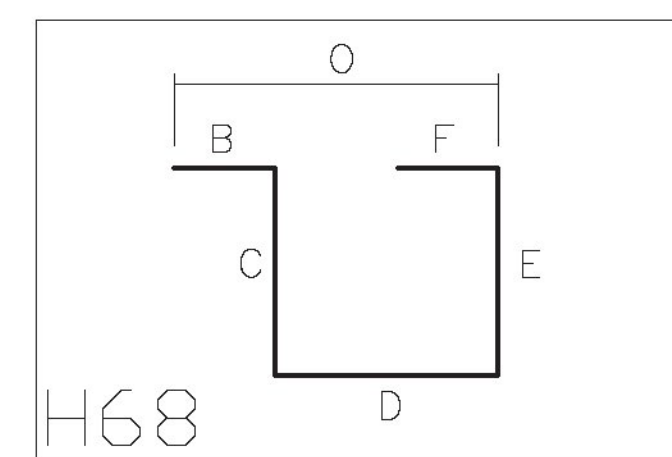


Release Number: 001

BAR LIST 

Bar Mark	Qty	Size	Total Length	Type	'A'	'B'	'C'	'D'	'E'	'F'	'G'	'H'	'J'	'K'	'O'	'R'
5AE01	128	#5	38'-3"			38'-3"										
5AE02	99	#5	24'-6"			24'-6"										
5AE03	210	#5	4'-11"	H68		1'-0"	0'-7 1/2"	1'-5"	0'-10 1/2"	1'-0"					2'-5"	
5AE04	14	#5	13'-6 1/2"	H68		3'-0"	3'-4 1/2"	0'-7"	3'-7"	3'-0"					3'-7"	
5AE05	4	#5	13'-10 1/2"	H68		3'-0"	3'-6 1/2"	0'-7"	3'-9"	3'-0"					3'-7"	
5AE06	4	#5	24'-5"			24'-5"										
5AE07	9	#5	13'-9"			13'-9"										
5AE08	14	#5	12'-8 1/2"	H68		3'-0"	2'-11 1/2"	0'-7"	3'-2"	3'-0"					3'-7"	
5AE09	4	#5	13'-1 1/2"	H68		3'-0"	3'-2"	0'-7"	3'-4 1/2"	3'-0"					3'-7"	
		#														
6AE01	149	#6	24'-6"			24'-6"										

.1 TEST BAR ADDED

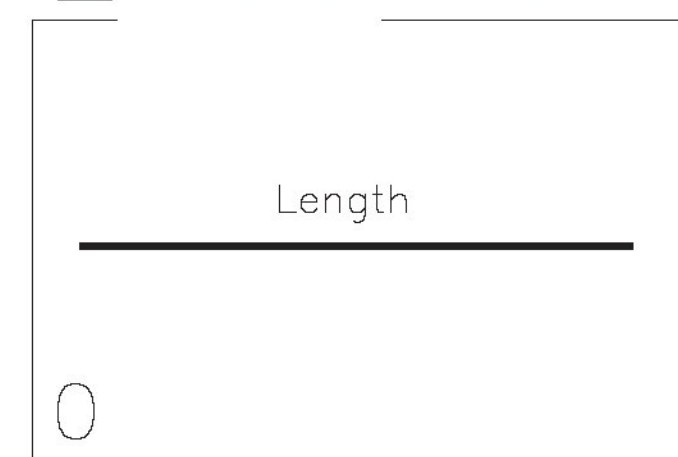

SHOP DRAWING REVIEW

REVIEWED AS REQUIRED BY THE CONSTRUCTION CONTRACT DOCUMENTS AND APPROVED, BUT ONLY FOR CONFORMANCE TO THE DESIGN CONCEPT OF THE WORK, AND SUBJECT TO FURTHER LIMITATIONS AND REQUIREMENTS CONTAINED IN THE CONSTRUCTION CONTRACT DOCUMENTS.

REJECTED     REVISE AND RESUBMIT     APPROVED AS NOTED

CORRECTIONS OR COMMENTS MADE ON THE SHOP DRAWINGS DURING THIS REVIEW DID NOT RELIEVE CONTRACTOR FROM COMPLIANCE WITH REQUIREMENTS OF THE DRAWINGS AND SPECIFICATIONS. THIS CHECK IS ONLY FOR REVIEW OF GENERAL CONFORMANCE WITH THE DESIGN CONCEPT OF THE PROJECT AND GENERAL COMPLIANCE WITH THE INFORMATION GIVEN IN THE CONTRACT DOCUMENTS. THE CONTRACTOR IS RESPONSIBLE FOR: CONFIRMING AND CORRELATING ALL QUANTITIES AND DIMENSIONS; SELECTING FABRICATION PROCESSES AND TECHNIQUES OF CONSTRUCTION; COORDINATING THEIR WORK WITH THAT OF ALL OTHER TRADES; AND PERFORMING THEIR WORK IN A SAFE AND SATISFACTORY MANNER.

**CLD** CLD Consulting Engineers  
540 Commercial Street  
Manchester, NH 03101  
603-888-8225

Job Number: 150223  
Reviewed by: S.BEAUMONT  
Date: 04/05/2017

Vermont Agency of Transportation  
**RECEIVED**

CK'D BY CLD Consulting Engineers    OK'D BY CLD Consulting Engineers

April 5, 2017

RESUBMIT No    Approved AsNoted  
BY Kristin Higgins    DATE 4/5/2017

LEGEND:

CONT.-CONTINUOUS	E.E.-EACH END
TRANS.-TRANSVERSE	E.F.-EACH FACE
DWLS.-DOWELS	N.F.-NEAR FACE
VERTS.-VERTICAL	F.F.-FAR FACE
HORIZ.-HORIZONTAL	E.W.-EACH WAY
T&B -TOP & BOTTOM	O.C.-ON CENTER
I.F.-INNER FACE	L.W.-LONG WAY
O.F.-OUTER FACE	S.W.-SHORT WAY




ELEVATIONS & DIMENSIONS SHOWN ON THIS DWG. ARE FOR REINF. DETAILING PURPOSES ONLY AND ARE NOT INTENDED FOR DIMENSIONAL CONSTRUCTION.

EPOXY REINF. BARS ASTM A615 GRADE 60, MARKED (E)

VERIFICATION OF UNCLEAR INFORMATION MAY BE REQUESTED ON THIS DRAWING. SHOULD VERIFICATION BE LEFT UN-ADDRESSED IT WILL REMAIN AS SHOWN AND ASSUME TO BE CORRECT.

WORK THIS DRAWING WITH DRAWINGS A, A1, & A2

FOR APPROVAL

6			
5			
4			
3	4/3/17		REVISED PER APPROVAL / FOR APPROVAL
2	3/20/17		REVISED PER APPROVAL / FOR APPROVAL
1	2/13/17	-	FOR APPROVAL
	DATE	REV.#	SENT FOR
	 <b>DIMENSION</b> DIMENSION FABRICATORS INC.		
	2000 7TH STREET SCOTIA, N.Y. 12302 PH: (518) 374-1936 FAX (518) 374-4830 www.dimensionfabricators.com		
STRUCTURE	VTAOT ORWELL STP DECK (41) STATE ROUTE 73, BRIDGE #4		
LOCATION	TOWN OF ORWELL, COUNTY OF ADDISON		
ARCHITECT			
ENGINEER	CLD CONSULTING ENGINEERS		
CUSTOMER	COLD RIVER BRIDGES, LLC		
DRAWN BY	DATE	DFI #	
CMB	2/11/17	10116	
DRAWING COVERS			DRAWING #
DECK SLAB & CURTAIN WALL			A3