

Record Plans

Contractor: F.R. LAFAYETTE INC.
 Resident Engineer: CHRIS ACHILLES
 Construction Began: NOVEMBER 3, 2016
 Construction Complete: DECEMBER 4, 2018
 Record Plans By: CHRIS ACHILLES & RYAN GREENE

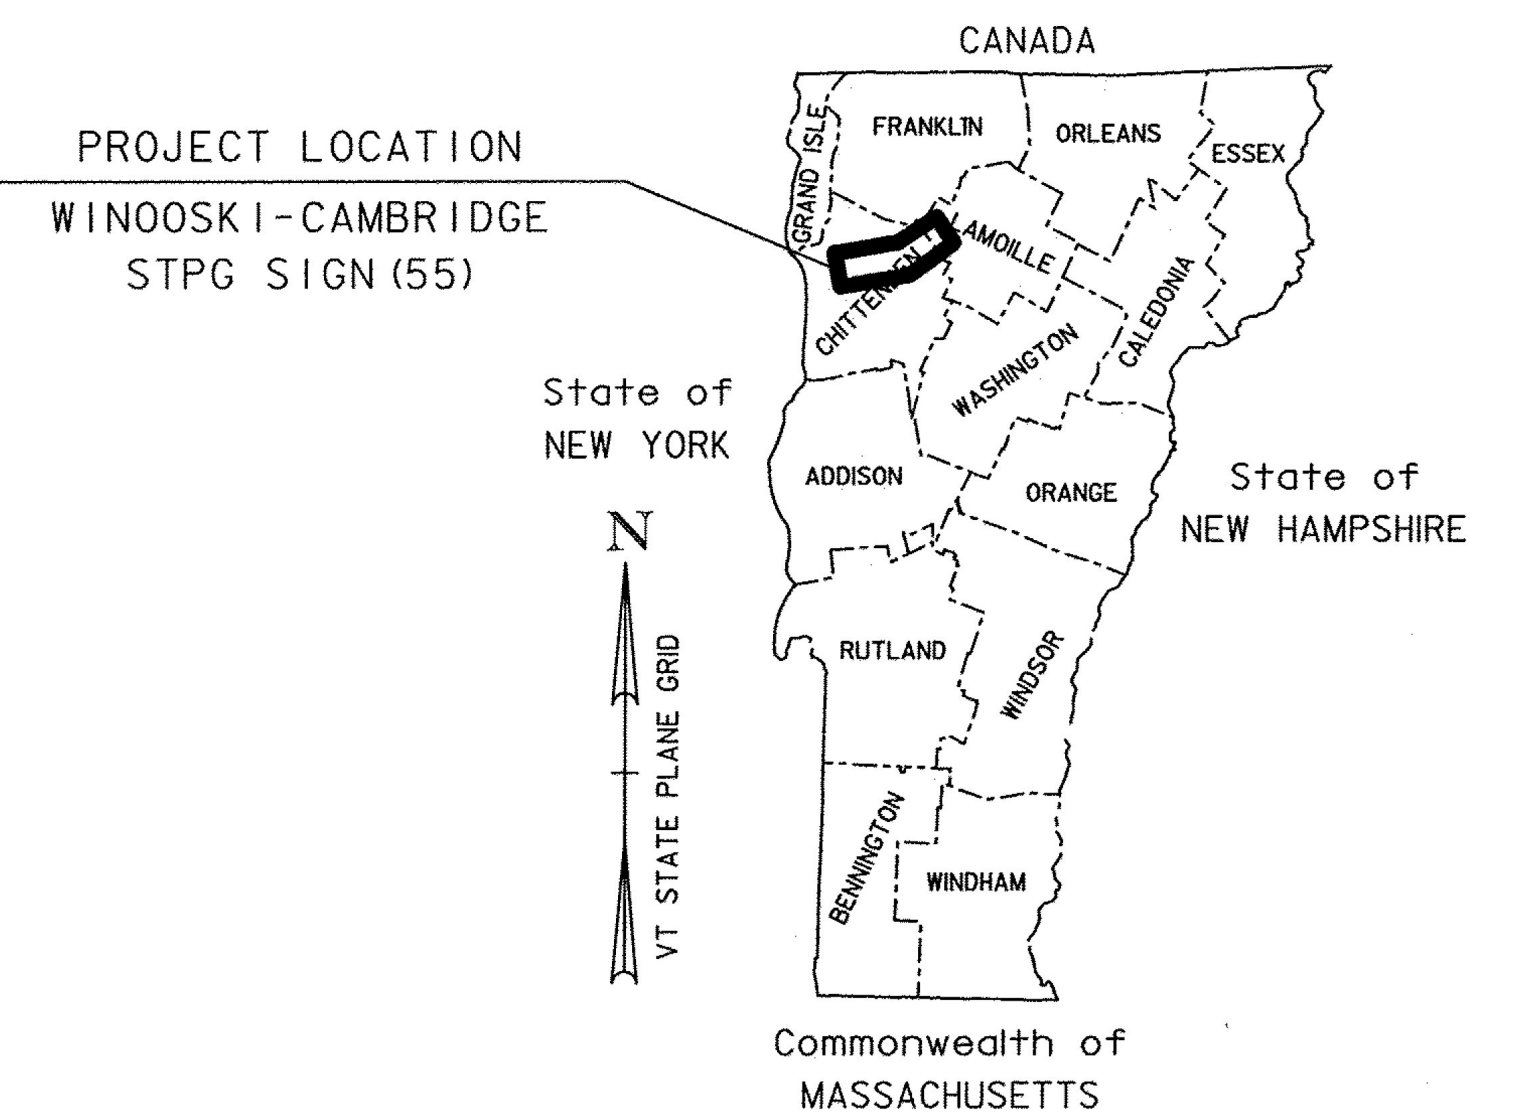
I hereby certify that all construction required by this set of drawings has been accomplished as indicated herein.

DocuSigned by:
 BY:  Resident Engineer
 348BE7E67CF2432...

Date: 7/25/2022

NOTE: Any further information concerning final quantities, amounts or other details relative to this project may be found at Central Files in the electronic archives.

STATE OF VERMONT AGENCY OF TRANSPORTATION



PROPOSED IMPROVEMENT TOWNS OF WINOOSKI, COLCHESTER, ESSEX, JERICHO, UNDERHILL, WESTFORD AND CAMBRIDGE COUNTIES OF CHITTENDEN AND LAMOILLE VT ROUTE 15 (PRINCIPAL ARTERIAL (NHS) AND MINOR ARTERIAL)

WINOOSKI TO CAMBRIDGE SIGN REPLACEMENT - 21.244 MILES (112168.32 FEET):

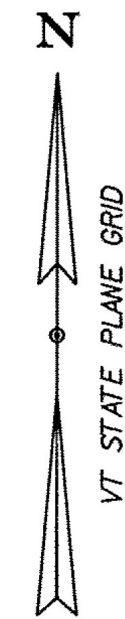
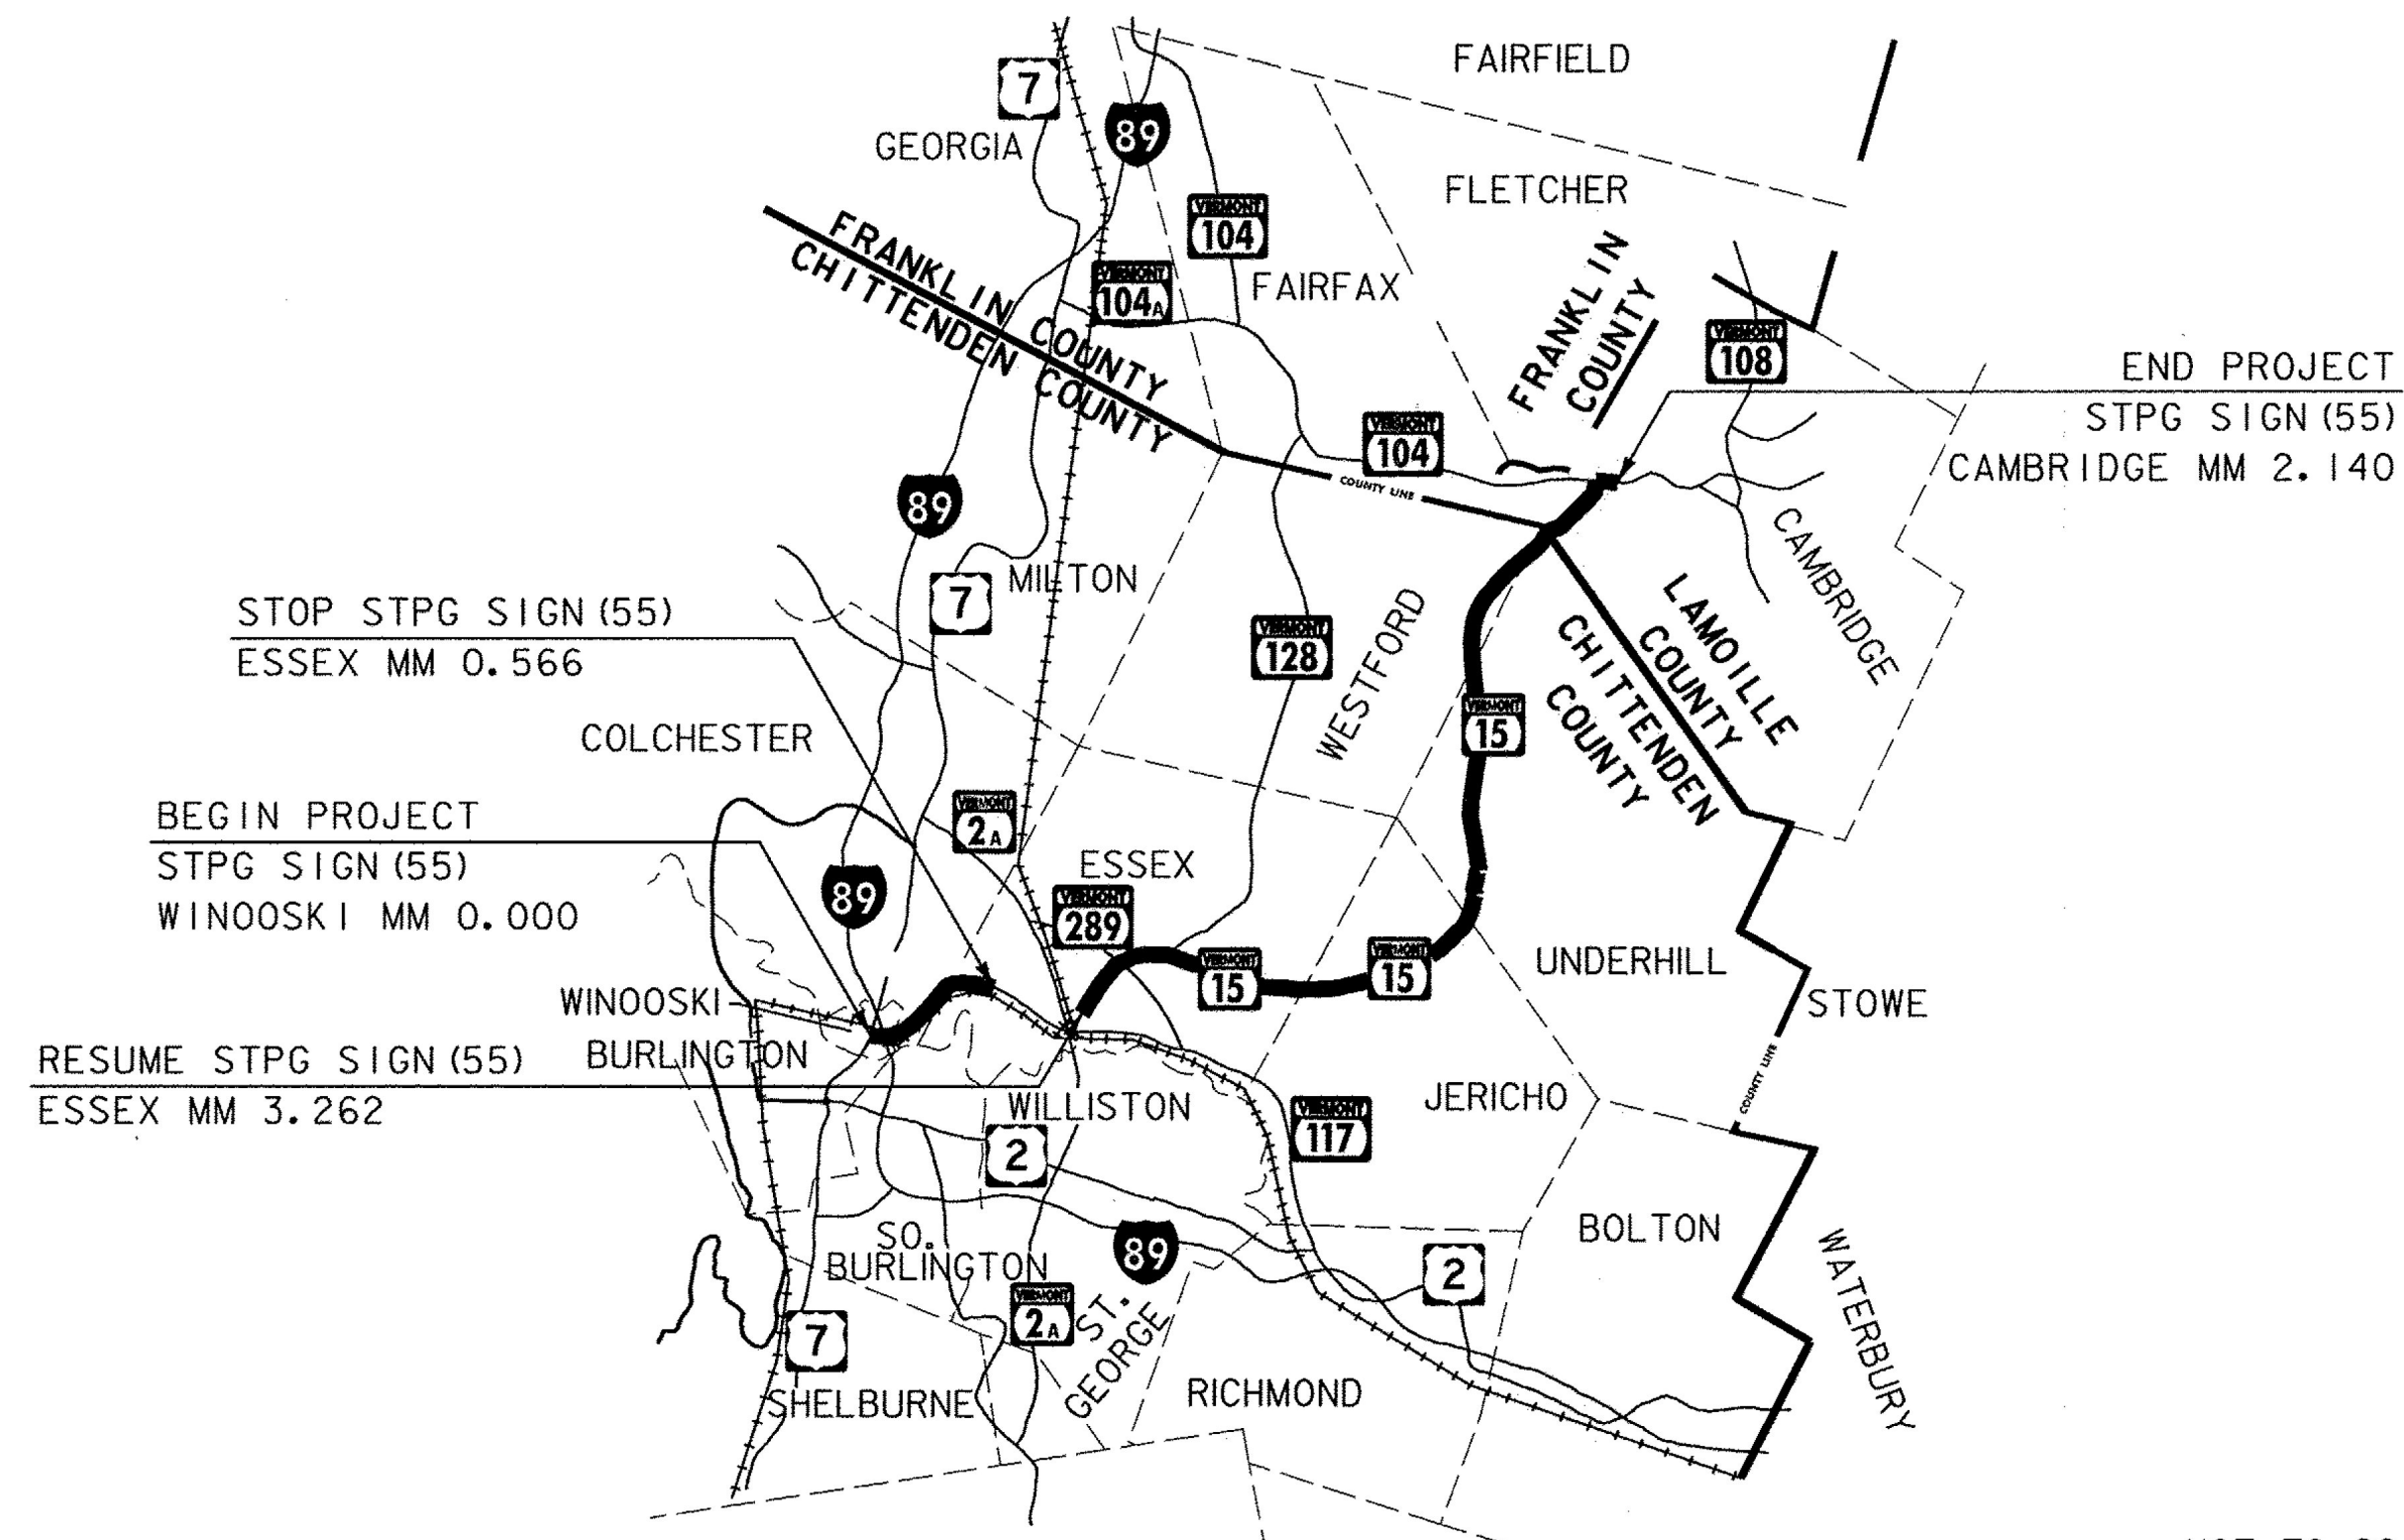
WINOOSKI	MM 0.000 - 0.760	(4012.80 FEET)
COLCHESTER	MM 0.000 - 1.360	(7180.80 FEET)
ESSEX	MM 0.000 - 0.566	(2988.48 FEET)
ESSEX	MM 3.262 - 8.130	(25703.04 FEET)
JERICHO	MM 0.000 - 3.785	(19984.80 FEET)
UNDERHILL	MM 0.000 - 4.945	(26109.60 FEET)
WESTFORD	MM 0.000 - 2.820	(14889.60 FEET)
CAMBRIDGE	MM 0.000 - 2.140	(11299.20 FEET)

TOTAL LENGTH OF PROJECT: = 21.244 MILES (112168.32 FEET)
 TOTAL LENGTH OF ROADWAY: = 21.244 MILES (112168.32 FEET)

WORK TO BE PERFORMED INCLUDES THE REMOVAL OF EXISTING SIGNS AND POSTS
 AND THE INSTALLATION OF NEW SIGNS AND POSTS AND OTHER RELATED HIGHWAY ITEMS.



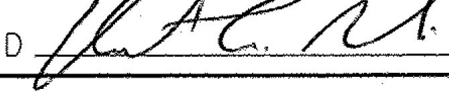
CHANGES MADE ON THE FOLLOWING PAGES:
 23, 25, 43

CONSTRUCTION IS TO BE CARRIED ON IN ACCORDANCE WITH THESE PLANS AND THE STANDARD SPECIFICATIONS FOR CONSTRUCTION DATED 2011, AS APPROVED BY THE FEDERAL HIGHWAY ADMINISTRATION ON JULY 20, 2011 FOR USE ON THIS PROJECT, INCLUDING ALL SUBSEQUENT REVISIONS AND SUCH REVISED SPECIFICATIONS AND SPECIAL PROVISIONS AS ARE INCORPORATED IN THESE PLANS.



NOT TO SCALE

QUALITY ASSURANCE PROGRAM : LEVEL I	
SURVEYED BY :	N/A
SURVEYED DATE :	N/A
DATUM	
VERTICAL	N/A
HORIZONTAL	N/A

	 Stantec Consulting Services Inc. <small>55 Green Mountain Drive South Burlington VT U.S.A. 05403 Phone: (802) 864-0223 Fax: (802) 864-0165 www.stantec.com</small>	DIRECTOR OF PROJECT DELIVERY APPROVED:  DATE 6/15/2016
	PROJECT MANAGER : PATRICIA COBURN, PE	
	PROJECT NAME : WINOOSKI-CAMBRIDGE PROJECT NUMBER : STPG SIGN (55)	
	SHEET 1 OF 192 SHEETS	