



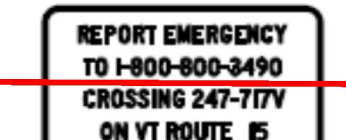
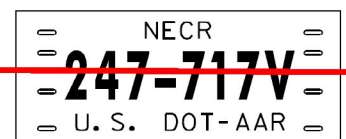


DIRECTION	MILEPOINT	LOCATION CODE (SHEET 2)	SIGN CODE	WIDTH (IN)	HEIGHT (IN)	SHEETING REMARKS	SIGN LEGEND	NEW SIGNS		EXISTING SIGNS			EXIST POST		NUMBER OF NEW POSTS	SQUARE STEEL (IN)			TUBULAR STEEL Ø (IN)				SIGN FRAME REQUIRED	REMARKS	SIGN DETAIL LOCATION						
								"A"	"B"	RETAIN	SALVAGE FROM	SALVAGE TO	REMOVE	RETAIN		REMOVE	1.75	2.00	2.50	FOUNDATION	3.00	3.50			4.00	5.00	SHSM	PROJECT SHEET #	STANDARD SHEET #		
																	(LB / FT)				(LB / FT)										
WINOOSKI VT-15 EB							FY-FLUORESCENT YELLOW FYG-FLUORESCENT YELLOW GREEN															"SHSM"-STANDARD HIGHWAY SIGNS AND MARKINGS									
EB	0.321	A	W10-1	36	36			9.00						1	X								LOCATE 100 FEET WEST FROM EXISTING LOCATION OF W10-12 SKEWED CROSSING SIGN	X							
EB	0.340	A	W10-12	36	36		SKEWED CROSSING / SYMBOL			1													THINNING AND TRIMMING NEEDED FROM HERE TO SIGNAL								
EB	0.350	J	R4-7	24	30		RIGHT BULLNOSE																								
		J	OM1-1	18	18		YELLOW CLUSTER																								
		K	OM1-1	18	18		YELLOW CLUSTER																								
		J	R4-7	24	30			5.00						1	X										X						
		J	OM1-1	18	18			2.25																	X						
		K	OM1-1	18	18			2.25																	X						
EB	0.360	A	R15-1	N/A	N/A		CROSSBUCK																THINNING AND TRIMMING NEEDED								
		A	UNK.	12	9		REPORT PROBLEM RR X-ING																MOUNT NEW SIGNS ON EXISTING RAILROAD SIGNAL POLE;								
		A	R15-1	48	9			6.00															OVERLAY THE ENTIRE BACK OF CROSSBUCK SIGN WITH REFLECTIVE SHEETING;	X							
		A	I-13a	30	18			3.75															SEE NOTES & DETAIL ON SHEET 16			16					
		A	UNK.	9	4			0.25															<div style="border: 1px dashed red; border-radius: 15px; padding: 5px; display: inline-block;">DID NOT DO WORK RELATED TO R.R. AS PER P.M.</div>			16					
EB	0.360	J	R3-2	24	24		NO LEFT TURN																								
		J	OM1-1	18	18		YELLOW CLUSTER																								
SIGN SUMMARY SHEET							SHEET TOTALS										PROJECT NAME: WINOOSKI-CAMBRIDGE														
							28.50	0.00	1	0	0	7	0	0	2	30.0	0	0.0	0.0	0.0	0.0	PROJECT NUMBER: STPG SIGN(55)									
							SF	SF	EA	EA	EA	EA	EA	EA	EA	FT	EA	LB	LB	LB	LB	FILE NAME: WINOOSKI VT15 EB TSS.xls									
VERMONT AGENCY OF TRANSPORTATION							TOWN DIRECTIONAL TOTALS										PLOT DATE: 6/14/2016														
							443.72	0.0	15	2	2	97	0	0	34	510.0	2				198.0	DRAWN BY: D. DRAPER									
																	DESIGNED BY: D. DRAPER														
																	CHECKED: M. FOISY														
																	SHEET 25 OF 192														