
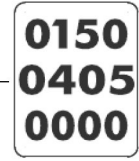
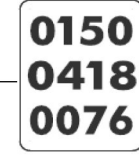





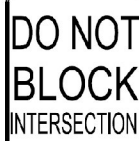


DIRECTION	MILEPOINT	LOCATION CODE (SHEET Z)	SIGN CODE	WIDTH (IN)	HEIGHT (IN)	SHEETING REMARKS	SIGN LEGEND	NEW SIGNS		EXISTING SIGNS				EXIST POST		NUMBER OF NEW POSTS	SQUARE STEEL (IN)			TUBULAR STEEL Ø (IN)				SIGN FRAME REQUIRED	REMARKS	SIGN DETAIL LOCATION			
								"A"	"B"	RETAIN	SALVAGE FROM	SALVAGE TO	REMOVE	RETAIN	REMOVE		1.75	2.00	2.50	FOUNDATION	3.00	3.50	4.00			5.00	SHSM	PROJECT SHEET #	STANDARD SHEET #
																	(LB / FT)				(LB / FT)								
COLCHESTER VT-15 EB							FY-FLUORESCENT YELLOW FYG-FLUORESCENT YELLOW GREEN															"SHSM"-STANDARD HIGHWAY SIGNS AND MARKINGS							
EB	0.000	C	VR-024	72	10			5.00							2	X													
		C	VD-700	6	10			0.42																				T-94	
		C	VD-700	6	10			0.42																				T-44	
EB	0.001	A	R2-1	24	30		SPEED LIMIT 35					1	X																
		A	VR-039	24	18		STATE HIGHWAY BEGINS					1																	
		A	VD-700	6	10		MILE MARKER 0001			1		1																	
		B	VR-038	24	18		STATE HIGHWAY ENDS					1																	
		A	R2-1	30	36			7.50																X					
		A	VR-039	24	18			3.00																			T-71		
		A	VD-700	6	10						1																		
		B	VR-038	24	18			3.00																			T-71		
EB	0.093	A	VM-607	36	30		GRAND ARMY OF THE REPUBLIC HIGHWAY			1			X																
EB	0.163	A	VR-934	48	30		LEFT ONLY/STRAIGHT/STRAIGHT AND RIGHT					1	X																
		A	VR-934	48	30			10.00																			E-145B		
EB	0.198	A	R10-7	24	30			5.00							1	X								X					
SIGN SUMMARY SHEET							SHEET TOTALS	34.34	0.00	1	1	1	5	0	0	3	45.0	0	0.0	0.0	0.0	0.0	PROJECT NAME: WINOOSKI - CAMBRIDGE PROJECT NUMBER: STPG SIGN(55)						
VERMONT AGENCY OF TRANSPORTATION							TOWN DIRECTIONAL TOTALS	554.28	0.0	43	12	12	91	0	0	41	615.0	0		0.0			FILE NAME: COLCHESTER VT15 EB TSS.x PLOT DATE: 6/14/2016 PROJECT MANAGER: M. FOISY DRAWN BY: G. BARRETT DESIGNED BY: G. BARRETT CHECKED M. FOISY COLCHESTER EB SHEET 1 SHEET 50 OF 192						