




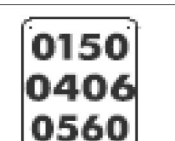



DIRECTION	MILEPOINT	LOCATION CODE (SHEET Z)	SIGN CODE	WIDTH (IN)	HEIGHT (IN)	SHEETING REMARKS	SIGN LEGEND	NEW SIGNS		EXISTING SIGNS			EXIST POST		NUMBER OF NEW POSTS	SQUARE STEEL (IN)			TUBULAR STEEL Ø (IN)				SIGN FRAME REQUIRED	REMARKS	SIGN DETAIL LOCATION				
								"A"	"B"	RETAIN	SALVAGE FROM	SALVAGE TO	REMOVE	RETAIN		REMOVE	1.75	2.00	2.50	FOUNDATION	3.00	3.50			4.00	5.00	SHSM	PROJECT SHEET #	STANDARD SHEET #
																	(LB / FT)				(LB / FT)								
ESSEX VT-15 EB							FY-FLUORESCENT YELLOW FYG-FLUORESCENT YELLOW GREEN															"SHSM"-STANDARD HIGHWAY SIGNS AND MARKINGS							
		C	R5-1	30	30			6.25															SAND HILL RD (TH-4)	X					
EB	5.622	D	R1-1	30	30			6.25						1	X								SAND HILL RD (TH-4)	X					
EB	5.623	A	M3-2	24	12		EAST					1	X																
		A	M1-5	24	24		VERMONT 15					1																	
		A	M6-1	21	15		ARROW LEFT					1																	
		A	VD-700	6	10		MILE MARKER 0560			1	1																		
		A	M3-2	24	12	GRN WHT		2.00						1	X									X					
		A	M1-5	24	24	GRN WHT		4.00																	E-136B				
		A	M6-1	21	15	GRN WHT		2.19																X					
		A	VD-700	6	10						1																		
EB	5.632	C	UNK.	18	24		NO THRU TRUCK TRAFFIC					1	X												SAND HILL RD (TH-4); REMOVE SIGN AND RETURN TO TOWN				
		C	R12-1	24	30		WEIGHT LIMIT 12 TONS					1													SAND HILL RD (TH-4); REMOVE SIGN AND RETURN TO TOWN				
		C	VR-017	24	30			5.00						1	X										SAND HILL RD (TH-4)	T-70			
EB	5.642	D	R1-1	30	30		STOP					1	X																
		D	R3-2	24	18		NO LEFT TURN					1																	
SIGN SUMMARY SHEET							SHEET TOTALS	25.69	0.00	0	1	1	8	0	0	3	45.0	0	0.0	0.0	0.0	0.0	PROJECT NAME: WINOOSKI - CAMBRIDGE						
VERMONT AGENCY OF TRANSPORTATION							TOWN DIRECTIONAL TOTALS	SF	SF	EA	EA	EA	EA	EA	EA	EA	FT	EA	LB	LB	LB	LB							
								853.87	0.0	34	20	20	202	0	0	104	1560.0	0		0.0		PROJECT NUMBER: STPG SIGN(55)							
																						FILE NAME: ESSEX VT15 EB TSS.xls							
																						PLOT DATE: 6/14/2016							
																						DRAWN BY: G. BARRETT							
																						CHECKED M. FOISY							
																						DESIGNED BY: G. BARRETT							
																						ESSEX EB SHEET 25							
																						SHEET 98 OF 192							