
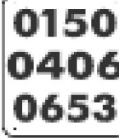







DIRECTION	MILEPOINT	LOCATION CODE (SHEET 2)	SIGN CODE	WIDTH (IN)	HEIGHT (IN)	SHEETING REMARKS	SIGN LEGEND	NEW SIGNS		EXISTING SIGNS			EXIST POST		NUMBER OF NEW POSTS	SQUARE STEEL (IN)			TUBULAR STEEL Ø (IN)				SIGN FRAME REQUIRED	REMARKS	SIGN DETAIL LOCATION				
								"A"	"B"	RETAIN	SALVAGE FROM	SALVAGE TO	REMOVE	RETAIN		REMOVE	1.75	2.00	2.50	FOUNDATION	3.00	3.50			4.00	5.00	SHSM	PROJECT SHEET #	STANDARD SHEET #
																	(LB / FT)				(LB / FT)								
<b>ESSEX VT-15 EB</b>							FY-FLUORESCENT YELLOW FYG-FLUORESCENT YELLOW GREEN															"SHSM"-STANDARD HIGHWAY SIGNS AND MARKINGS							
		D	R1-1	30	30			6.25						1		X							ALLEN MARTIN DR (TH-8)	X					
		C	VD-700	6	10						1												ALLEN MARTIN DR (TH-8)						
EB	6.530	A	D3-1	40	9		ALLEN MARTIN DR					1	X										ALLEN MARTIN DR (TH-8)						
		C	D3-1	42	12			3.50						2		X							ALLEN MARTIN DR (TH-8)		12				
		A	D3-1	48	12			4.00															ALLEN MARTIN DR (TH-8)		9				
EB	6.530	D	R1-1	30	30		STOP					1	X										ALLEN MARTIN DR (TH-8)						
		D	R1-1	30	30			6.25						1		X							ALLEN MARTIN DR (TH-8); THINNING AND TRIMMING NEEDED	X					
EB	6.912	A	R2-1	24	30		SPEED LIMIT 50					1	X																
		A	R2-1	24	30			5.00																	X				
EB	6.922	A	D3-1	24	6		LEO DR					1	X										LEO DR (TH-713)						
EB	6.922	C	VR-017	24	30		LLL 24,000					1	X										LEO DR (TH-713)						
		C	VR-017	24	30			5.00															LEO DR (TH-713)			T-70			
<b>SIGN SUMMARY SHEET</b>							SHEET TOTALS	30.00	0.00	0	0	1	5	0	0	4	60.0	0	0.0	0.0	0.0	0.0	0.0	PROJECT NAME: <b>WINOOSKI - CAMBRIDGE</b> PROJECT NUMBER: <b>STPG SIGN(55)</b>					
VERMONT AGENCY OF TRANSPORTATION							TOWN DIRECTIONAL TOTALS	853.87	0.0	34	20	20	202	0	0	104	1560.0	0		0.0				FILE NAME: <b>ESSEX VT15 EB TSS.xls</b> PLOT DATE: <b>6/14/2016</b> PROJECT MANAGER: <b>M. FOISY</b> DRAWN BY: <b>G. BARRETT</b> DESIGNED BY: <b>G. BARRETT</b> CHECKED: <b>M. FOISY</b> ESSEX EB SHEET 29 SHEET <b>102</b> OF <b>192</b>					