




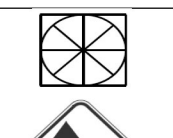



| DIRECTION | MILEPOINT | LOCATION CODE (SHEET 2) | SIGN CODE | WIDTH (IN) | HEIGHT (IN) | SHEETING REMARKS | SIGN LEGEND | NEW SIGNS | | EXISTING SIGNS | | | EXIST POST | | NUMBER OF NEW POSTS | SQUARE STEEL (IN) | | | TUBULAR STEEL Ø (IN) | | | | SIGN FRAME REQUIRED | REMARKS | SIGN DETAIL LOCATION | | | | |
|----------------------------------|-----------|-------------------------|-----------|------------|-------------|------------------|---|-----------|------|----------------|--------------|------------|------------|--------|---------------------|-------------------|-----------|------|----------------------|------------|-----------|------|--|---|-----------------------------|------|------|-----------------|------------------|
| | | | | | | | | "A" | "B" | RETAIN | SALVAGE FROM | SALVAGE TO | REMOVE | RETAIN | | REMOVE | 1.75 | 2.00 | 2.50 | FOUNDATION | 3.00 | 3.50 | | | 4.00 | 5.00 | SHSM | PROJECT SHEET # | STANDARD SHEET # |
| | | | | | | | | | | | | | | | | | (LB / FT) | | | | (LB / FT) | | | | | | | | |
| JERICHO VT-15 WB | | | | | | | FY-FLUORESCENT YELLOW FYG-FLUORESCENT YELLOW GREEN | | | | | | | | | | | | | | | | "SHSM"-STANDARD HIGHWAY SIGNS AND MARKINGS | | | | | | |
| WB | 0.723 | F | W11-2 | 30 | 30 | | PEDESTRIAN | | | | | 1 | | X | | | | | | | | | | | | | | | |
| | | F | W16-4P | 24 | 18 | | NEXT 2500 FEET | | | | | 1 | | | | | | | | | | | | | | | | | |
| | | F | W11-2 | 30 | 30 | FYG |  | 6.25 | | | | | | | 1 | X | | | | | | | | | | | X | | |
| | | F | W16-4P | 30 | 24 | FYG |  | 5.00 | | | | | | | | | | | | | | | | | | | X | | |
| WB | 0.678 | F | W7-1 | 30 | 30 | | TRUCK GRADE | | | | | 1 | | X | | | | | | | | | | | | | | | |
| | | F | W7-2b | 24 | 18 | | TRUCKS USE LOWER GEAR | | | | | 1 | | | | | | | | | | | | | | | | | |
| | | F | W7-1 | 30 | 30 | |  | 6.25 | | | | | | | | | | | | | | | | | | | | X | |
| | | F | W7-2bP | 24 | 18 | |  | 3.00 | | | | | | | | | | | | | | | | | | | | X | |
| WB | 0.653 | F | VR-020 | 24 | 30 | | NO PARKING ON TRAVELED LANE | | | | | 1 | | X | | | | | | | | | | | | | | | |
| | | F | VR-020 | 24 | 30 | |  | 5.00 | | | | | | | | | | | | | | | | | | | | | E-146 |
| WB | 0.628 | F | W1-3L | 36 | 36 | | MULTIPLE CURVES WARNING | | | | | 1 | | X | | | | | | | | | | | | | | | |
| | | F | W13-1P | 18 | 18 | | 15 MPH | | | | | 1 | | | | | | | | | | | | | | | | | |
| | | F | W1-3L | 36 | 36 | |  | 9.00 | | | | | | | 2 | X | | | | | | | | | | | X | | |
| | | F | W13-1P | 18 | 18 | |  | 2.25 | | | | | | | | | | | | | | | | | | | X | | |
| WB | 0.583 | F | VD-062B | 72 | 16 | | BUSINESS SIGN-SNOWFLAKE BENTLEY/ EXHIBIT AT THE OLD MILL 2/10 | | | 1 | | | | X | | | | | | | | | | | | | | | |
| SIGN SUMMARY SHEET | | | | | | | SHEET TOTALS | 36.75 | 0.00 | 1 | 0 | 0 | 7 | 0 | 0 | 3 | 45.0 | 0 | 0.0 | 0.0 | 0.0 | 0.0 | | PROJECT NAME: WINOOSKI - CAMBRIDGE | | | | | |
| | | | | | | | SF | SF | EA | EA | EA | EA | EA | EA | EA | EA | FT | EA | LB | LB | LB | LB | | PROJECT NUMBER: STPG SIGN(55) | | | | | |
| VERMONT AGENCY OF TRANSPORTATION | | | | | | | TOWN DIRECTIONAL TOTALS | 376.57 | 0.0 | 12 | 16 | 16 | 94 | 0 | 0 | 27 | 405.0 | 0 | | 0.0 | | | | FILE NAME: JERICHO VT15 WB TSS.xls | PLOT DATE: 6/14/2016 | | | | |
| | | | | | | | | | | | | | | | | | | | | | | | PROJECT MANAGER: M. FOISY | DRAWN BY: G. BARRETT | | | | | |
| | | | | | | | | | | | | | | | | | | | | | | | DESIGNED BY: G. BARRETT | CHECKED: M. FOISY | | | | | |
| | | | | | | | | | | | | | | | | | | | | | | | JERICHO WB SHEET 10 | SHEET 152 OF 192 | | | | | |