

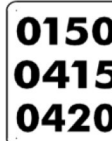








DIRECTION	MILEPOINT	LOCATION CODE (SHEET 2)	SIGN CODE	WIDTH (IN)	HEIGHT (IN)	SHEETING REMARKS	SIGN LEGEND	NEW SIGNS		EXISTING SIGNS			EXIST POST		NUMBER OF NEW POSTS	SQUARE STEEL (IN)			TUBULAR STEEL Ø (IN)				SIGN FRAME REQUIRED	REMARKS	SIGN DETAIL LOCATION							
								"A"	"B"	RETAIN	SALVAGE FROM	SALVAGE TO	REMOVE	RETAIN		REMOVE	1.75	2.00	2.50	FOUNDATION	3.00	3.50			4.00	5.00	SHSM	PROJECT SHEET #	STANDARD SHEET #			
																	(LB / FT)				(LB / FT)											
<b>UNDERHILL VT-15 EB</b>							FY-FLUORESCENT YELLOW FYG-FLUORESCENT YELLOW GREEN															"SHSM"-STANDARD HIGHWAY SIGNS AND MARKINGS										
		A	W2-2	30	30			6.25						1	X									X								
		A	VW-092	30	24			5.00																	14							
		A	VD-700	6	10						1																					
EB	4.361	C	VR-017	24	30		LLL 24,000 LBS					1	X																			
		C	VR-017	24	30			5.00						1	X											T-70						
EB	4.371	A	D3-1	42	6		N UNDERHILL STATION RD					1	X																			
		C	D3-1	42	12			3.50						2	X										12							
		A	D3-1	66	12			5.50																	11							
EB	4.375	D	R1-1	30	30		STOP					1	X																			
		C	VD-700	6	10		MILE MARKER 0438				1	1																				
		D	R1-1	30	30			6.25						1	X									X								
		C	VD-700	6	10						1																					
EB	4.467	A	VW-054R	30	30			6.25						1	X											T-80						
EB	4.480	A	VW-054R	30	30		HIDDEN DRIVE RIGHT					1	X																			
EB	4.620	A	W1-4R	30	30		RIGHT REVERSE CURVE					1	X																			
<b>SIGN SUMMARY SHEET</b>							<b>SHEET TOTALS</b>										PROJECT NAME: <b>WINOOSKI-CAMBRIDGE</b>															
							37.75	0.00	0	1	2	6	0	0	6	90.0	0	0.0	0.0	0.0	0.0	PROJECT NUMBER: <b>STPG SIGN(55)</b>										
							SF	SF	EA	EA	EA	EA	EA	EA	EA	FT	EA	LB	LB	LB	LB	FILE NAME: <b>UNDERHILL VT15 EB TSS.xls</b> PLOT DATE: <b>6/14/2016</b>										
VERMONT AGENCY OF TRANSPORTATION							<b>TOWN DIRECTIONAL TOTALS</b>										PROJECT MANAGER: <b>M. FOISY</b> DRAWN BY: <b>G. BARRETT</b>															
							228.41	0.0	3	9	9	53	0	0	27	405.0	0		0.0				DESIGNED BY: <b>G. BARRETT</b> CHECKED: <b>M. FOISY</b>									
																	UNDERHILL EB SHEET 8 SHEET <b>164</b> OF <b>192</b>															