

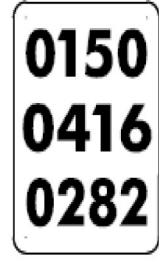
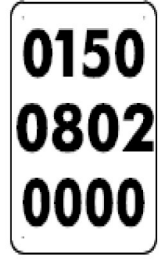


DIRECTION	MILEPOINT	LOCATION CODE (SHEET 2)	SIGN CODE	WIDTH (IN)	HEIGHT (IN)	SHEETING REMARKS	SIGN LEGEND	NEW SIGNS		EXISTING SIGNS			EXIST POST		NUMBER OF NEW POSTS	SQUARE STEEL (IN)			TUBULAR STEEL Ø (IN)				SIGN FRAME REQUIRED	REMARKS	SIGN DETAIL LOCATION				
								"A"	"B"	RETAIN	SALVAGE FROM	SALVAGE TO	REMOVE	RETAIN		REMOVE	1.75	2.00	2.50	FOUNDATION	3.00	3.50			4.00	5.00	SHSM	PROJECT SHEET #	STANDARD SHEET #
																	(LB / FT)				(LB / FT)								
CAMBRIDGE VT-15 WB							FY-FLUORESCENT YELLOW FYG-FLUORESCENT YELLOW GREEN															"SHSM"-STANDARD HIGHWAY SIGNS AND MARKINGS							
		G	VD-700	6	10		MILE MARKER 0000					1																	
		G	VD-024	72	10			5.00						2		X							INSTALL ASSEMBLY ON THE WB SIDE FOR BETTER VISIBILITY			T-94			
		G	VD-024	72	10			5.00																		T-94			
		G	VD-700	6	10			0.42															INSTALL MM PLAQUE 0282 ON LEFT POST			T-44			
		G	VD-700	6	10			0.42															INSTALL MM PLAQUE 0000 ON RIGHT POST			T-44			
SIGN SUMMARY SHEET							SHEET TOTALS	10.84	0.00	0	0	0	1	0	0	2	30.0	0	0.0	0.0	0.0	0.0		PROJECT NAME: WINOOSKI-CAMBRIDGE					
VERMONT AGENCY OF TRANSPORTATION							TOWN DIRECTIONAL TOTALS	SF	SF	EA	EA	EA	EA	EA	EA	EA	FT	EA	LB	LB	LB	LB		PROJECT NUMBER: STPG SIGN(55)					
								226.41	0.0	3	3	3	54	0	0	19	285.0	0		0.0				FILE NAME: CAMBRIDGE VT15 WB TSS.xls PLOT DATE: 6/14/2016					
																							PROJECT MANAGER: M. FOISY DRAWN BY: G. BARRETT						
																							DESIGNED BY: G. BARRETT CHECKED: M. FOISY						
																							CAMBRIDGE WB SHEET 8 SHEET 191 OF 192						