

Record Plans  
 Contractor: F.R. LAFAYETTE, INC.  
 Resident Engineer: BILL CROWTHER  
 Construction Began: SEPTEMBER 27, 2016  
 Construction Complete: APRIL 11, 2017  
 Record Plans By: BILL CROWTHER & JESSE IVES


I hereby certify that all construction required by this set of drawings has been accomplished as indicated herein.

BY: Bill Crowther Resident Engineer

Date: 3/27/2017

NOTE: Any further information concerning final quantities, amounts or other details relative to this project may be found at Central Files in the electronic archives.

# STATE OF VERMONT AGENCY OF TRANSPORTATION

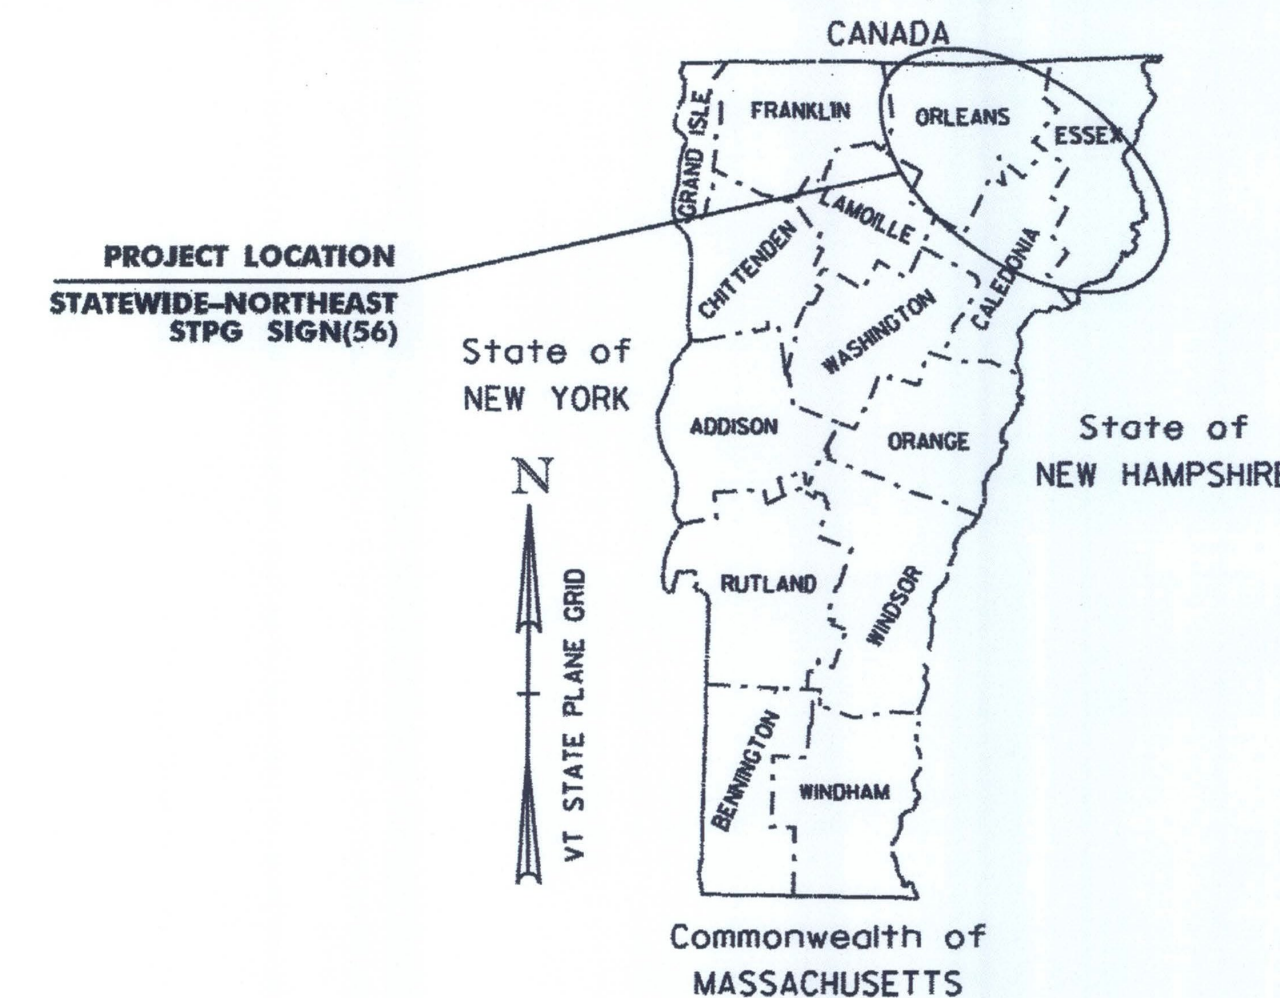

## PROPOSED IMPROVEMENT

**TOWNS OF LYNDON, BURKE, SUTTON, DERBY, EAST HAVEN, NEWARK, BRIGHTON, WESTMORE, BROWNINGTON, CHARLESTON**  
**COUNTIES OF CALEDONIA, ESSEX, ORLEANS**  
**US RTE 5, VT RTE 5A, VT RTE 114 (MAJOR COLLECTORS)**


STATEWIDE NORTHEAST SIGN REPLACEMENT - 56.334 MILES

LYNDON (US-5) MP 3.622 - 7.013, BURKE (US-5) MP 0.000-4.320, SUTTON (US-5) MP 0.000-7.329, DERBY (US-5) MP 5.120-5.934

BURKE (VT-5A) MP 0.000-0.657, SUTTON (VT-5A) MP 0.000-3.204, NEWARK (VT-5A) MP 0.000-0.852, WESTMORE (VT-5A) MP 0.000-7.222, BROWNINGTON (VT-5A) MP 0.000-3.712, CHARLESTON (VT-5A) MP 0.000-3.853

LYNDON (VT-114) MP 0.000-4.030, BURKE (VT-114) MP 0.000-5.013, EAST HAVEN (VT-114) MP 0.000-2.220, NEWARK (VT-114) MP 0.000-5.245, BRIGHTON (VT-114) MP 0.000-4.472.

WORK TO BE PERFORMED INCLUDES THE REMOVAL OF EXISTING SIGNS AND POSTS AND THE INSTALLATION OF NEW SIGNS AND POSTS AND OTHER HIGHWAY RELATED ITEMS.

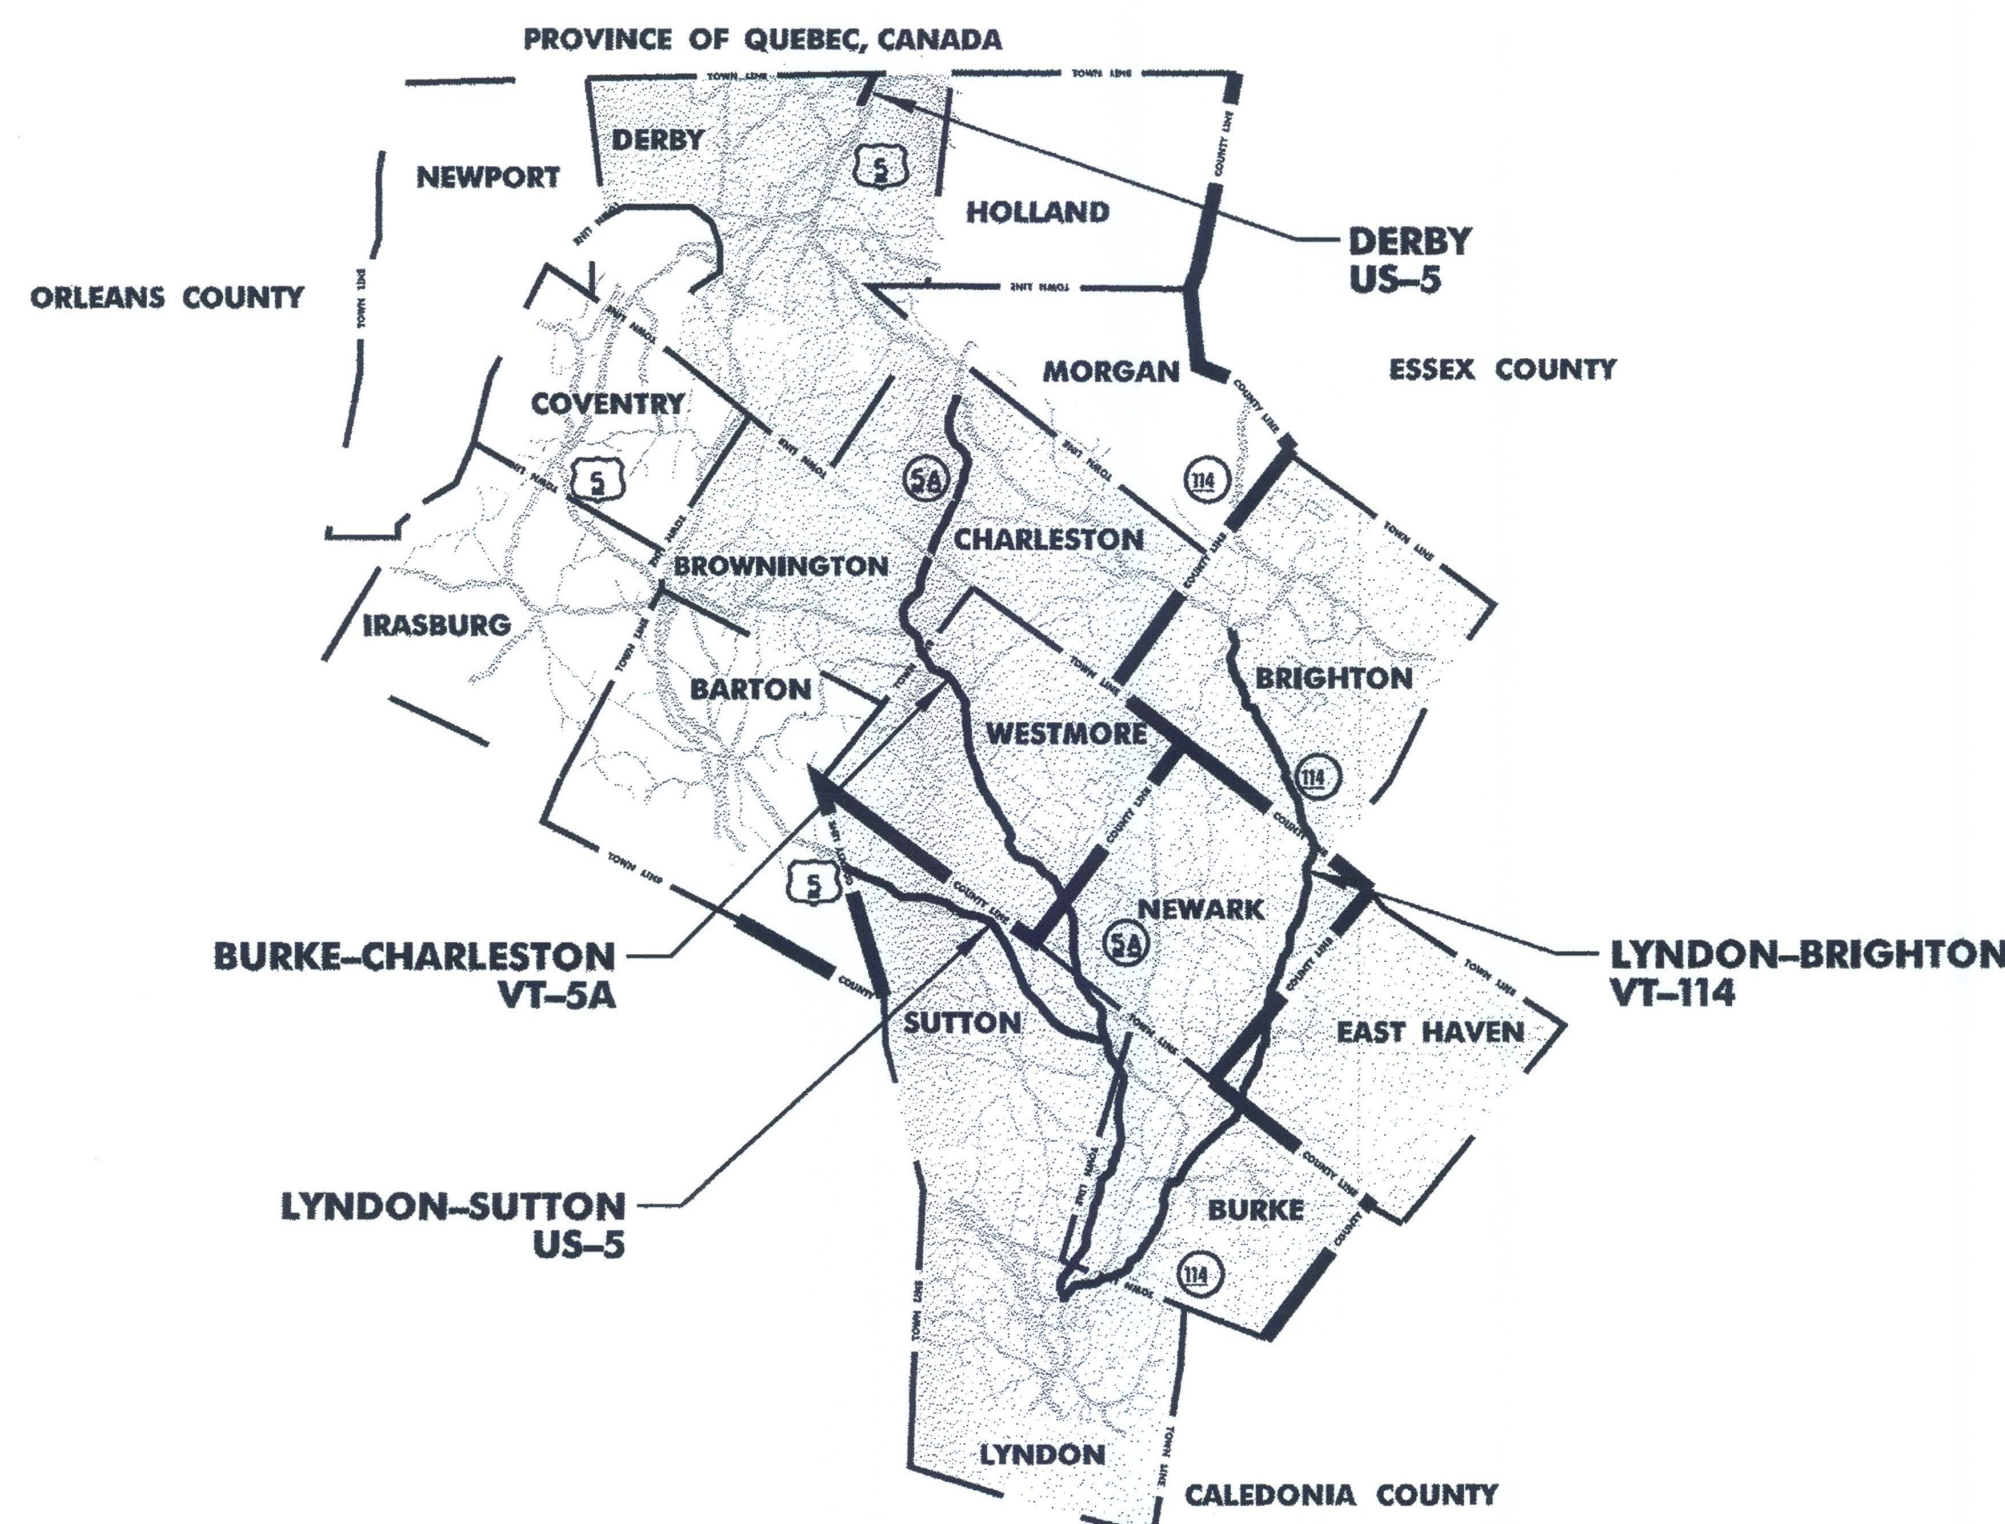

CONSTRUCTION IS TO BE CARRIED ON IN ACCORDANCE WITH THESE PLANS AND THE STANDARD SPECIFICATIONS FOR CONSTRUCTION DATED 2011, AS APPROVED BY THE FEDERAL HIGHWAY ADMINISTRATION ON JULY 20, 2011 FOR USE ON THIS PROJECT, INCLUDING ALL SUBSEQUENT REVISIONS AND SUCH REVISED SPECIFICATIONS AND SPECIAL PROVISIONS AS ARE INCORPORATED IN THESE PLANS.

QUALITY ASSURANCE PROGRAM : LEVEL 3
SURVEYED BY : N/A
SURVEYED DATE : N/A
DATUM
VERTICAL N/A
HORIZONTAL N/A

TOWN LINE -----  
 COUNTY LINE =====

	DIRECTOR OF PROJECT DELIVERY
	APPROVED: <u>[Signature]</u> DATE <u>5/17/2016</u>
	PROJECT MANAGER : PATRICIA COBURN, P. E.
	PROJECT NAME : STATEWIDE-NORTHEAST PROJECT NUMBER : STPG SIGN(56)
SHEET 1 OF 168 SHEETS	